



23

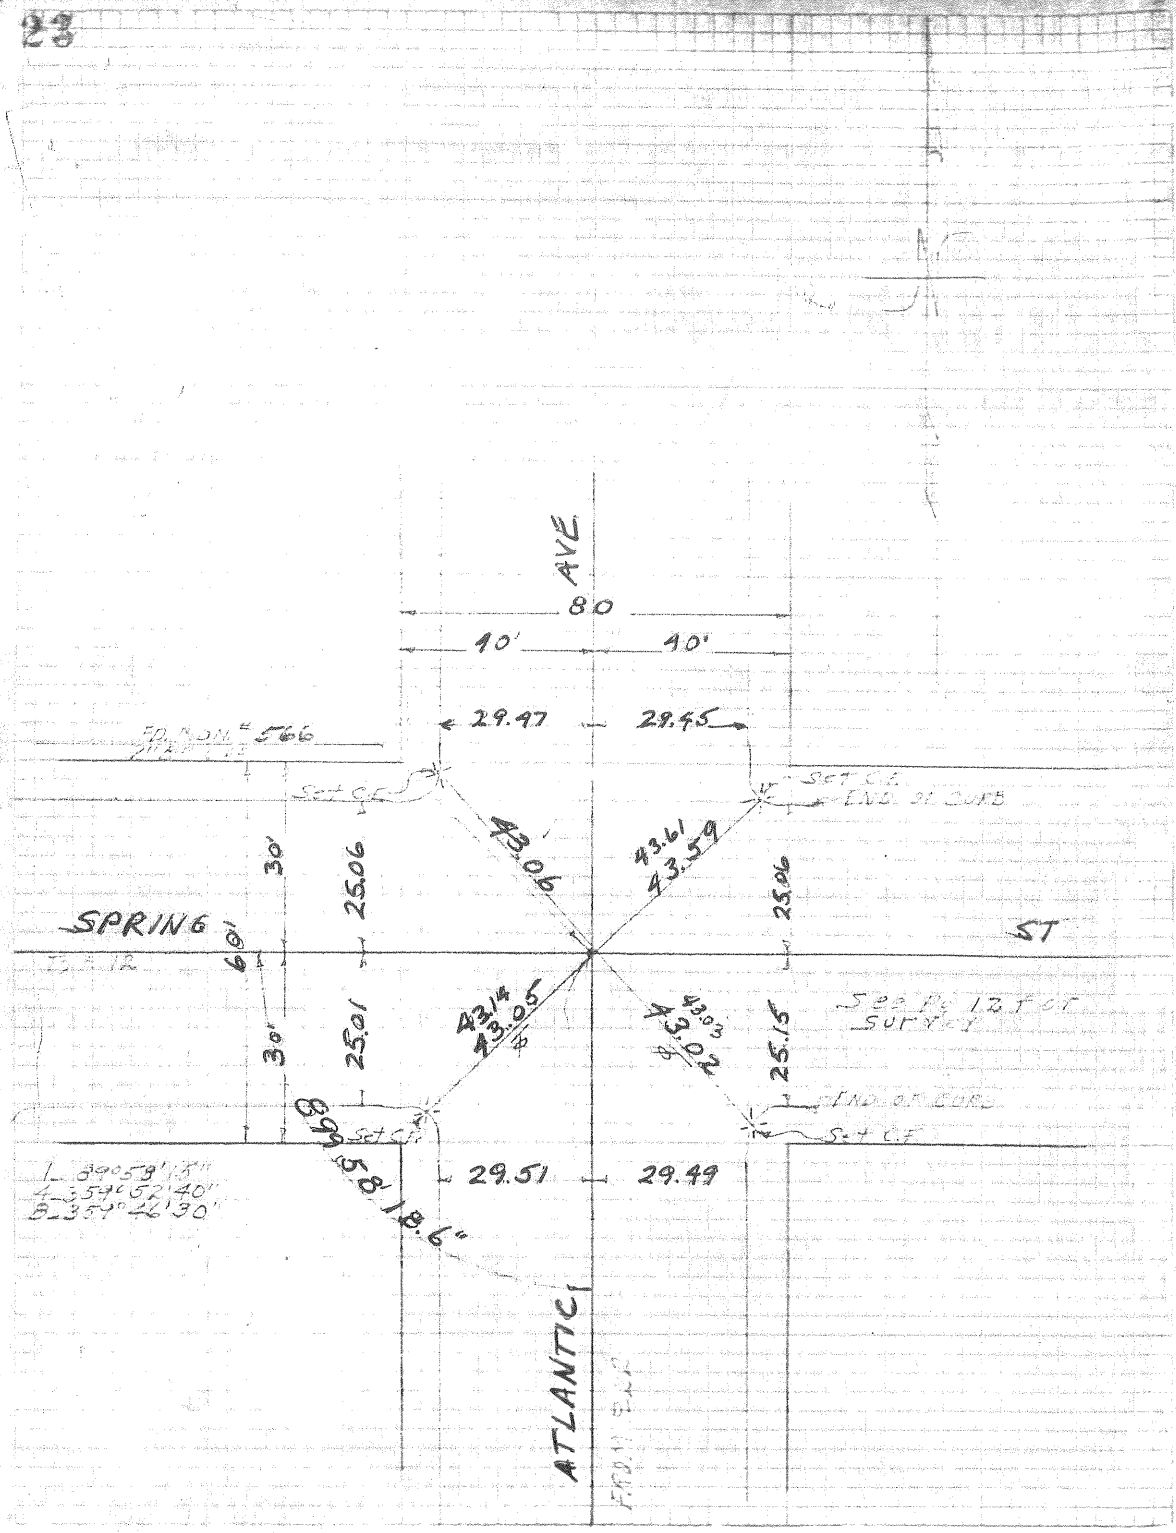

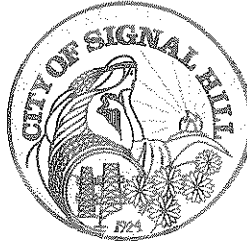

CITY OF SIGNAL HILL

2175 Cherry Avenue Signal Hill, California 90806 · (310) 989-7300 FAX (310) 989-7393/7391

SURVEY OF G HILL ST. F B NO. PAGE
SURVEY BY R.V. PEARSALL INC. PM. 14912
DATE 1-26-82

SURVEYORS SERVICE COMPANY
ISTA MESA - STOCK NO. 411


DO NOT EXTEND NOTES THIS SIDE OF LINE

OHIO AVE.

NO SCALE


P.M. 14912


TEMPLE AVE

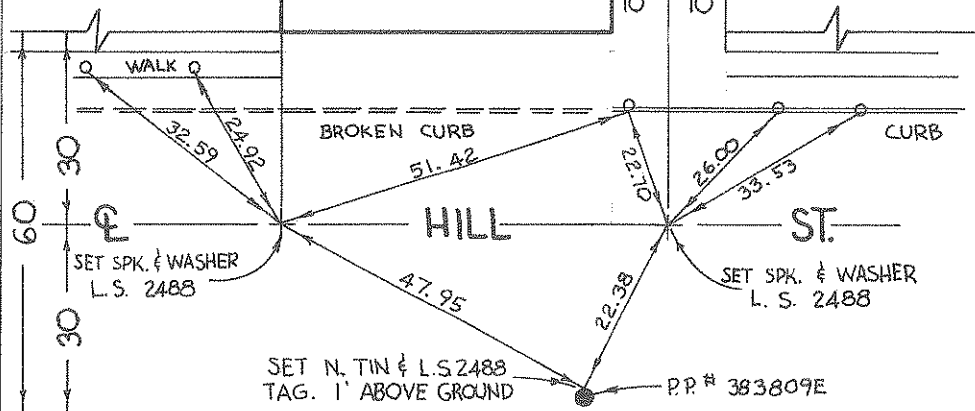



NOTE
○ = A SET LEAD & TACK


19

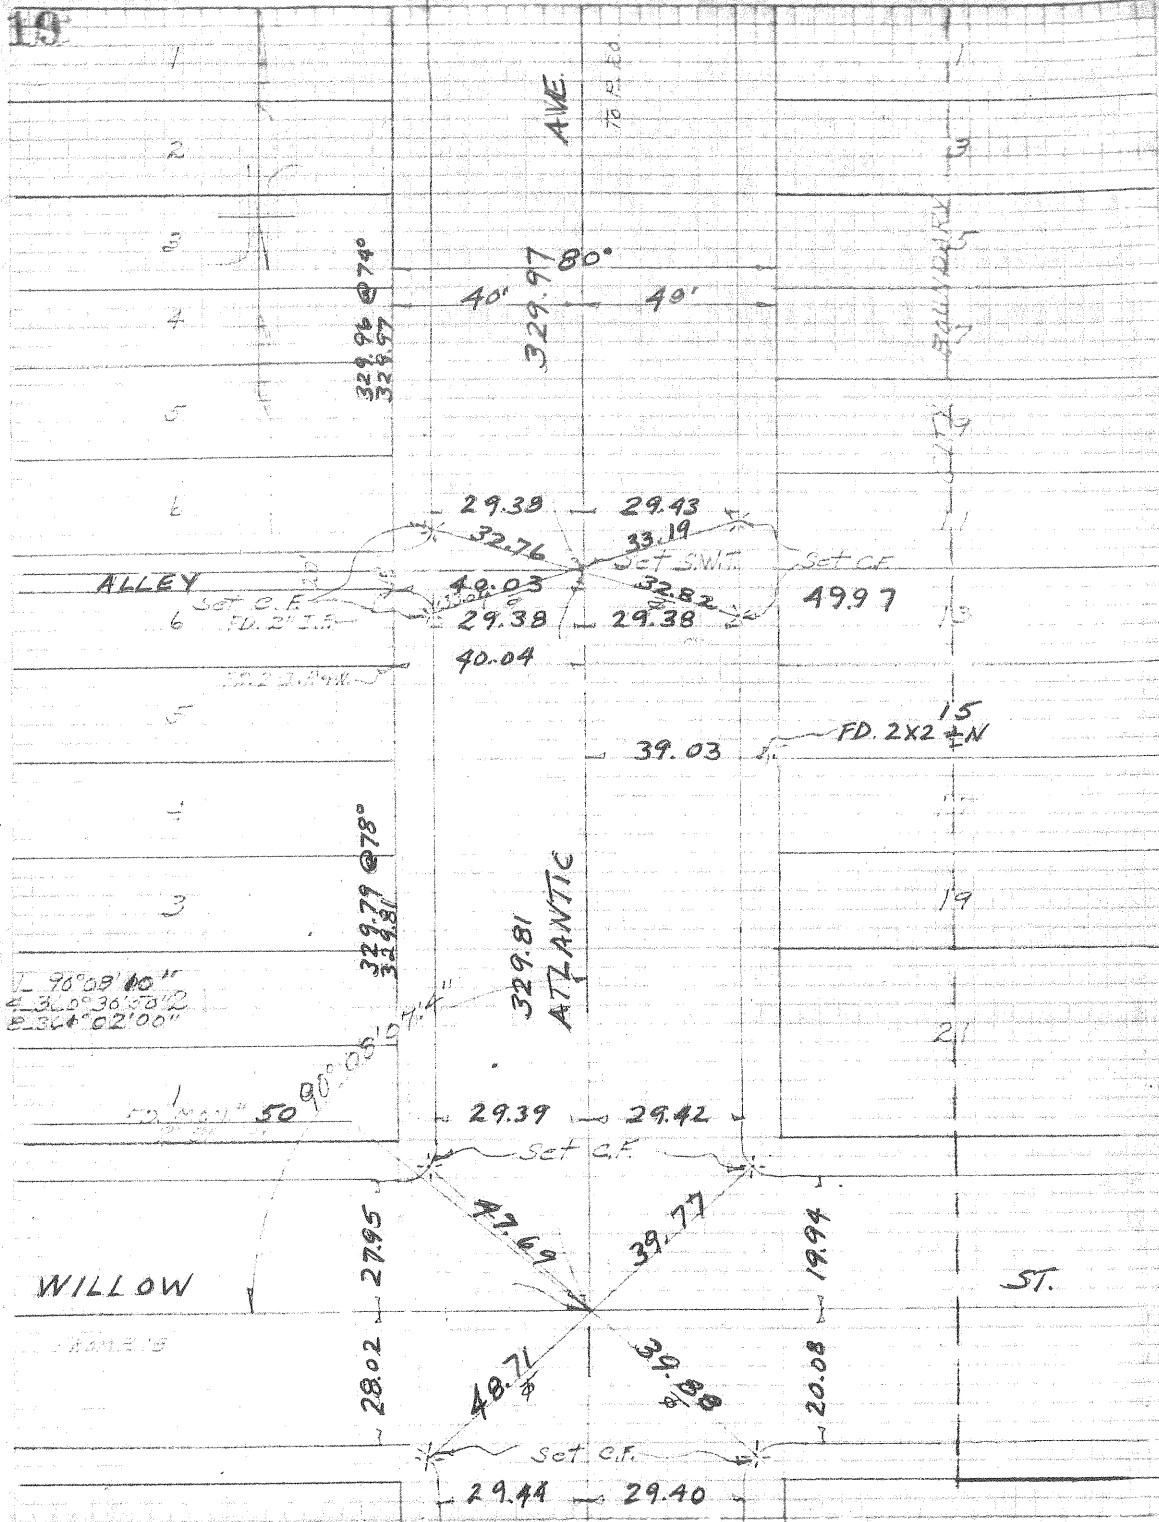

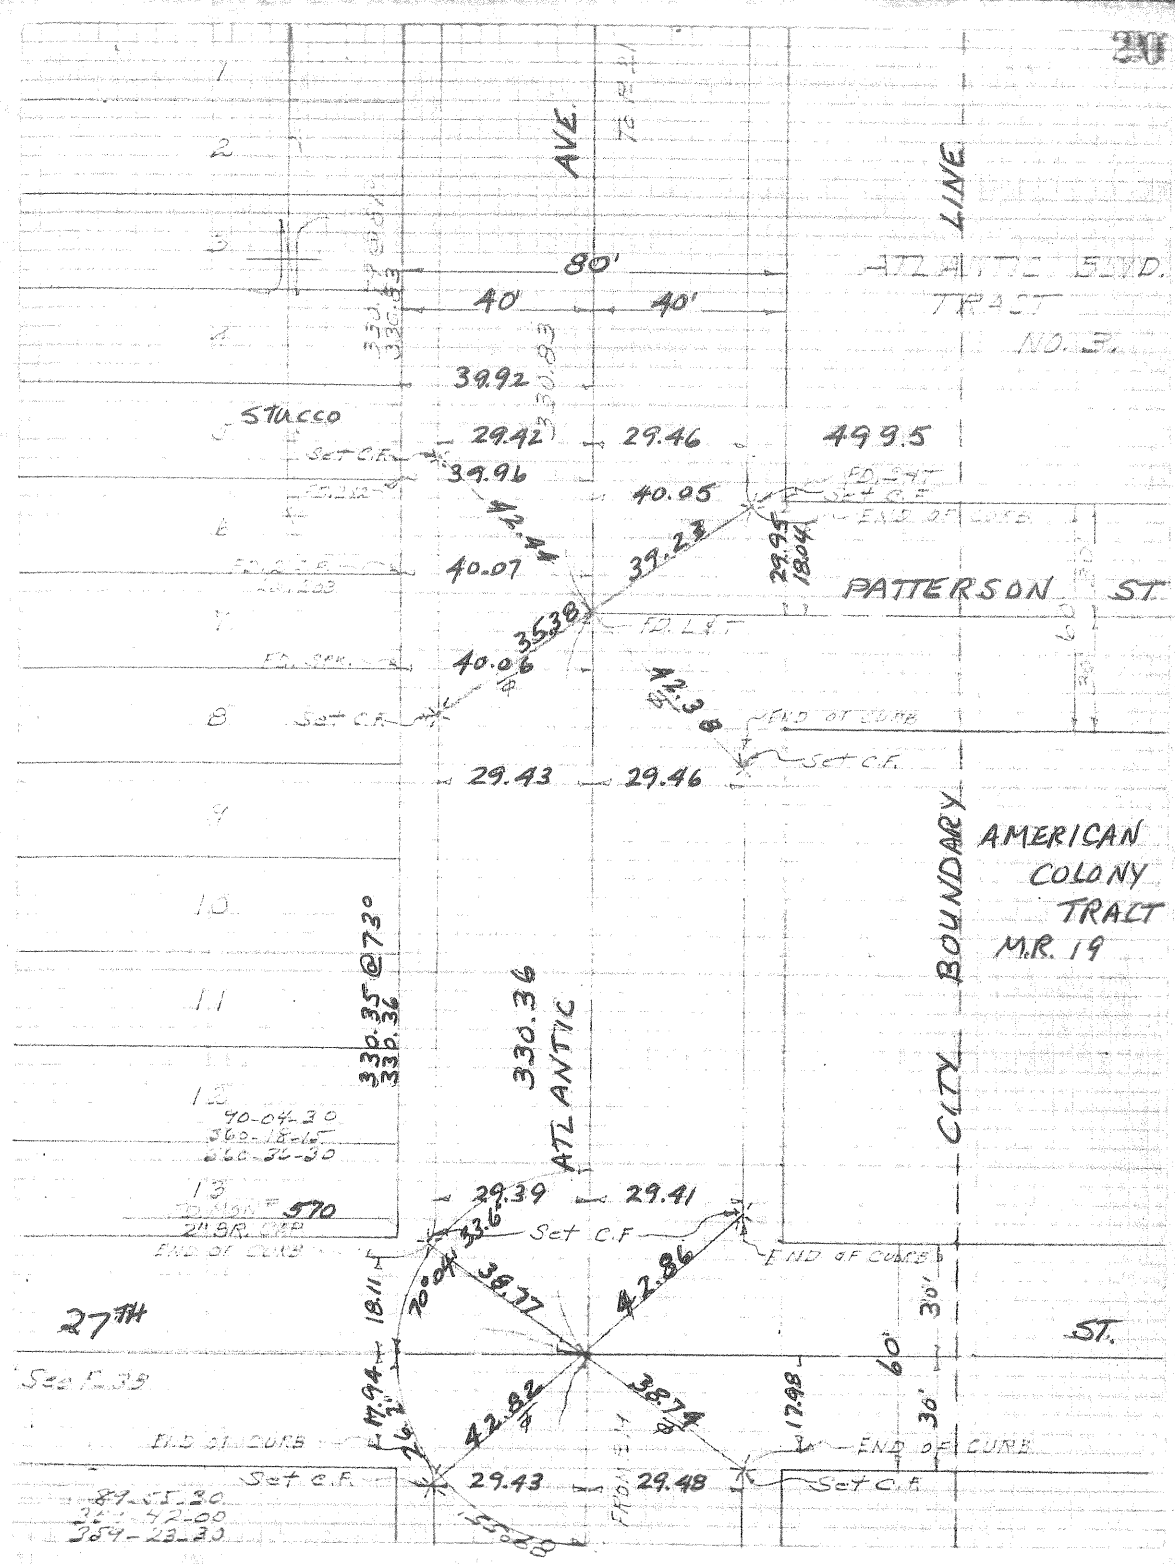


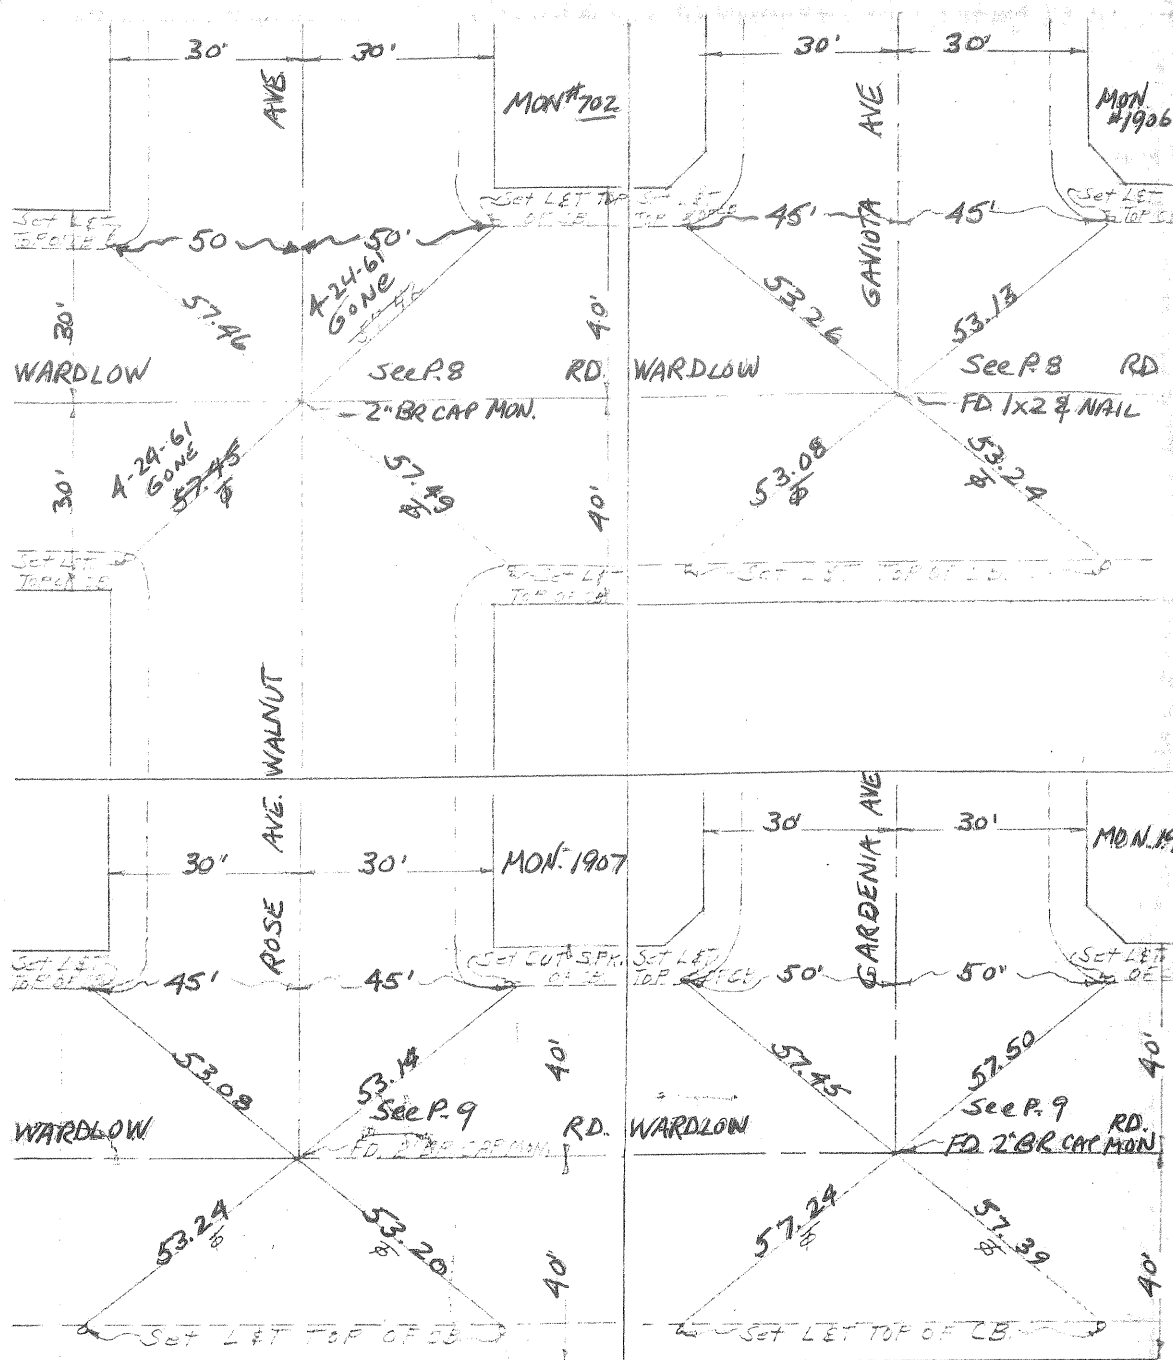


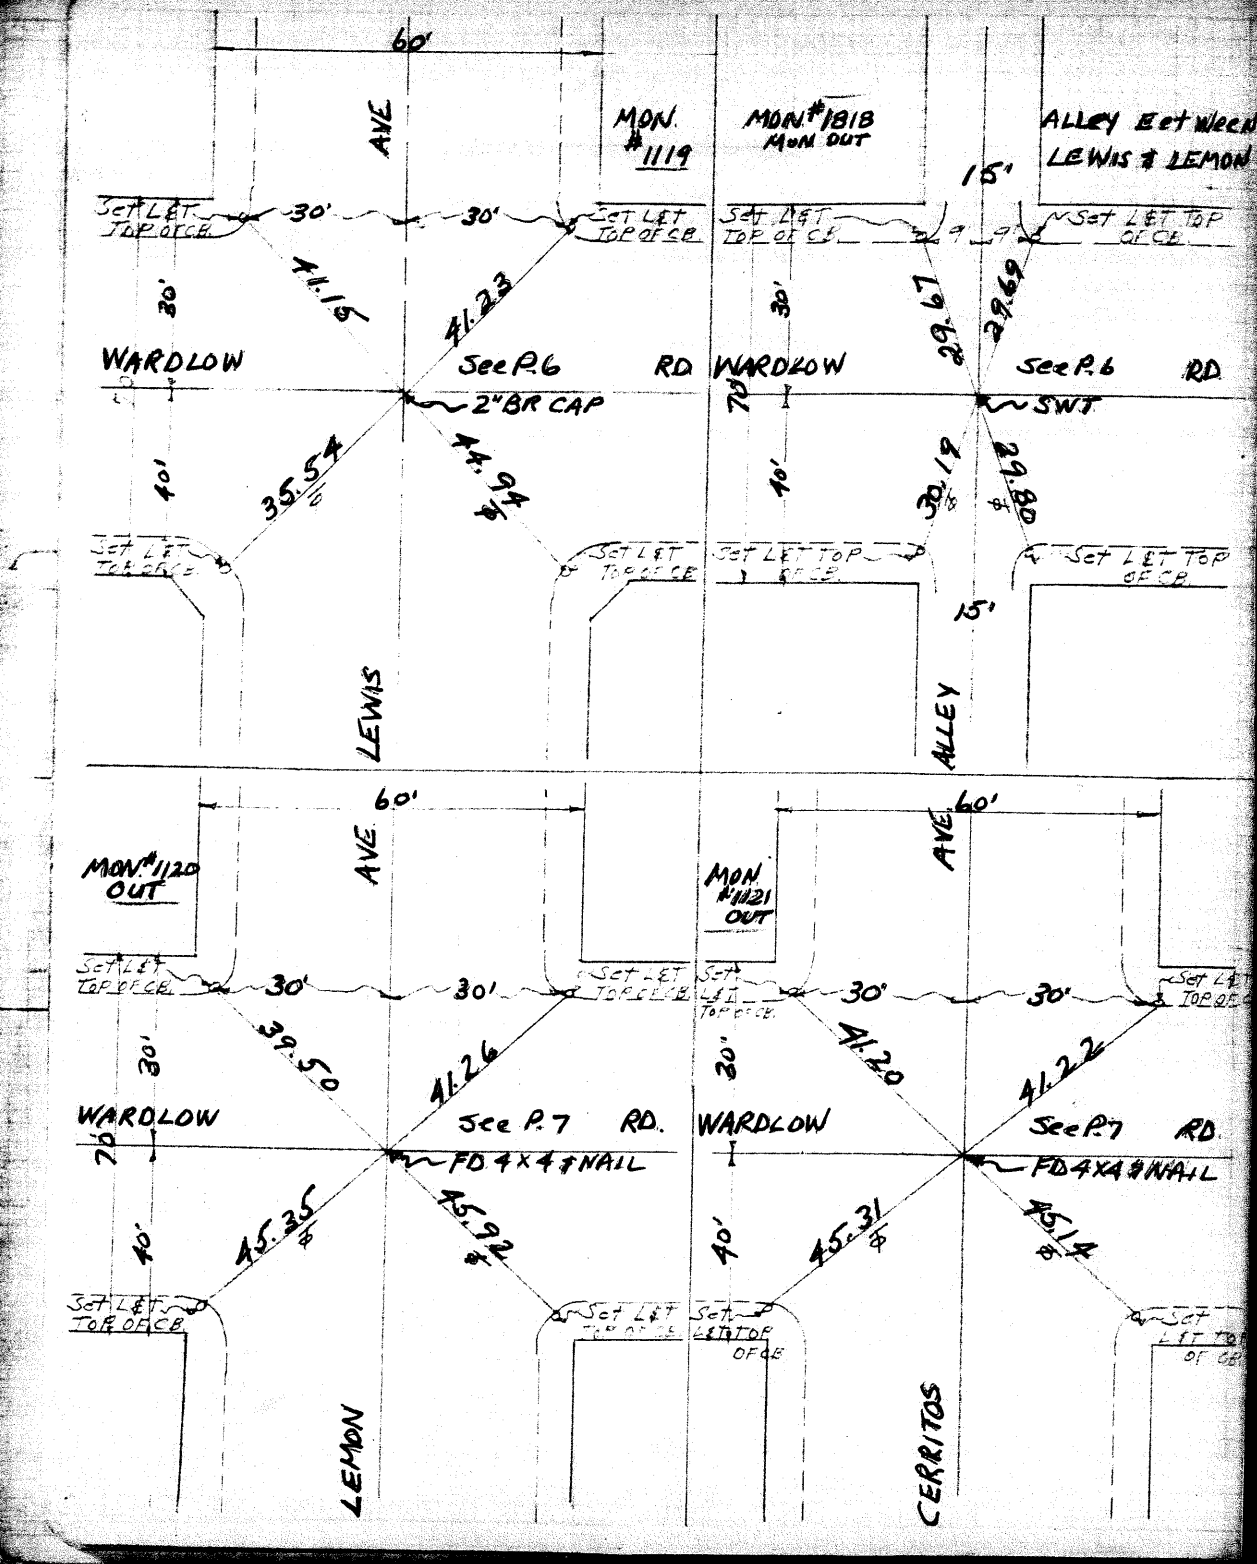

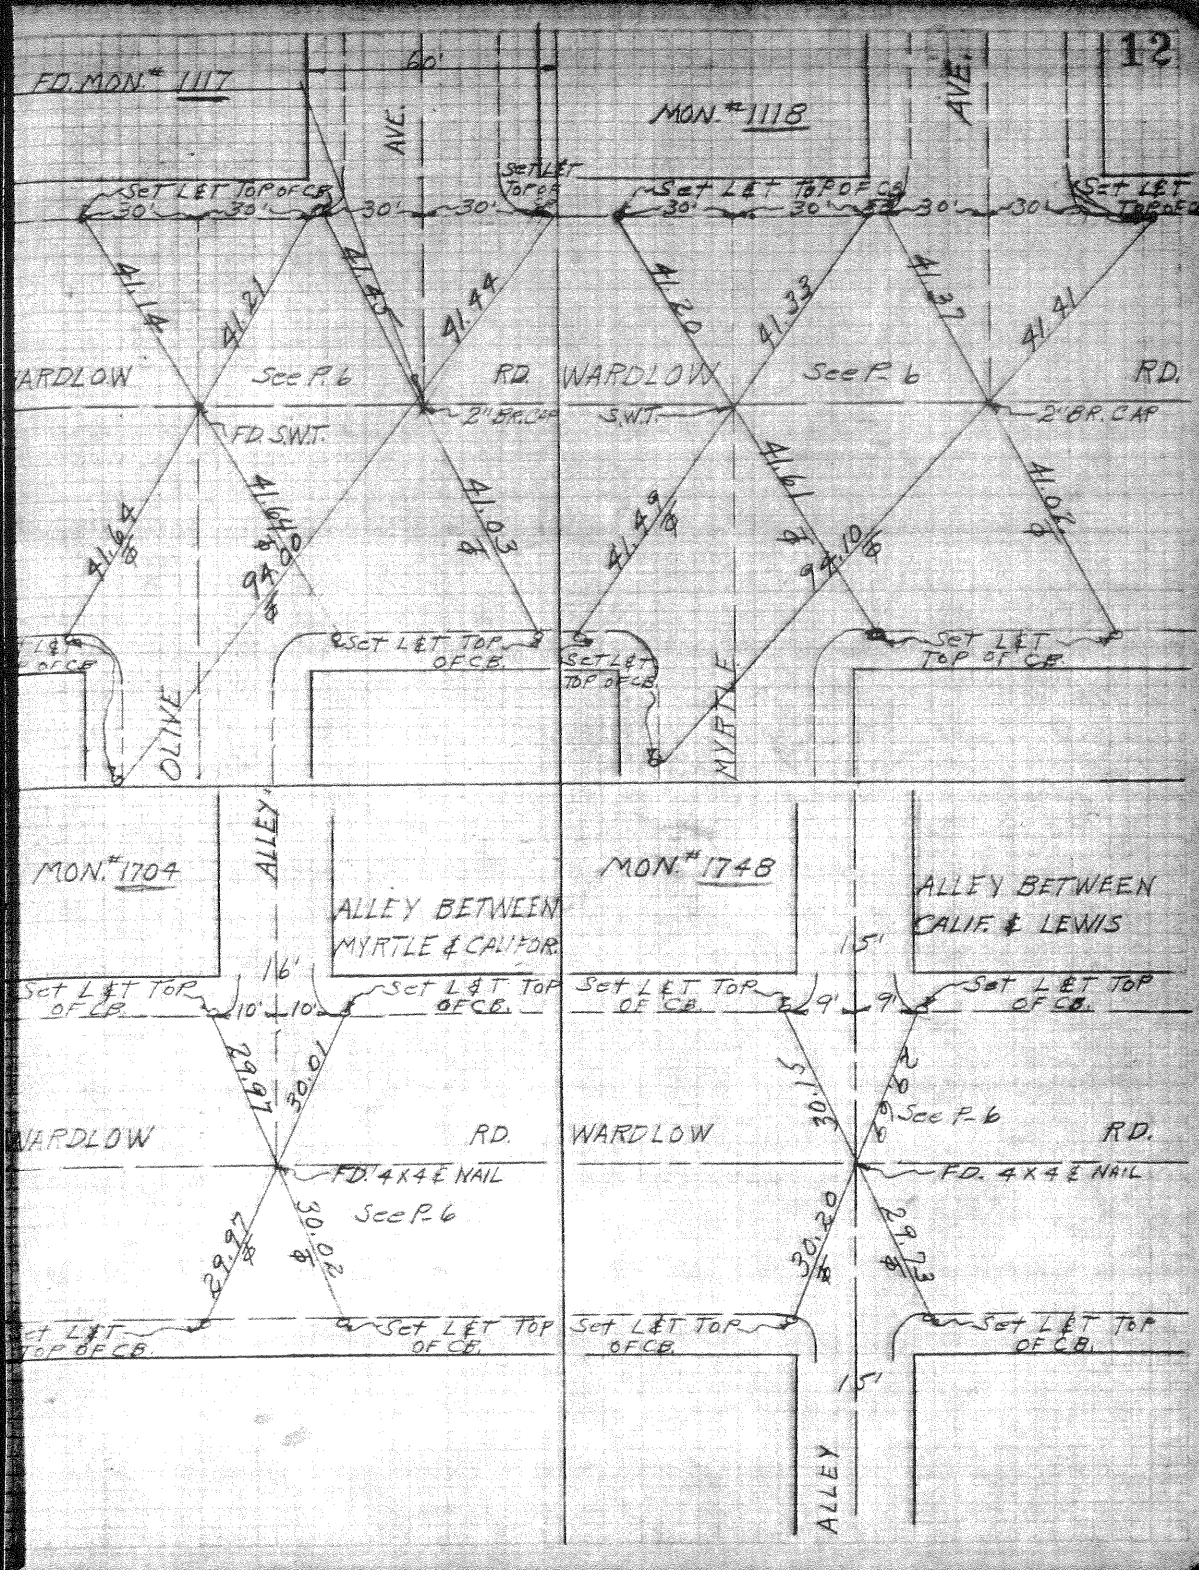



MON. ¹¹2256


ALLEY BETWEEN LINDEN SO. & ATLANTIC

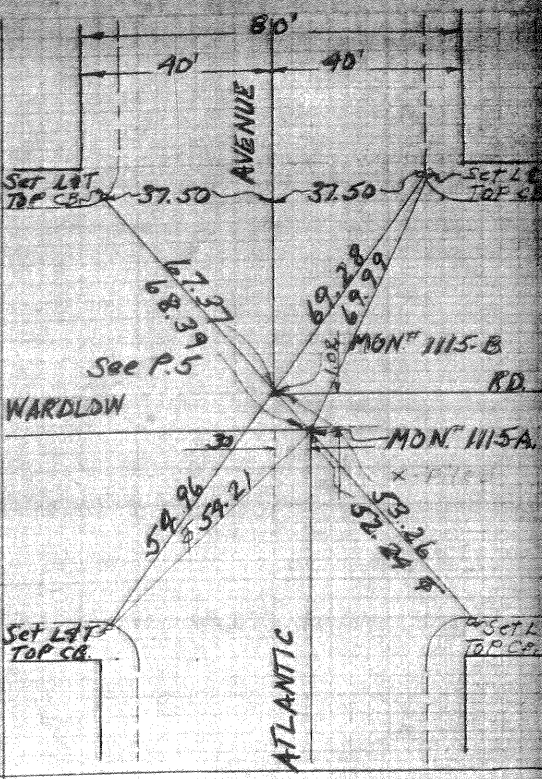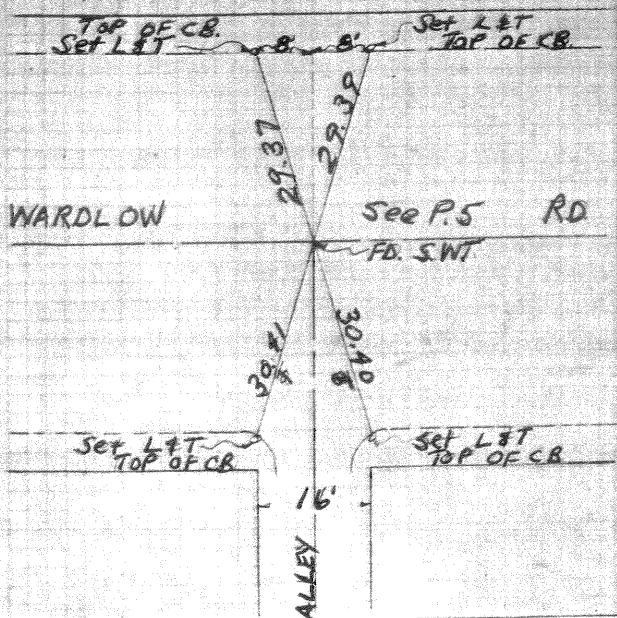

MON#1699

ALLEY BETWEEN
LIME & MYRTLE
- Olive

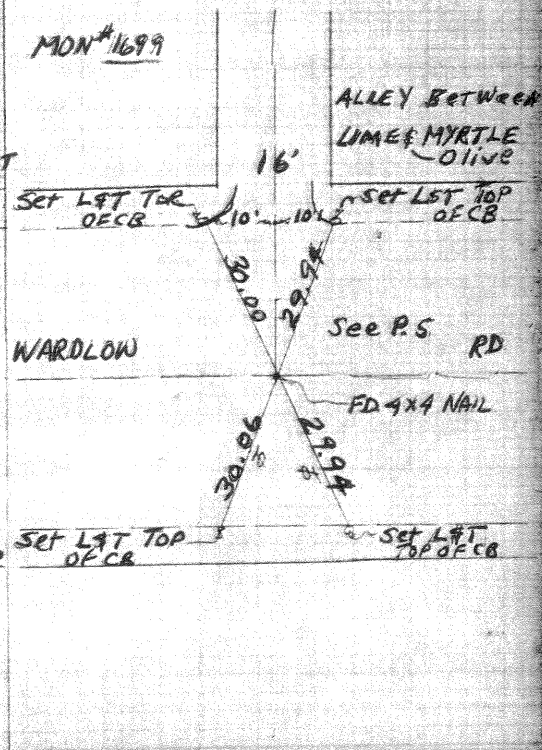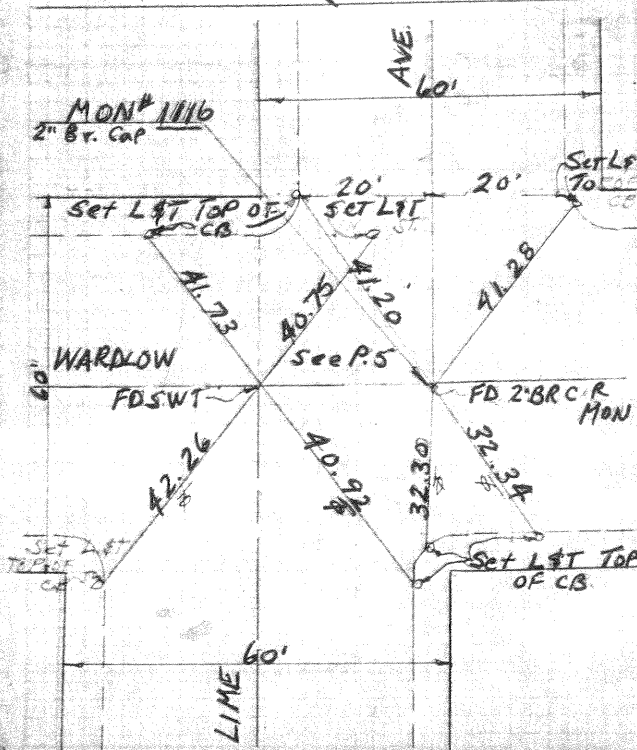

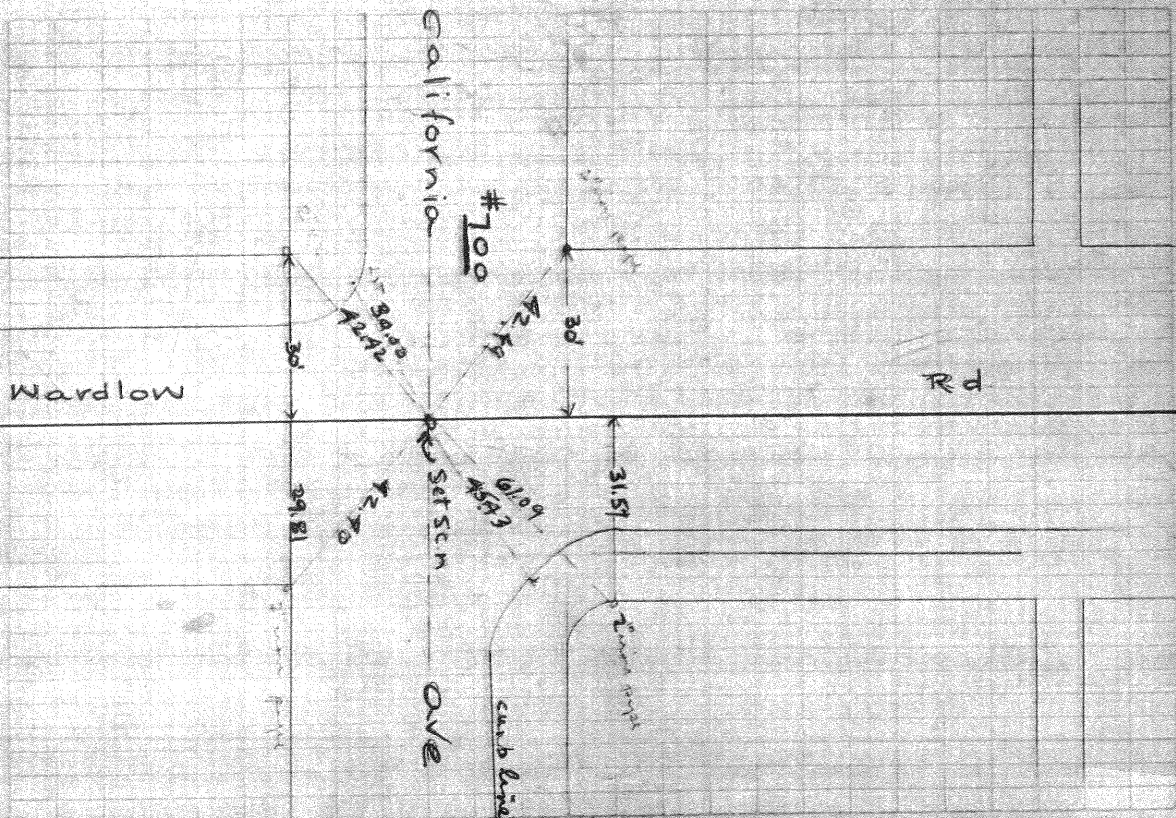

Monument No 144

Ties	Angle	Distance
144-145	90° 00' 00"	
A	45° 02' 00"	42.45'
B	223° 00' 00"	36.32'
C	244° 18' 00"	45.52'
D	311° 25' 00"	39.44'
E	315° 02' 00"	42.39'


Schmidt's Notes
Part Gardner's chain
More

Description

- A cross on 3' Iron cap set in concrete (by M.V.)
- B Point in center of Valve on top
- C Set in NW side of B.W. 18" # 93223E
- D Set in NE side of Telephone Pole # 144520
- E cross on 3' Iron cap set in concrete (by M.V.)


July 1924

19

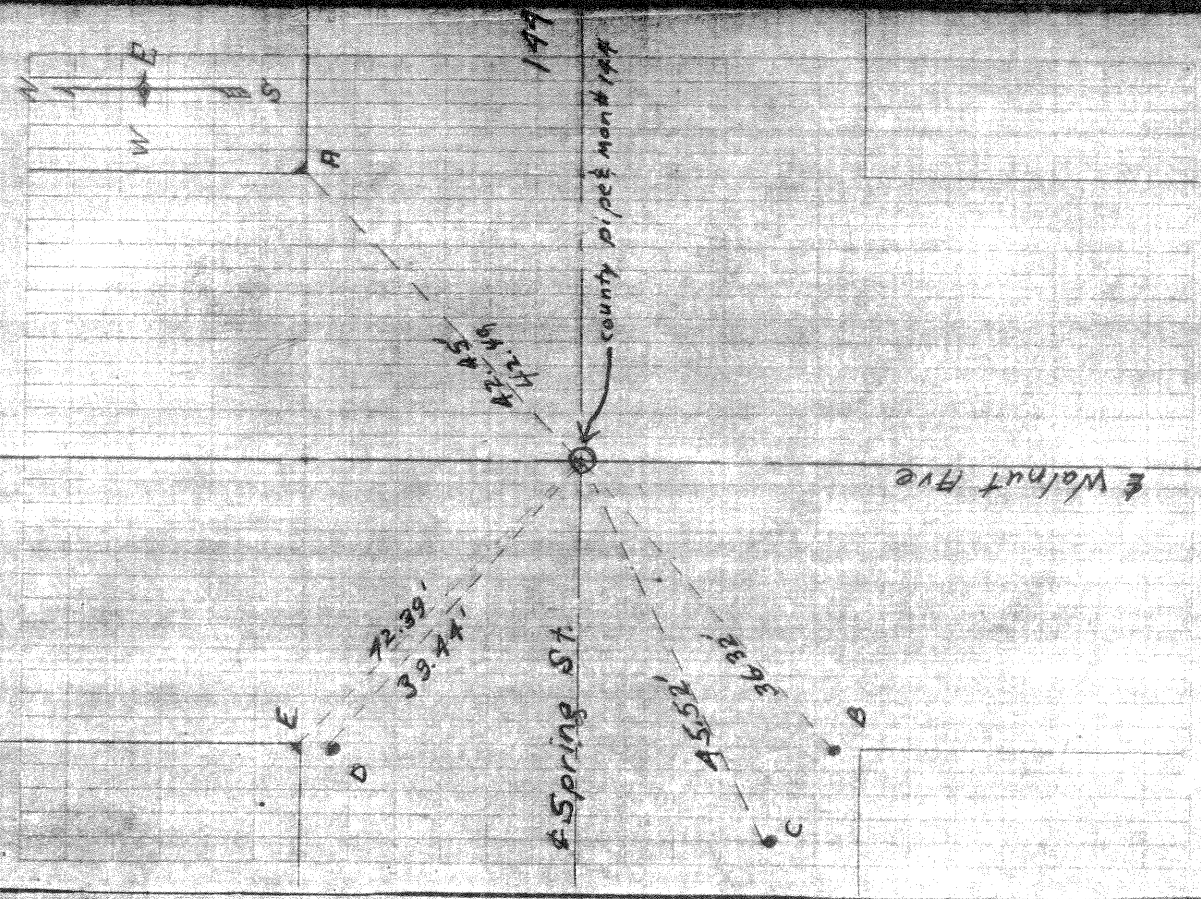


Monument No. 143


Ties	Angle	Distance	Party	Description
#143 - B ²	180°00'00"			
A	44°52'00"	42.40'	Schmidt's Notes Gardens Here	3" Iron cap set in concrete (by Mix)
B	128°42'00"	27.41'		Cross on SW side of 6" Iron pipe
C	143°05'00"	35.57'		Cross is about 2' above ground
D	224°57'00"	42.45'		Cross on SW side of 6" Iron Pipe 2' above ground
E	238°04'00"	38.35'		3" Iron cap set in concrete (by Mix)
F	307°04'00"	44.00'		S & T in SE side of Power Pole #93215F
G	319°56'00"	42.41'		S & T in NE side of Telephone Pole
				3" Iron cap set in concrete (by Mix)

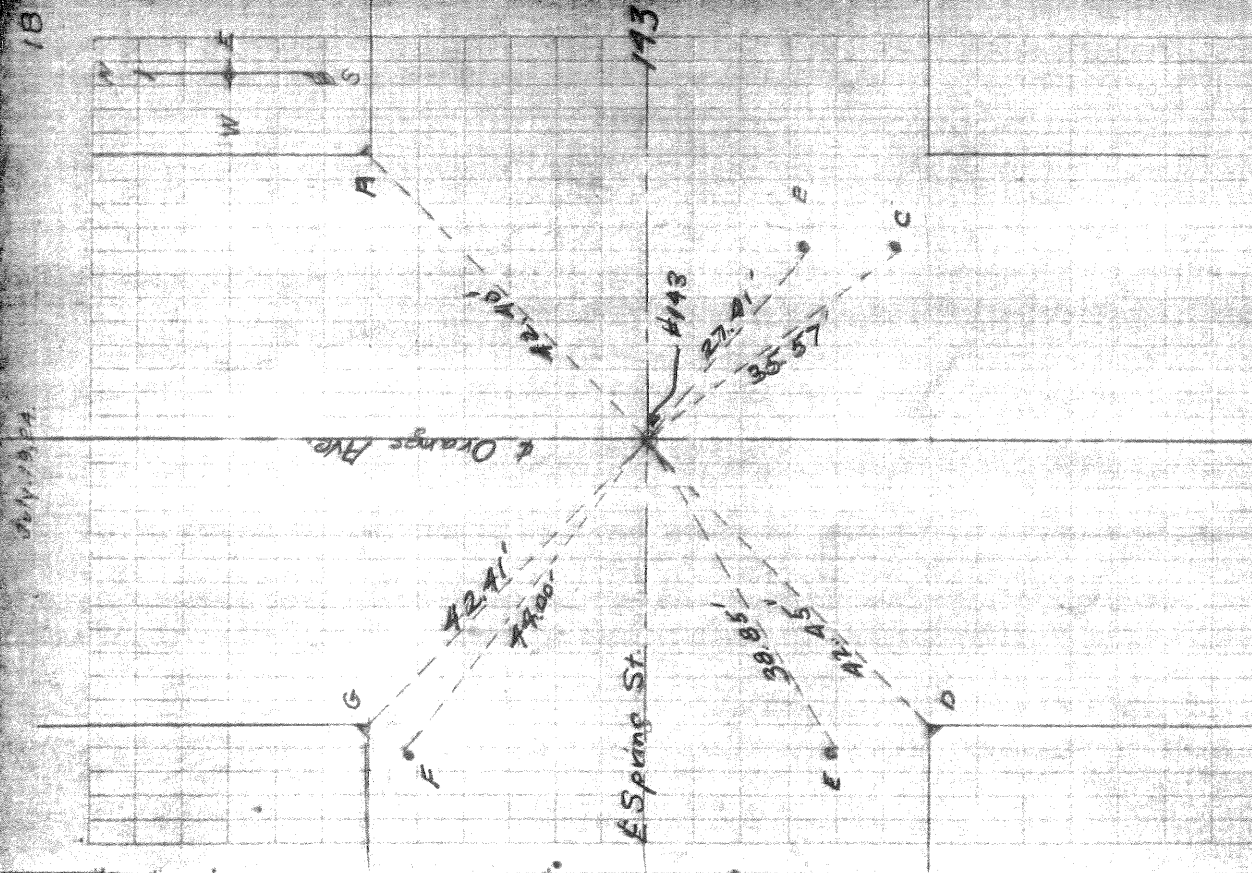

C.L.B.F.B. X 914 E. 77

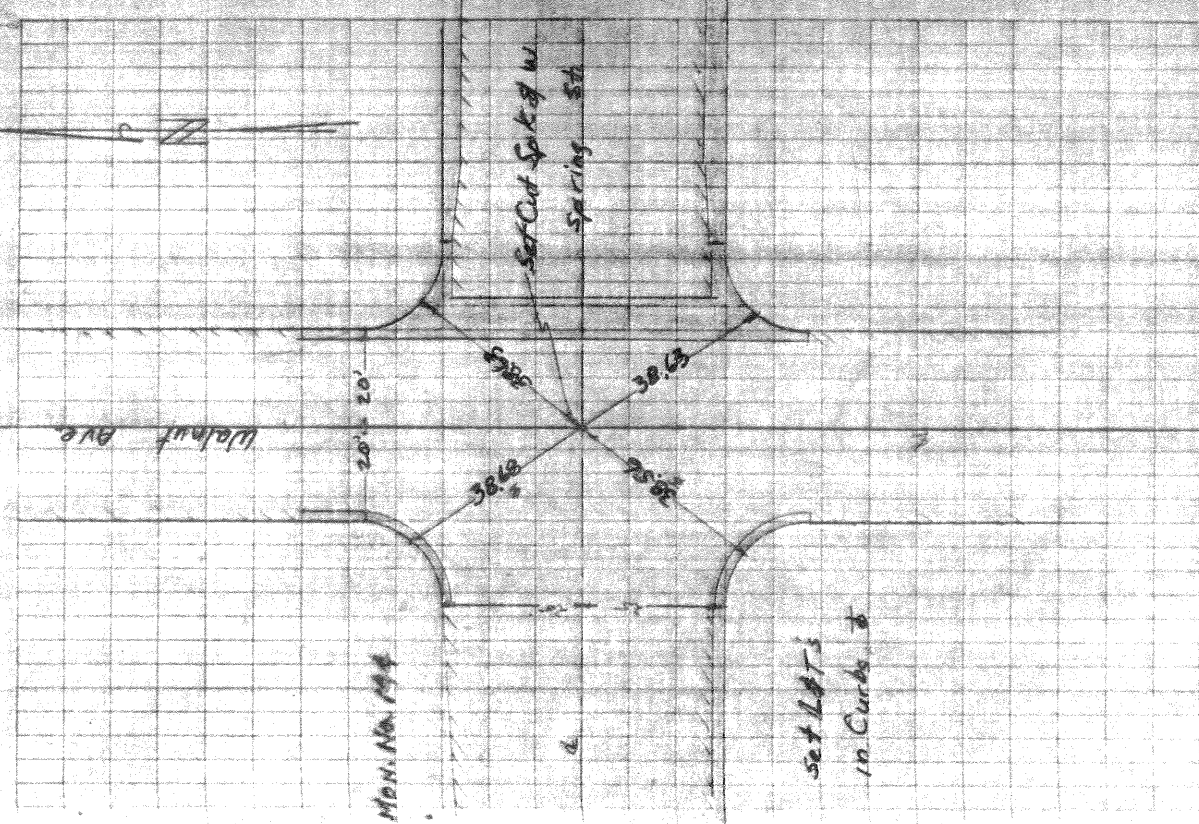

C.L.B.F.B. X 914 E. 77

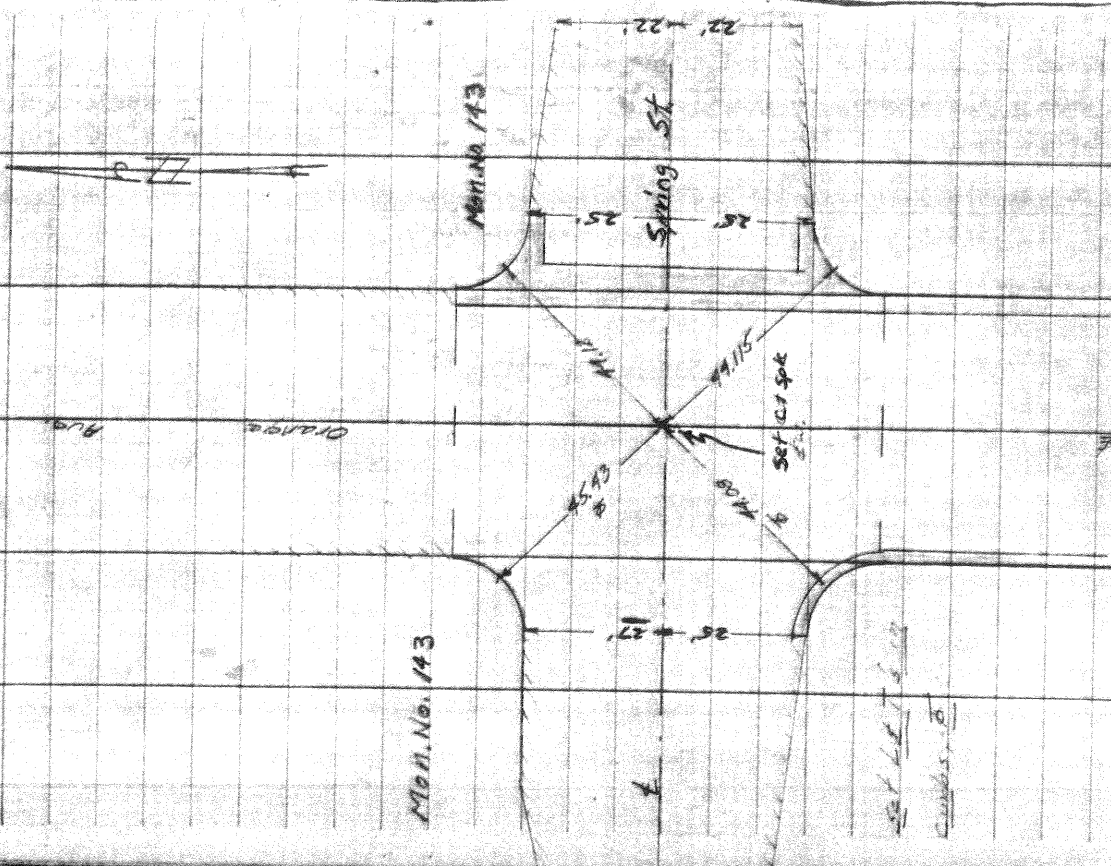

Mon. No. 143

Set Out Sp. & w. Spring St



CITY OF SIGNAL HILL


2175 Cherry Avenue Signal Hill, California 90806 (310) 989-7300 FAX (310) 989-7393/7391

CO ENG FB 3654 - 41
Gardena Avenue south of
SURVEY OF 29th Street F B NO. PAGE
SURVEY BY Joseph M. Phelps TRACT NO. Parcel Map 13498
DATE April 22, 1981 "RCE 7964" City of Signal Hill
County of Los Angeles

(NO SCALE)

SURVEYORS SERVICE COMPANY STA MESA - STOCK NO. 411

DO NOT EXTEND NOTES THIS SIDE OF LINE

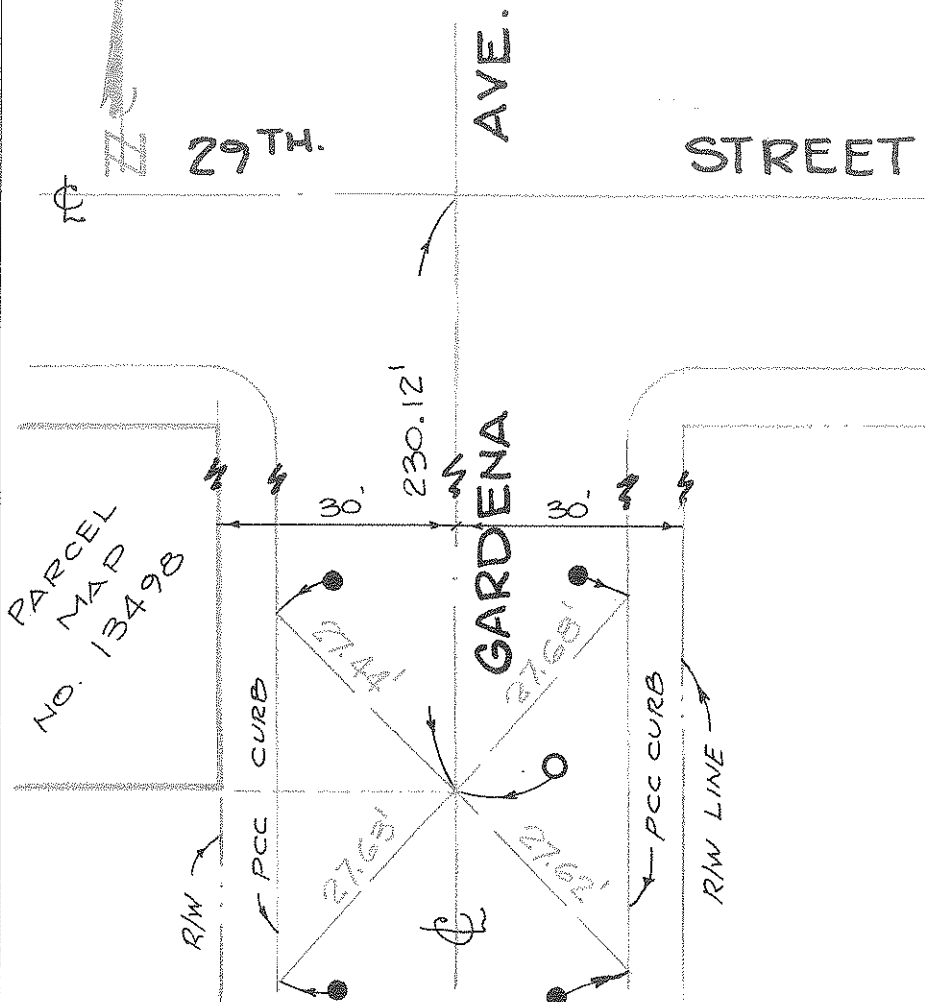

● Set Lead and Tack.

○ Set Spike & Washer stamped "RCE 7964".




CITY OF SIGNAL HILL

2175 Cherry Avenue · Signal Hill, California 90806 (310) 989-7300 FAX (310) 989-7393/7391

29

CO. ENG. FB 3654 - 39

29th Street west of
 SURVEY OF Gardena Avenue F B NO. PAGE
 SURVEY BY Joseph M. Phelps TRACT NO. Parcel Map 13498
 DATE April 22, 1981 "RCE 7964" City of Signal Hill
 County of Los Angeles

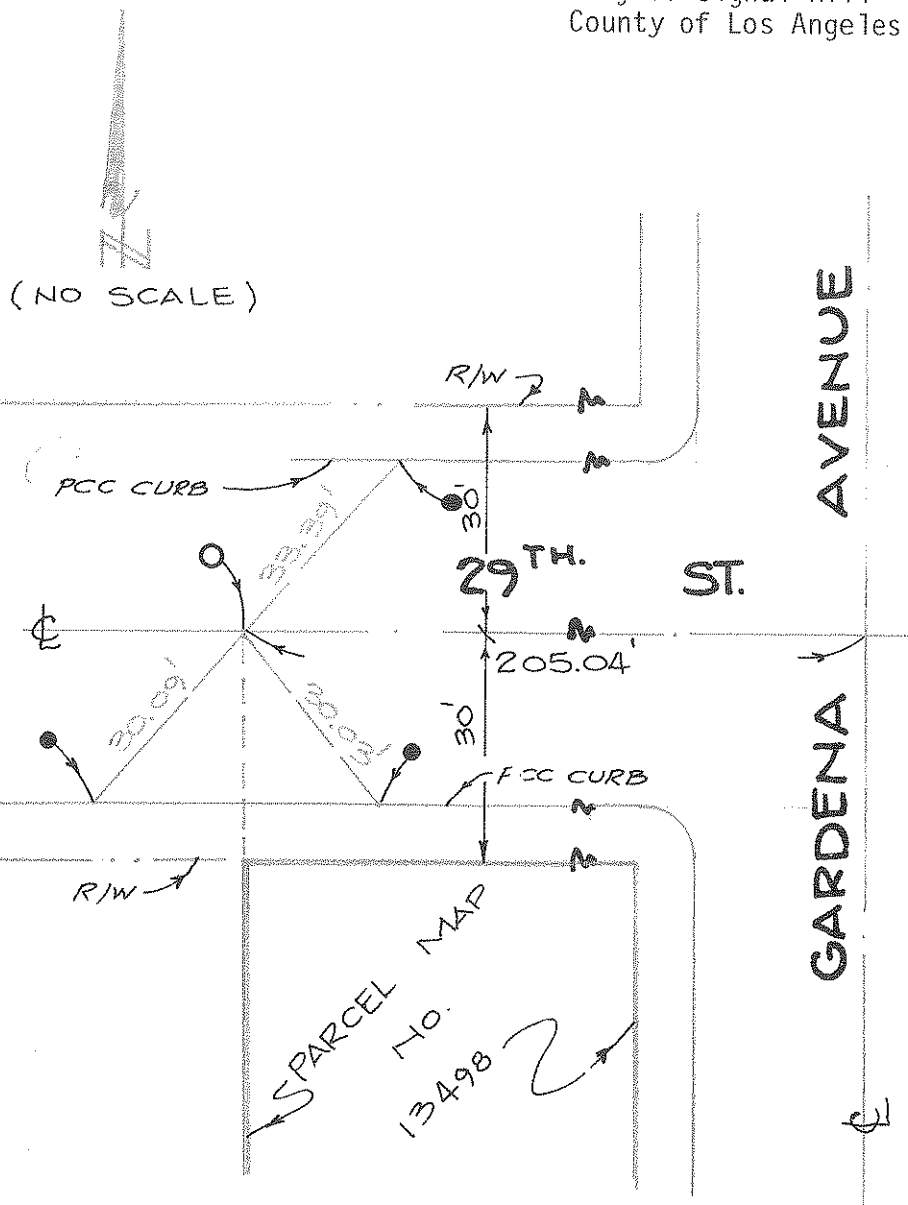

DO NOT EXTEND NOTES THIS SIDE OF LINE

SURVEYORS SERVICE COMPANY 3TA MESA - STOCK NO. 411

- Set Spike & Washer stamped "RCE 7964".
- Set Lead and Tack.

Alignment No 149


Ties	Angle	Distance
#149-150	270°00'00"	
A	45°00'00"	42.43'
B	180°00'00"	29.59'
C	270°00'00"	29.58'
D	315°00'00"	42.43'

Party { Schmitt, F. Notes
Sweeney, Chain

Description

- A Redwood 4x4 hub set by us. (by Mix)
- B Cross on 3" Iron cap set in concrete
- C Cross on 3" Iron cap set in concrete (by Mix)
- D Redwood 4x4' hub set by us

July 22, 24

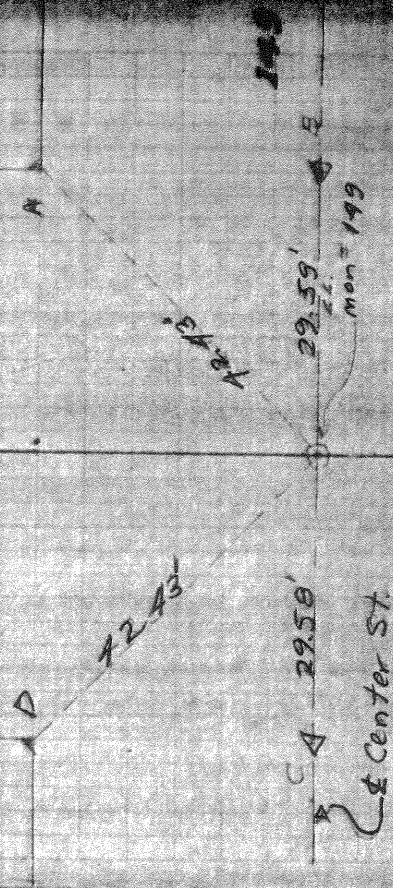

149


Monument No. 150


Ties	Angle	Distance
150-149	90°00'00"	
A	44°56'00"	74.95'
B	45°00'00"	42.43'
C	219°6'00"	69.59'
D	251°05'00"	45.42'
E	267°30'00"	105.80'
F	313°00'00"	42.43'

Party { Schmidt & Notes
Gardener's chair

Description

- A S & T in NW side of old square Tele Pole
- B Redwood 4x4' hub set by us.
- C S.E. cor. of corrugated Iron Bldg Pumping Station
- D cross on elbow of 8" water pipe
- E Set in N side of Power Pole No. 40284E
- F Redwood 4x4' hub set by us.

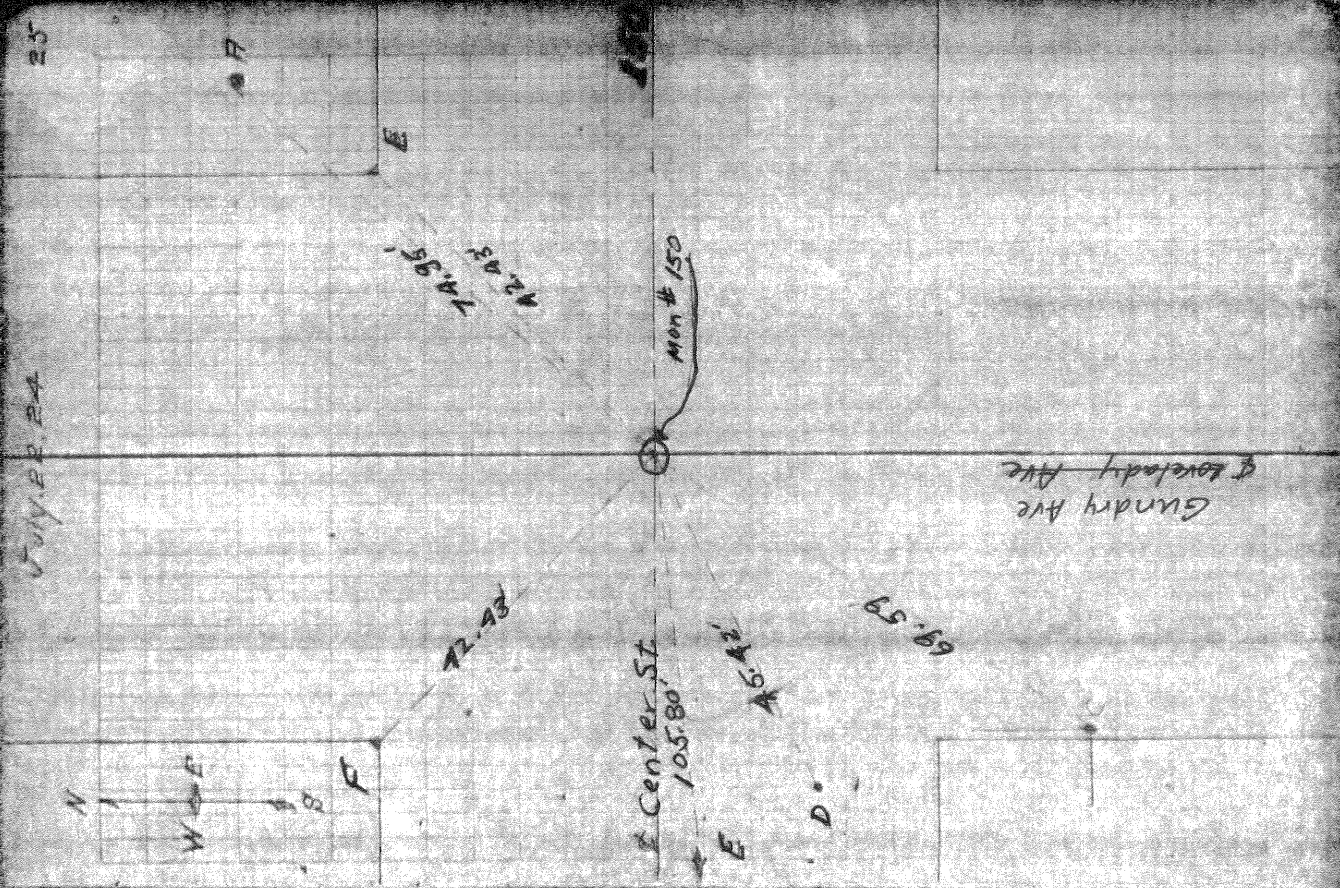

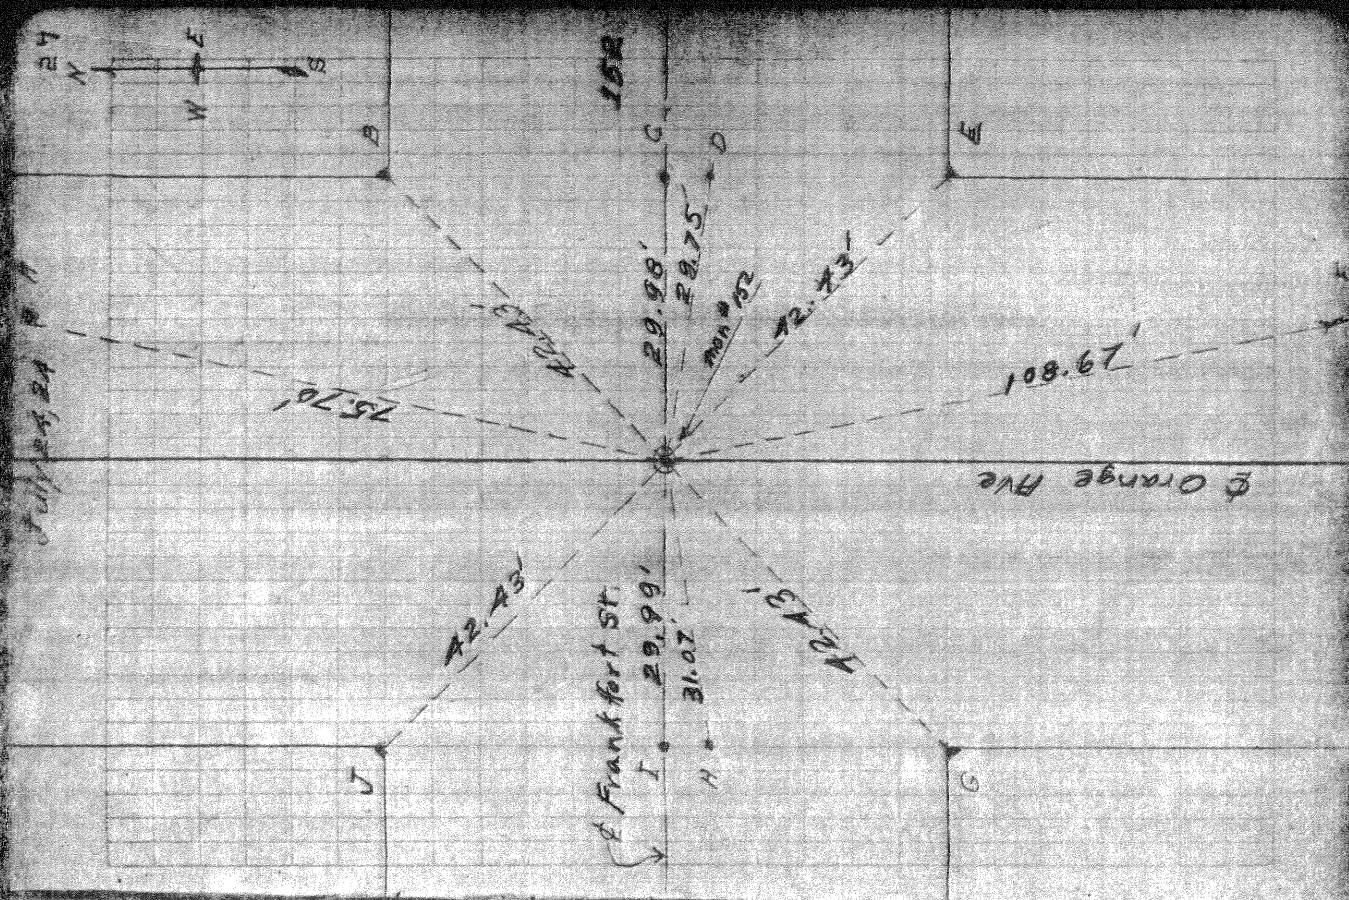

Ties	Monument	No	152	Angle	Distance	Party	Remarks
152-153				270°00'00"			
A				08°43'00"	75.70'		
B				45°00'00"	42.43'		
C				89°59'00"	29.98'		
D				99°38'00"	29.75'		
E				135°00'00"	42.43'		
F				173°00'00"	108.67'		
G				225°00'00"	42.43'		
H				265°56'00"	31.07'		
I				270°00'00"	29.99'		
J				315°00'00"	42.43'		
~~~~~							
A	S. & T. in NW. side of Bwerle 39601 E						
B	Redwood 4"x4" hub set by us						
C	cross in 3" cap set in concrete (by M.A.)						
D	2"x2" hub with tack (set by Shell Co.)						
E	Redwood 4"x4" hub set by us						
F	S & T set in NE. side of Bwerle 39600 E						
G	cross on 1" Iron Pin 12" long. set by us						
H	2"x2" hub with tack (set by Shell Co.)						
I	cross in 3" Iron cap set in concrete (by M.A.)						
J	Redwood 4"x4" hub set by us						
~~~~~							
We find that Bwerle 39603 W and 39605 S of our point for S.C.M. 18. Ties 152-153 W.							

Schmidt - T. Notes
Gardener's chain
here

Schmidt - N. Niles
Gardener's chain
here


Party

SURVEYED BY MADIGAL WASHICKO

DATE 11/2/93

C/K TIES @ WALWUT
9 29TH

ROBERT BEIN, WILLIAM FROST & ASSOCIATES
PROFESSIONAL ENGINEERS, PLANNERS & SURVEYORS
1735 ALTON PARKWAY AVENUE CA 92019-5001 • U.S. BANK 57057 AVENUE CA 92019-1057
714 412-5501 • FAX 714-412-6373

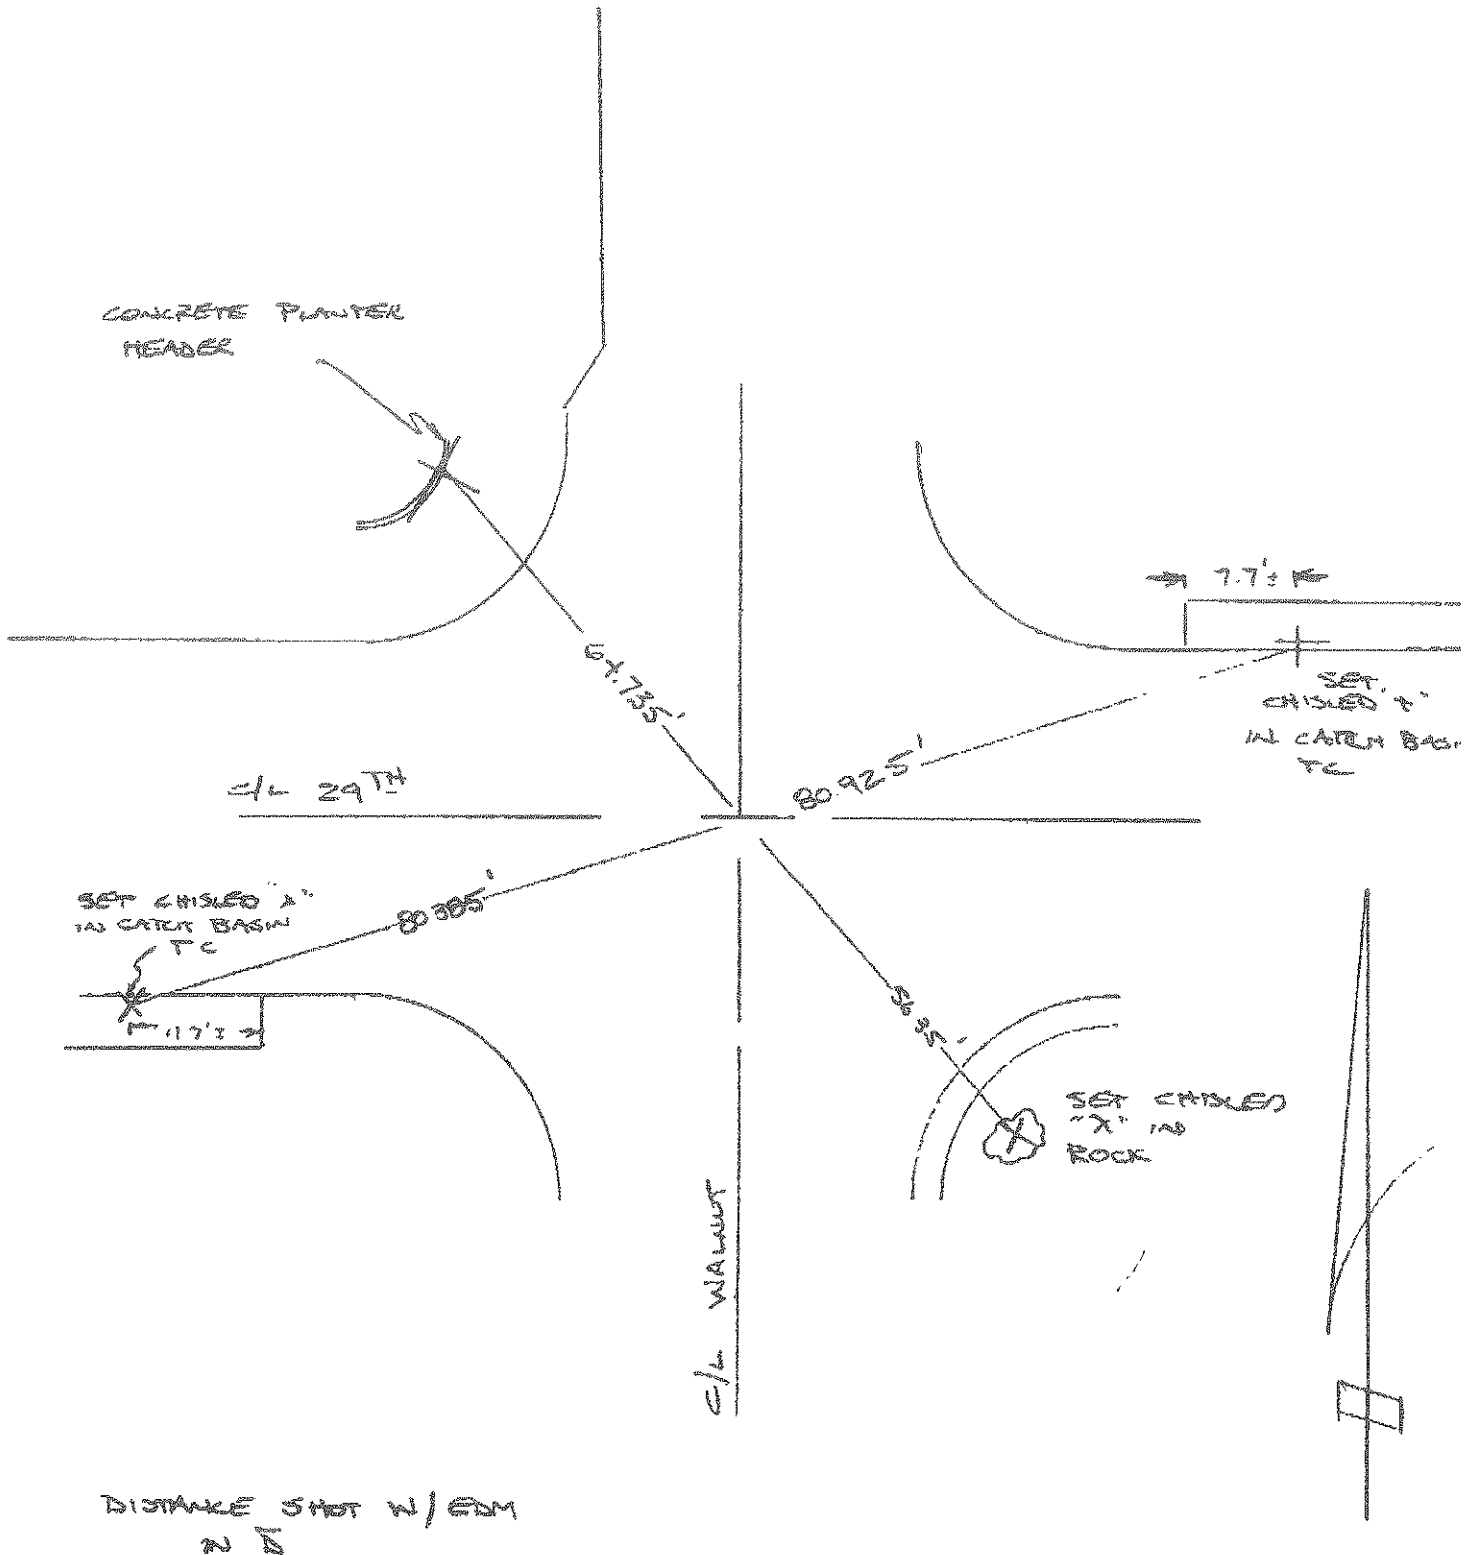


SURVEYED BY MADIGAN WASHICKO

DATE 11/2/98

C/L TIES @

WALNUT @ 28TH

ROBERT BEIN, WILLIAM FROST & ASSOCIATES
PROFESSIONAL ENGINEERS, PLANNERS & SURVEYORS
14725 ALTON PARKWAY IRVINE, CA 92618-2000 • P.O. BOX 57057 IRVINE, CA 92616-0557
TEL 949 451-1100 • FAX 949 451-0315

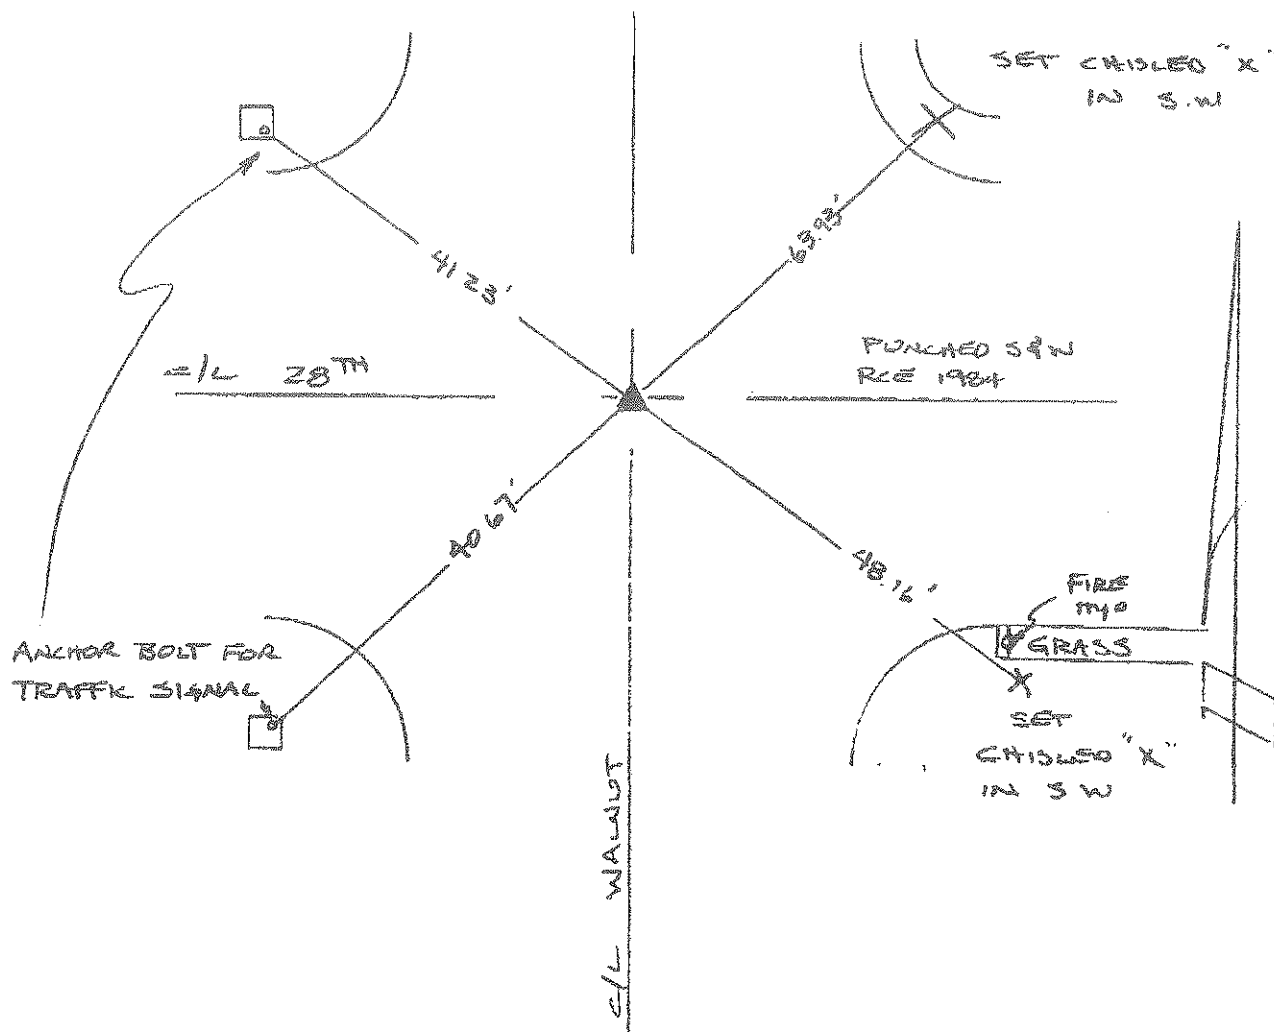

2175 Cherry Avenue • Signal Hill, California 90806 • (310) 989-7300 • FAX (310) 989-7393/7391

SURVEY OF GUNDRYE 2911
SURVEY BY PFEILER & ASSOC
DATE 4-30-83 WFO/JOE

F. B. _____ PG. _____

TR. NO.

30. CALIF. BLUE PRINT CO. -

334 1210

STRECH

5/20/20

~~44.30~~

GUNDRY

29th




16 110 SCALE


LAUNCH PRNG

File 60

CLIFF X 914 M54

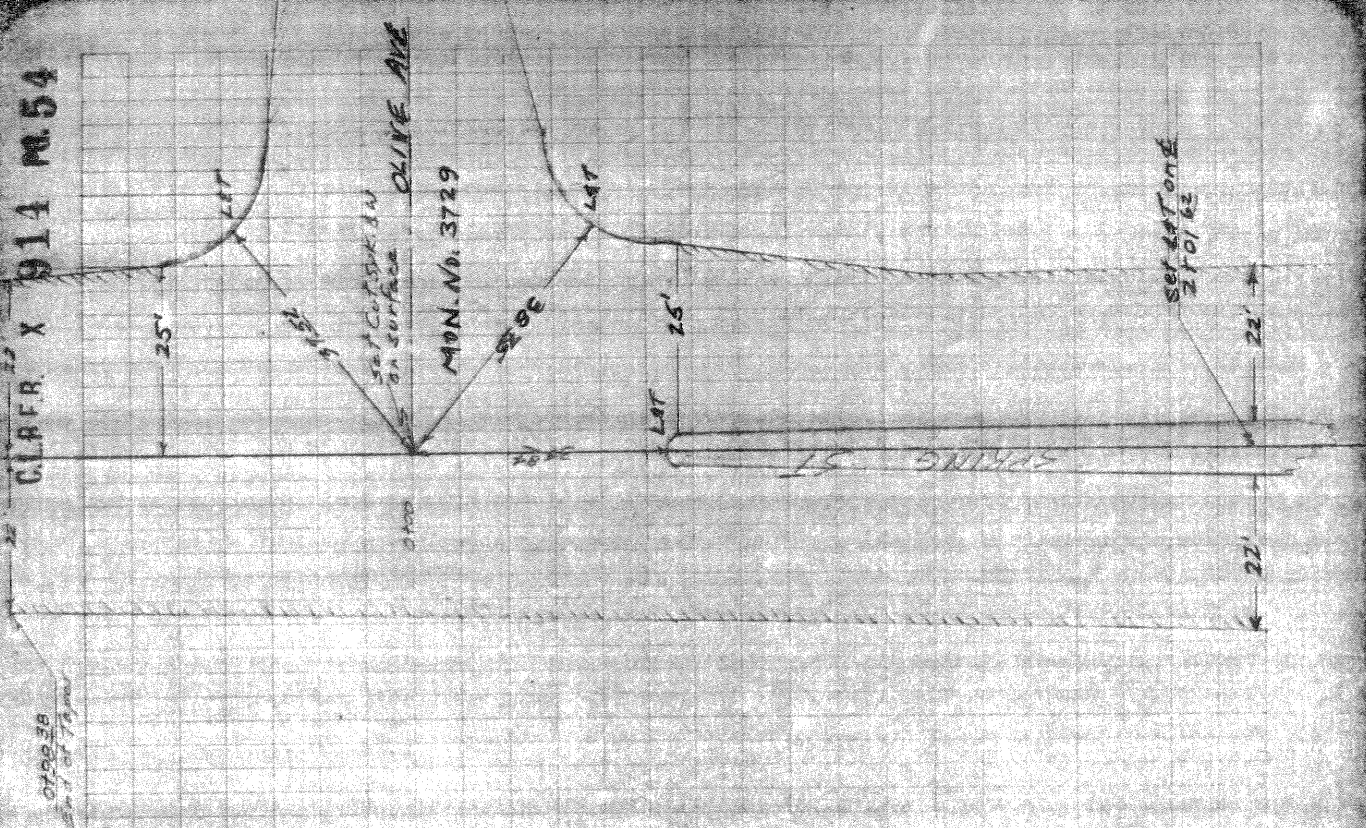

2225

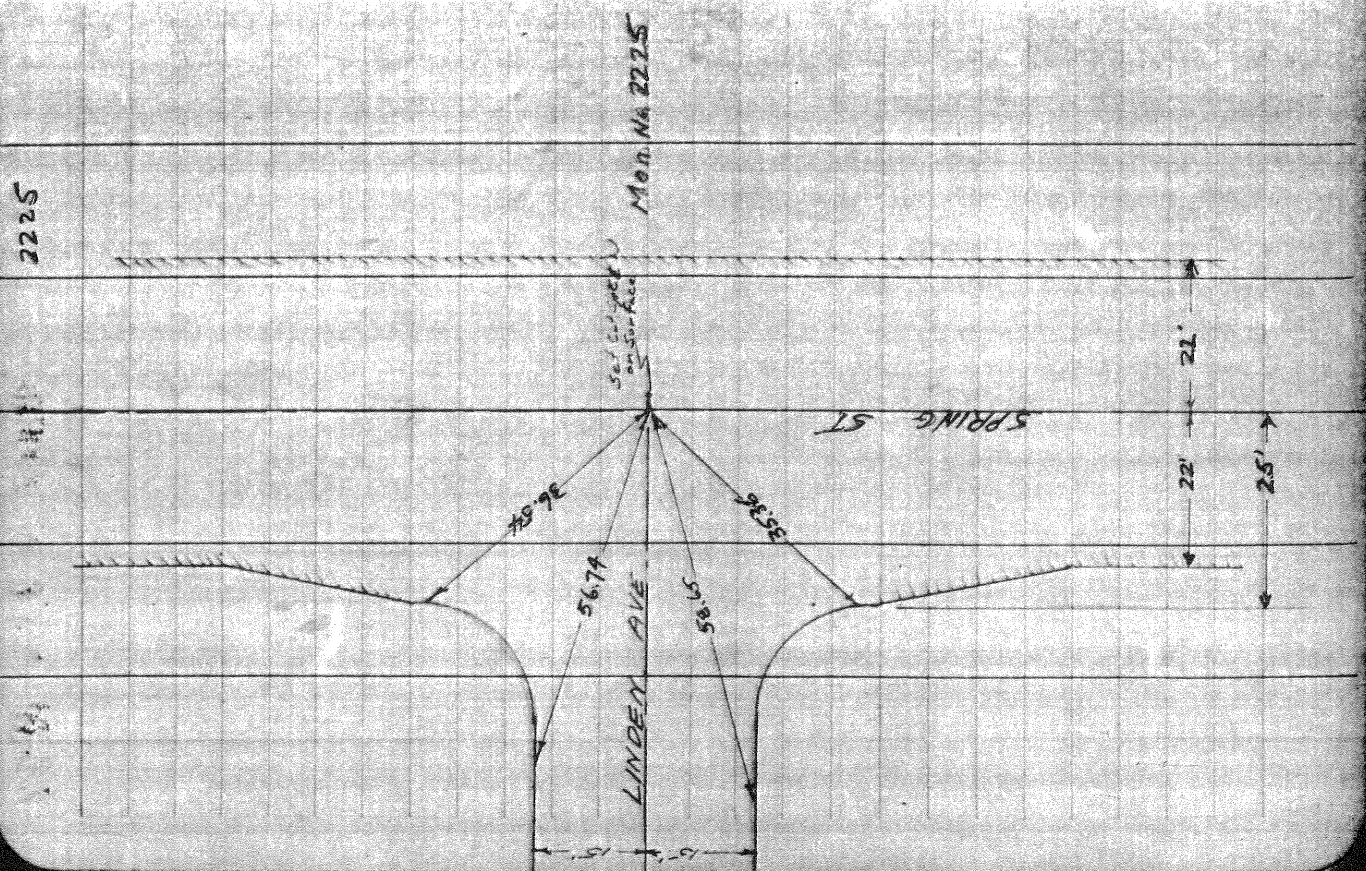



2175 Cherry Avenue • Signal Hill, California 90806 • (310) 989-7300 • FAX (310) 989-7393/7391

80. CALIF. BLUE PRINT CO. -

SURVEY OF GUNDRY & 28th STREET F. B. Pg.

SURVEY BY PFEILER & ASSOC

DATE 4-30-83 WFC/OCT TR. No.

CONC SPUR 32
SET LEAD
SET TACK

55' 51' 30"
55' 51' 30"
55' 51' 30"

STREET

44' 50'

GUNDRY

AC BERN


SET SPUR 10
N.W. 1/4 FACE
OF T&E #1731870E

SET PD 40' 50' 10"
N. 30' 00' 00" E
10' 00' 00" W
10' 00' 00" S

CONC SPUR 30
SET LEAD
SET TACK

58' 75"
57' 01' 30"

28th

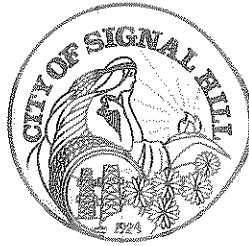


CITY OF SIGNAL HILL

2175 Cherry Avenue Signal Hill, California 90806 (310) 989-7300 FAX (310) 989-7393/7391

CO ENG FB 3654 - 40

28th St. @ Gardena Avenue

SURVEY OF _____ F B NO. _____ PAGE _____
 SURVEY BY Joseph M. Phelps TRACT NO. Parcel Map 13498
 DATE April 22, 1981 City of Signal Hill
 "RCE 7964" County of Los Angeles

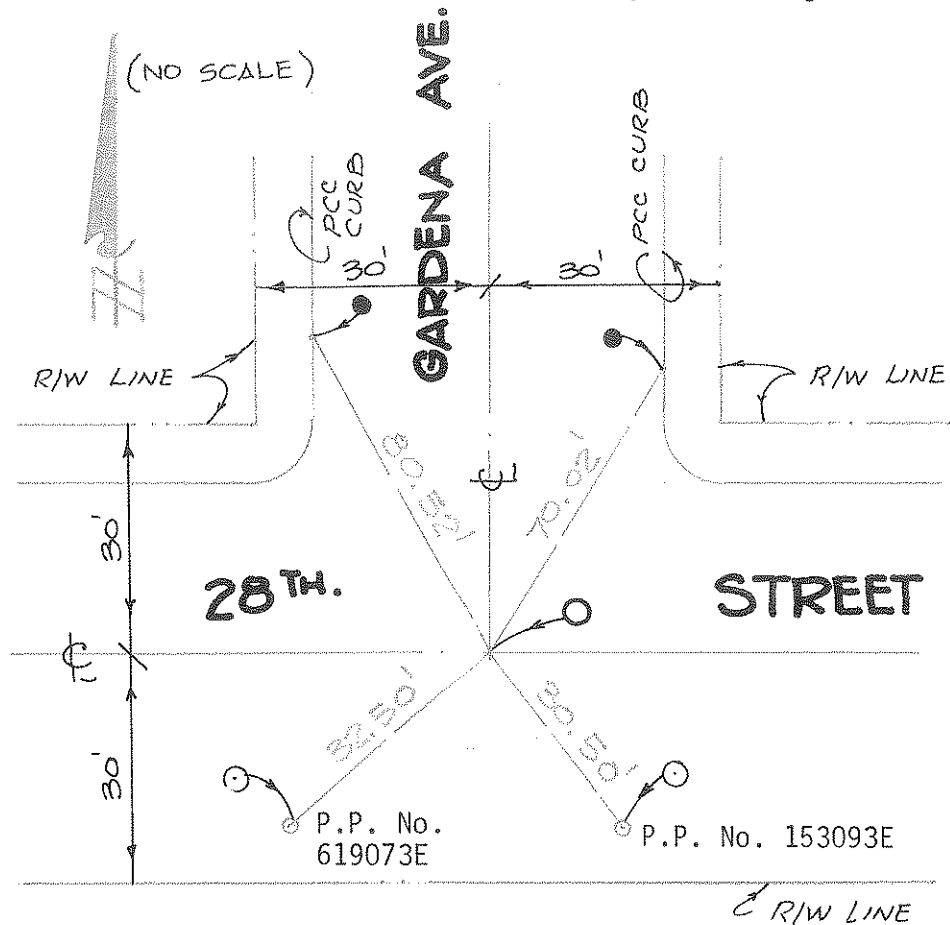

- Found Nail & Tin in P.P.
- Fd. Nothing. Set Spike & Washer stamped "RCE 7964".
- Found Lead & Tack.

SURVEYORS SERVICE COMPANY STA MESA - STOCK NO. 411

DO NOT EXTEND NOTES THIS SIDE OF LINE



CITY OF SIGNAL HILL


2175 Cherry Avenue Signal Hill, California 90806 (310) 989-7300 FAX (310) 989-7393/7391

Profile	Notes Red	Plotted	Job No.	Division No.	F. B.	Pg.
No.	Date	Date	Survey of	E TIES AT GUNDRY AVE & 21ST ST		
X-Sec.	Notes Chkd.	Checked	Survey by	RBF	Notes	RBF
No.	Date	Date	Map No.	Indexed	Date	NOV 1983



NOTE: ANY ADDITIONS OR CHANGES ON THIS SHEET MUST BE MADE OR CIRCLED IN RED INK. WITH DATE AND NAME OF PERSON MAKING CHANGE

Do not extend notes this side of this line.

PLEASE RETURN TO
SIGNAL HILL
ENGINEERING DEPT.
2175 CHERRY AVE.
SIGNAL HILL, CALIFORNIA

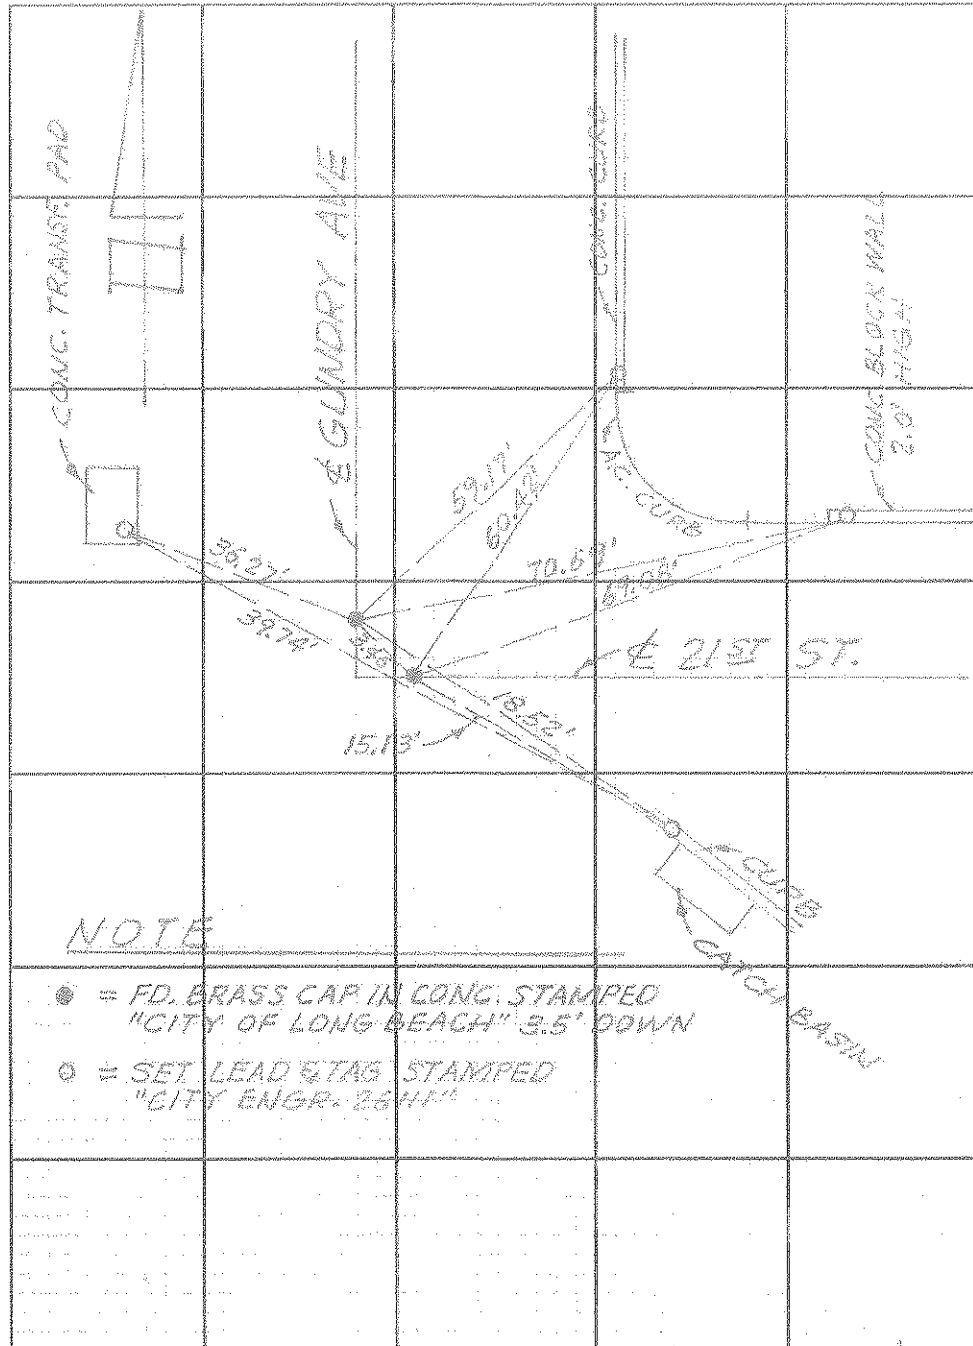

7A

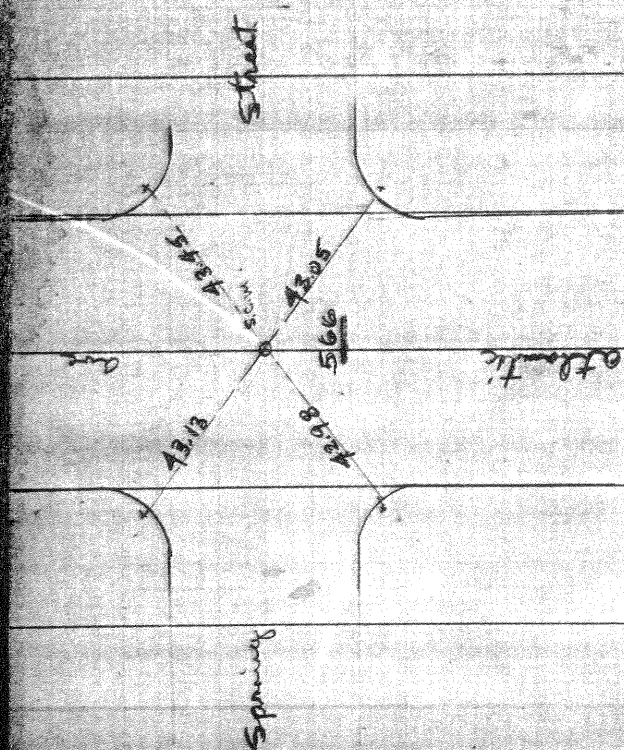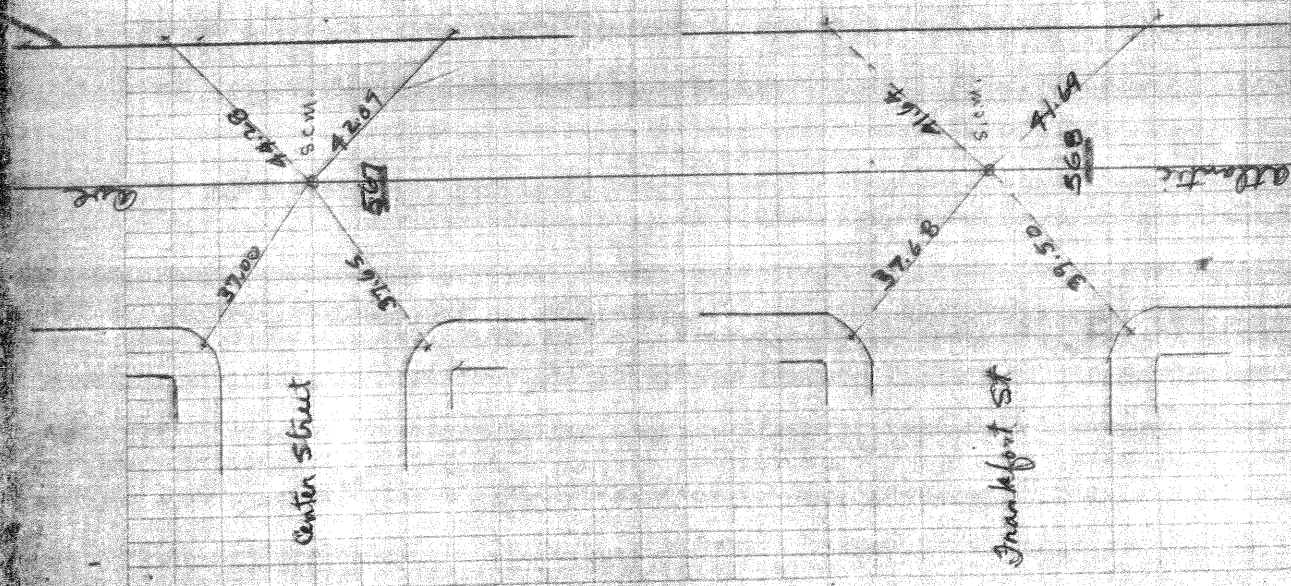

I set up on Mon No. 50
 Set Azimuth of good on
 and take reference points as follows.

Pole	104° 00'	72.19	S.E. cor.
Brass Tack	232° 35'	51.04'	N.W. cor.
T.I. Plc	305° 20'	37.88'	Lat Corner
2 1/2" p.p.c.	45° 03'	42.49'	
Hydant	52° 32'	31.32	
Brass Tack	63° 31'	82.22	
		2600	House No. 601

We chain along E of Willow to Monument
 in O of California Ave.


- (1) st (East) 1320.87 less tape correction of .13 = 1320.74'
- (2) nd (West) 1320.97 .13 = 1320.84'

We read Lat O of Atlantic & Willow

Atlantic - Willow	00° 00' 00"	101 1099' 41"
American	179° 58' 06"	179° 58' 06"

We read Δ at O of Willow & American (Tack & Tin)


W.F.C.C.	00° 00' 00"	101 1798' 52"
Atlantic - Willow	179° 53' 30"	179° 53' 12"

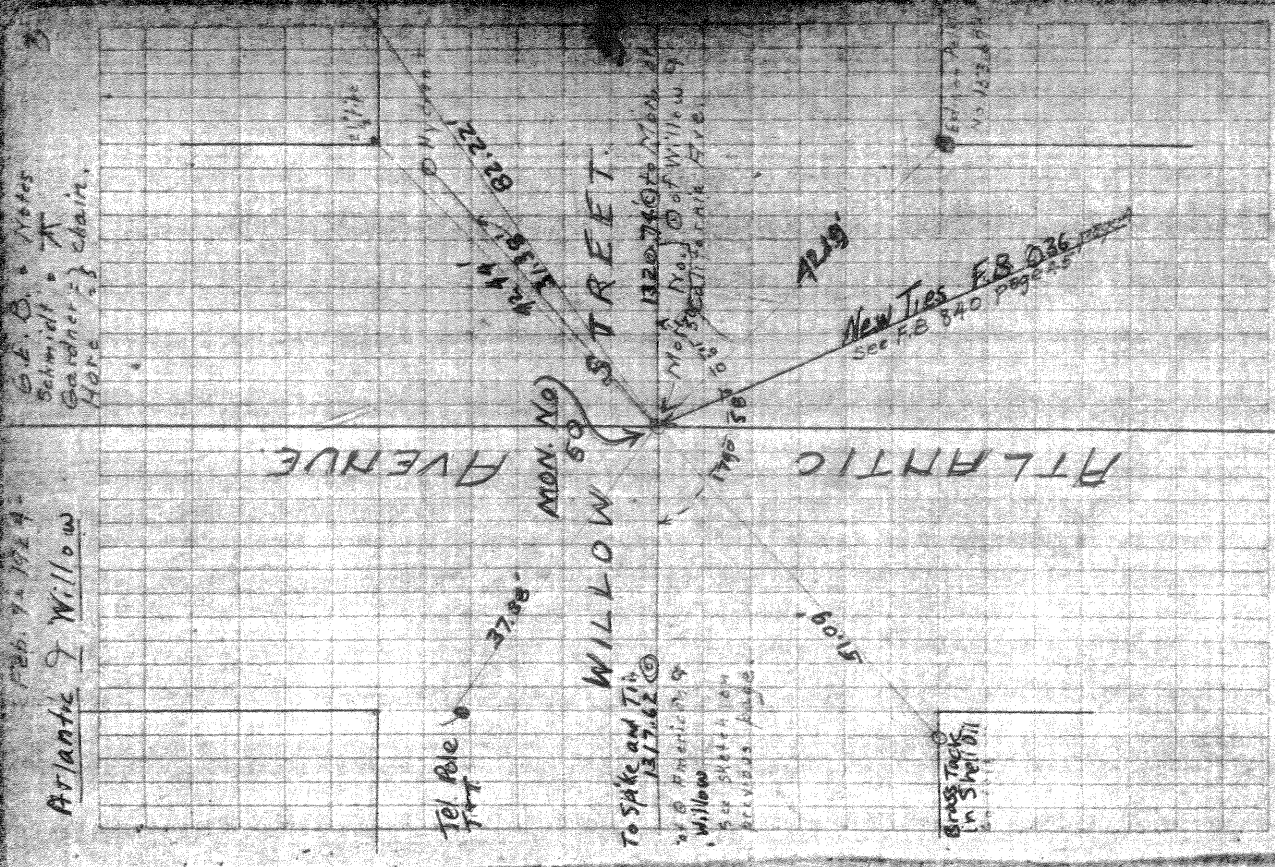



Atlantic & Willow
 Feb. 7-1924
 G.D. O. Notes
 Schmidt - T
 Gardner - chain
 Here

New Ties F.B. 036
 See F.B. 840 p. 255

Brass Tack
 in Sheldill

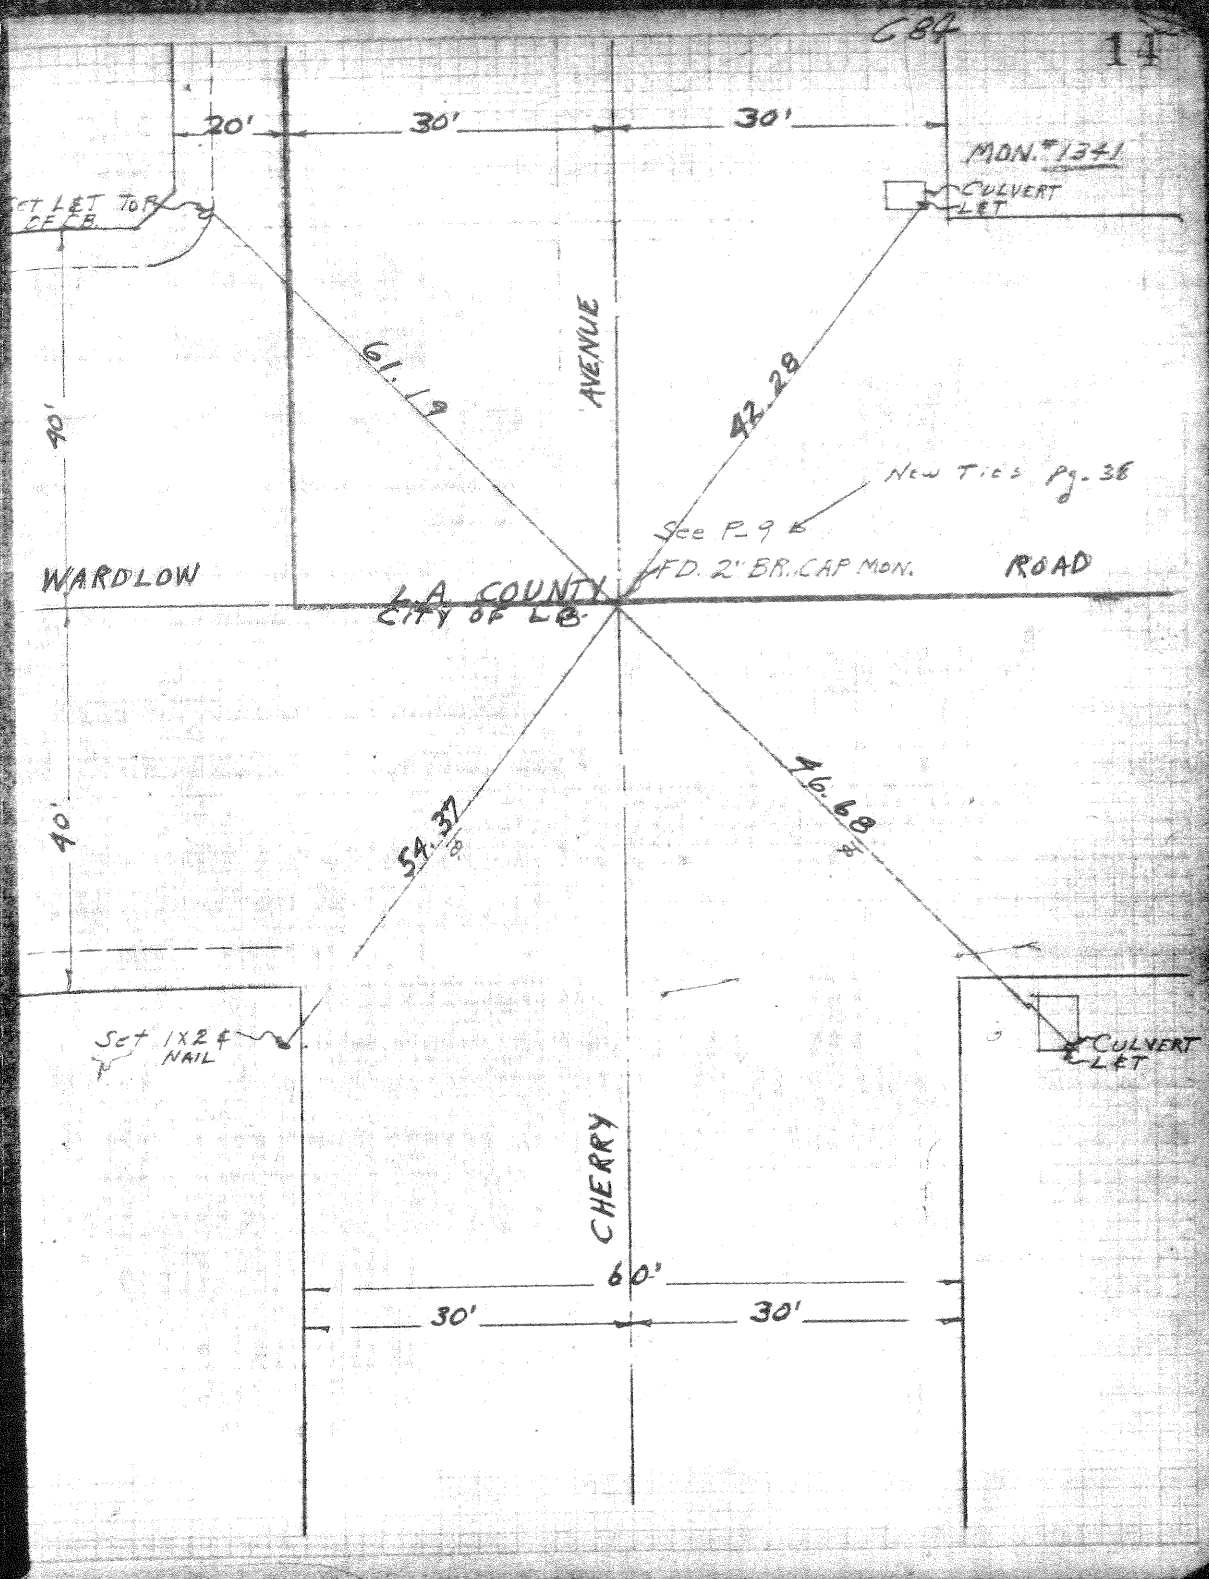


C. I. R. F. B. X JUL 14 PM 78

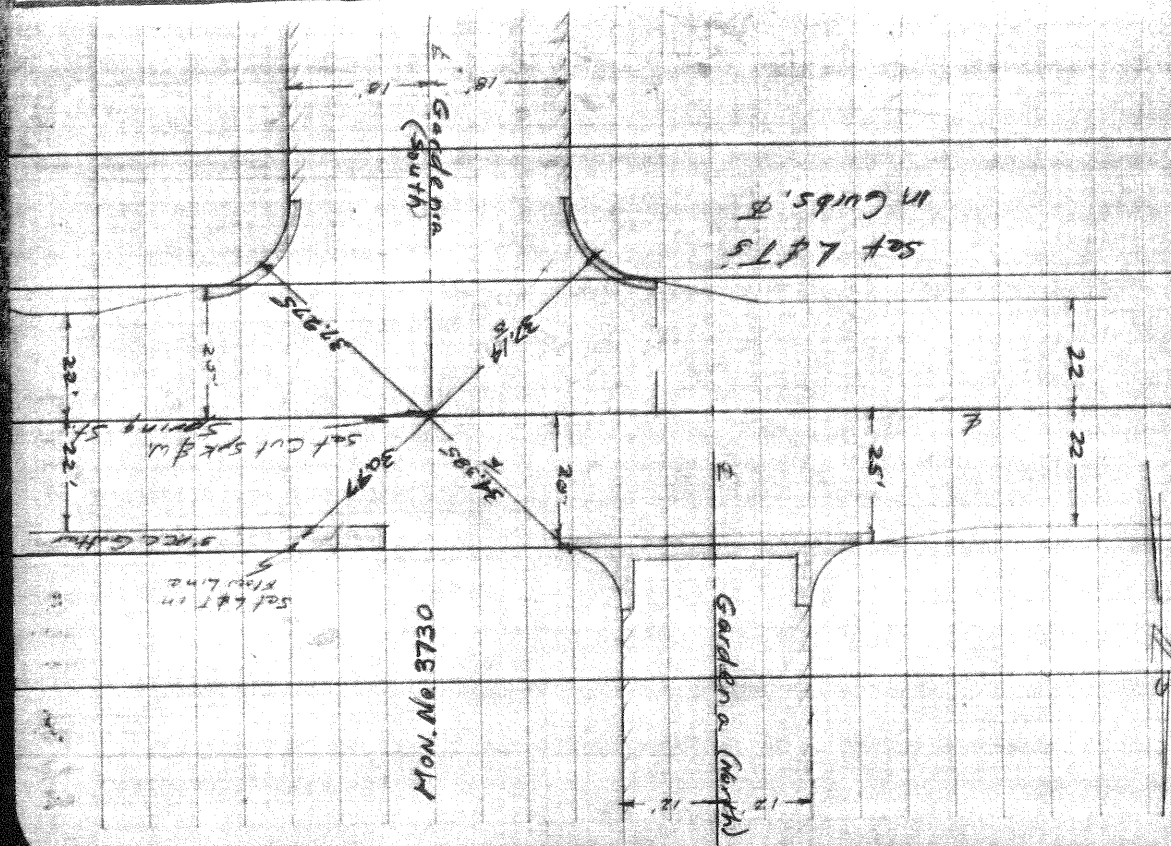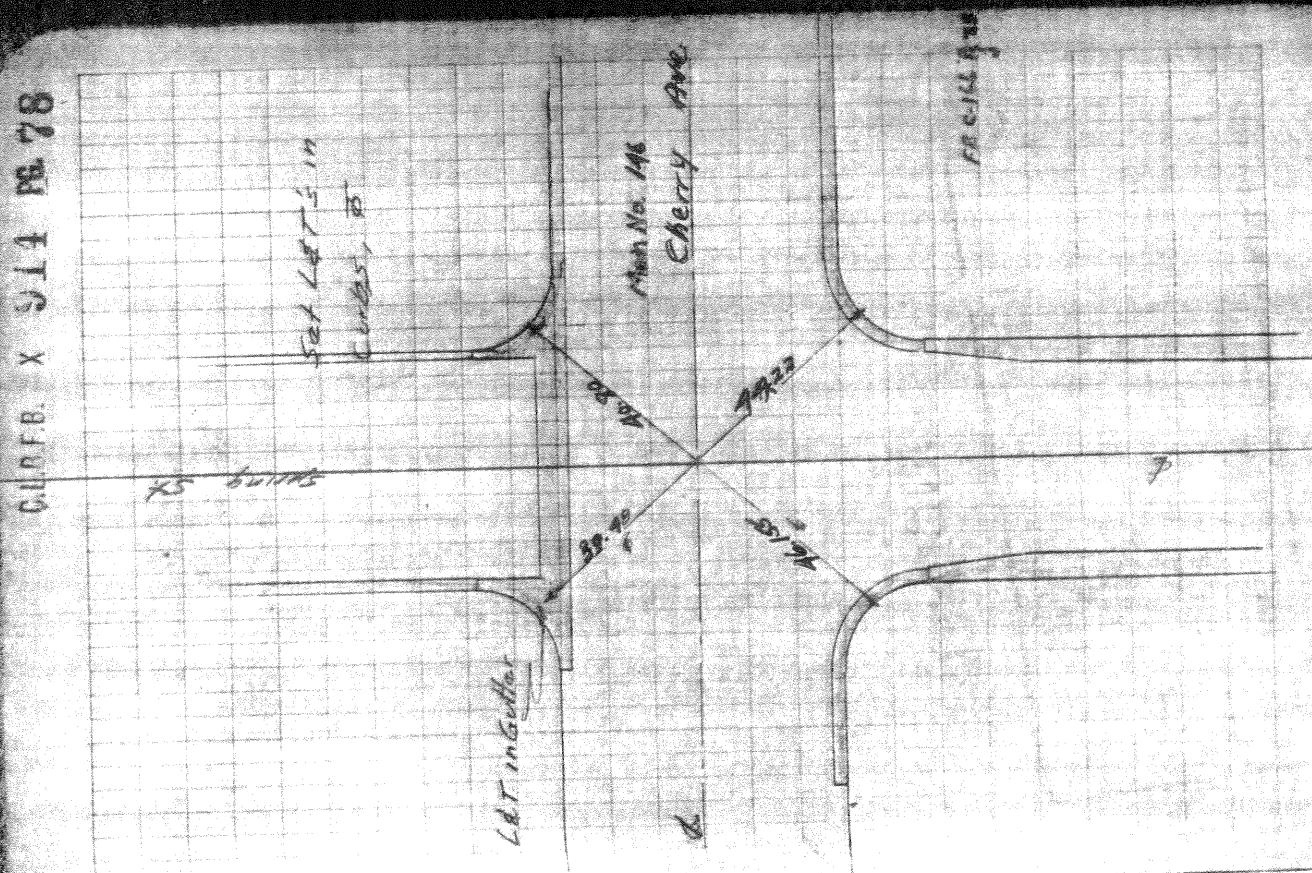

NO
SCALE

4 SPRING ST.

7

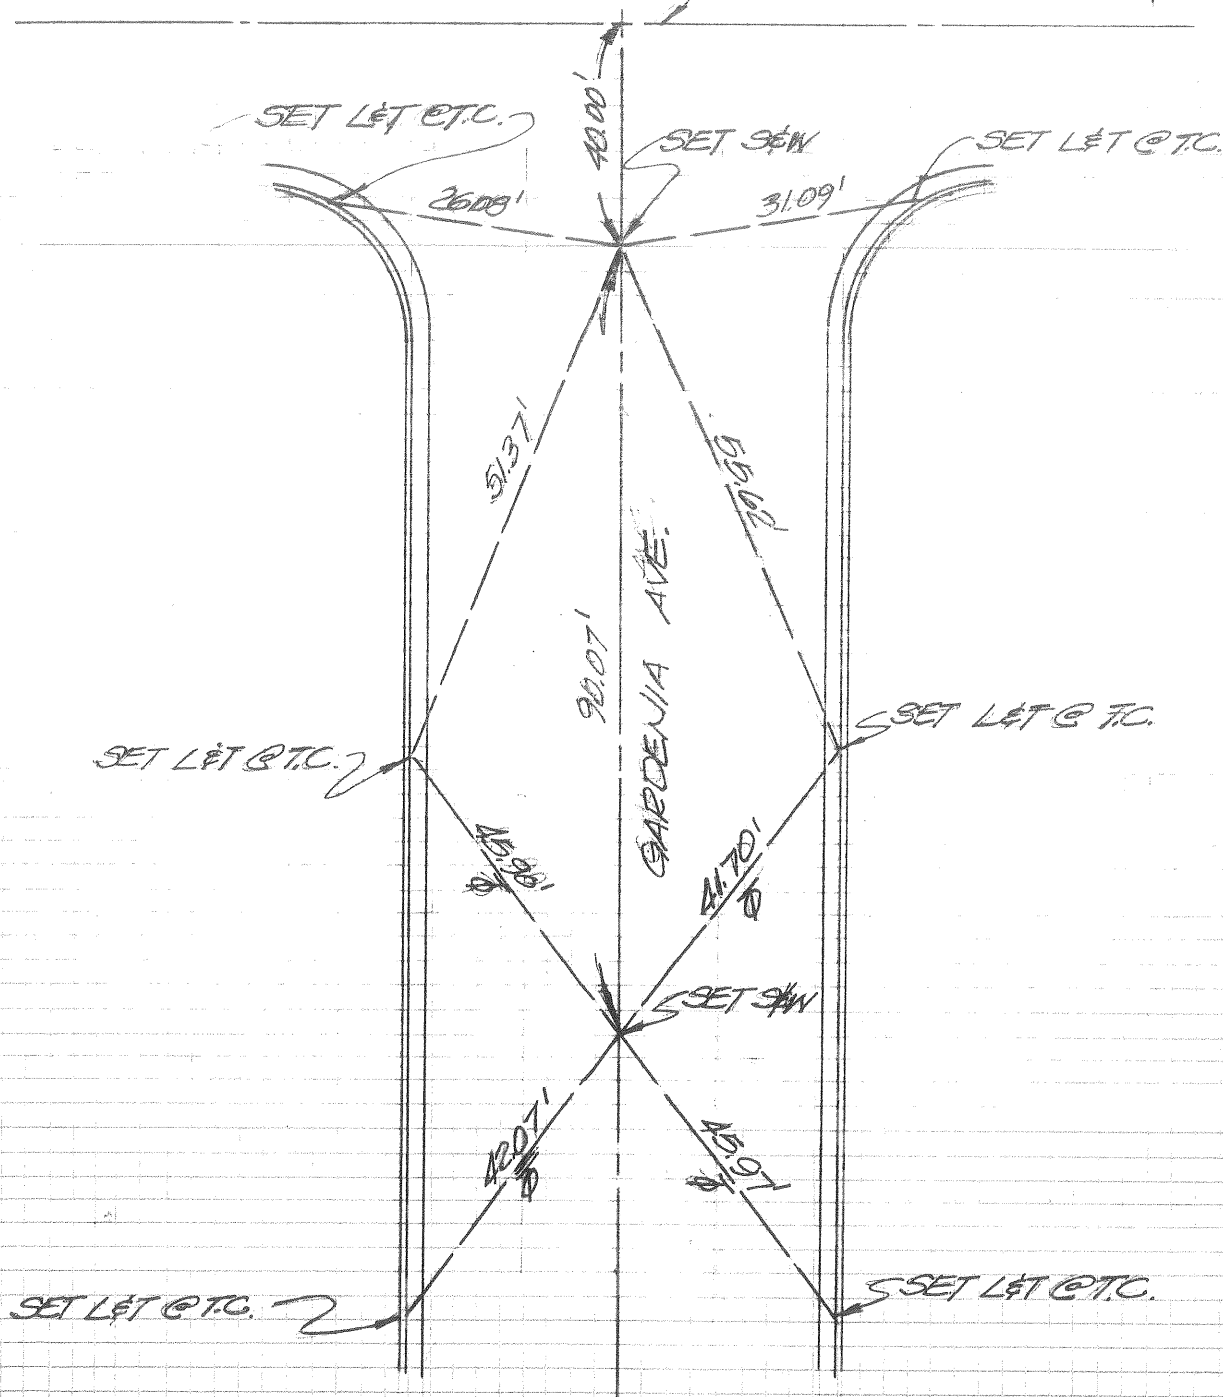

NO
SCALE

242 SPRING ST

SET L&T@T.C.

(SET L&T ETC.

(SET SFW

65.20

45.99

SET LET C.T.C. 2

19.22

136.97' CHERRY AVE.

5/9/10

5 SET 4 T @ T.C.

SET LET @ T.C. 7

6/1/20

49.24

SET LET@T.C.

49.31'

GET S.C.W

5/5/61

5 SET LET @ 7C

SET LEFT C.T.C. 2

Notes Any Additions or Changes on this Sheet Must be Made by Circled in Red Ink With Date and Name of Person Making Change. Do not extend notes this side of this line. RETURN TO LOS ANGELES COUNTY SURVEYOR 700 HALL RECORDS FORM 847 EN 11-46	WS. 30-1-D-2	Notes C'd by <u>W. O. Johnson</u>		Survey of <u>A. P. Gentry & Sons, Inc.</u> F. B. 1483 Pg. 7	
		Map No. <u>2-2167-1</u>		W. O. <u>355</u> Tape No. <u>295</u> S'd <u>55</u> of	
		Office Work <u>W. O. Johnson</u>		Surveyed by <u>W. O. Johnson</u>	
		Checked <u>W. O. Johnson</u>		Notes <u>11</u> Date <u>10-5-45</u>	
		Date <u>10-5-45</u>		Indexed <u>C. Johnson</u>	

Con't. on bot. pg. 8

839.85T=64°
839.83

(30)

391.32T=66°
391.31

① 59°42'00"
② 358°48'20"
89°42'05" ✓
③ 178°12'40"
89°42'06 2/3

AVE

89°42'00"

53' 40.00

89°

751.05

751.05

Stamped as shown
10-24-49

COUNTY SURVEYOR
R.E. 328

Set

shown. 12

57.00

30.00

310.74

To 80

Blanchard fd Conc Mon. with
Cpr. Spk 20" dia per FB 293
152-162 F.B. 467-15-10-3
F.B. 863-E4

WILLOW ST
1120.84
1120.75 per
F.B. 467-10

Fd L & T Conc. Hd. w.

29.18

391.31

619.070E

31.35

69.00

751.05

839

524

29.99

53.66

29.99

391.31

30.89

REDONDO

COUNTY SURVEYOR
SEC. COR. 20.21
R. 72 W. 29.23
T. 4 S.
R.E. 328

Set 14" T.P. 14
#612041E

See pg. 20, 21 & 22

RETURN TO
LOS ANGELES COUNTY SURVEYOR

1900
 1901
 1902
[illegible]

Date _____

Notes by

Chief Party

FR

25

156

Platted by: H.N.P. Production
Date: Feb. 1933
Map No. C.S.B-644
Platting C'd by Drew
Date: Feb 1933

W. D. No. _____ D. S. O. No. _____
Location _____
Surveyed by _____
Date _____
Indexed _____

90403-20
O.K.
F.N.T
T.P.

28th

INT. by ^{into}
Set 2x2
6" DOWN
Set (8) in con
wier box

13.19.88 T68°-13.19.74
Ave.

Int.
Fg. 1 1/2" L.P.
18" Down
Set 2x2
6" Down
F.B. 62-119

FA2 1/2" I.P.
Marked Western
Oil Refining Co
No. W. Cor

SPRING

① $90^{\circ}-03-15$ ✓
② $160^{\circ}-13-15$

① 90°-02-30" ✓
② 90°-09-45"

$\angle 90^\circ - 07' 30''$
 $\angle 60^\circ - 30' - 00''$


S. E. Cor. Western Oil Refining
Prop. Cor. Co.
Ed. 2nd fl. + 1st fl.
1 1/2" up

Inf.
Set 12

From
Int. Temple
page 154

Note: the CR of
western oil Refining
Co. Not set accurately
according to
their gauge

90°-03'15"20 ✓
360°-12'45"00 ⊕

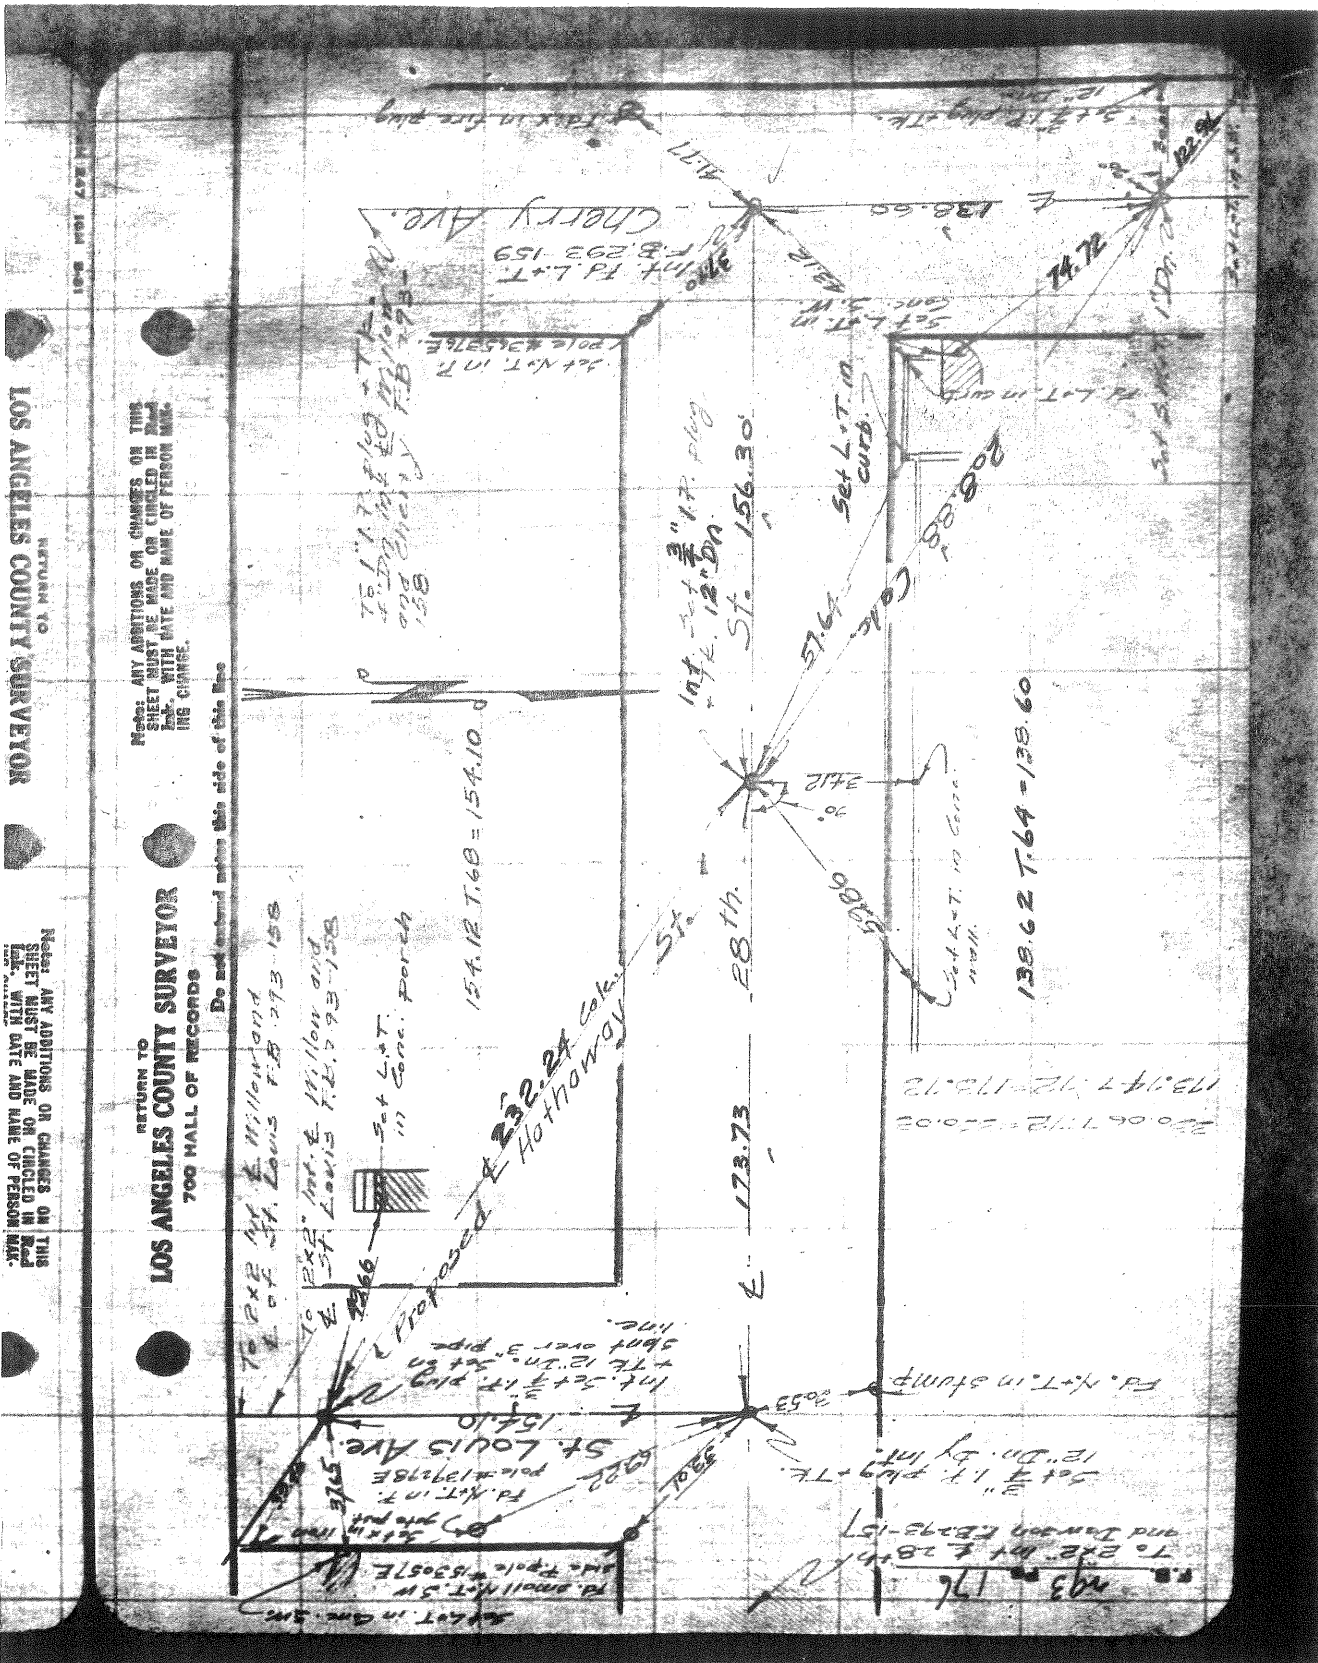

LOS ANGELES COUNTY SURVEYOR

RETURN TO
LOS ANGELES COUNTY SURVEYOR
700 HALL OF RECORDS

THIS SHEET MUST BE MADE OR CIRCLED IN RED
WITH DATE AND NAME OF PERSON MAKING CHANGE.

RETURN TO
LOS ANGELES COUNTY SURVEYOR
700 HALL OF RECORDS

Do not extend more than this side of this line

To 2nd 1/2 of St. Louis T.B. 158

To 2nd 1/2 of St. Louis T.B. 159

To 2nd 1/2 of St. Louis T.B. 160

To 2nd 1/2 of St. Louis T.B. 161

To 2nd 1/2 of St. Louis T.B. 162

To 2nd 1/2 of St. Louis T.B. 163

To 2nd 1/2 of St. Louis T.B. 164

To 2nd 1/2 of St. Louis T.B. 165

To 2nd 1/2 of St. Louis T.B. 166

To 2nd 1/2 of St. Louis T.B. 167

To 2nd 1/2 of St. Louis T.B. 168

To 2nd 1/2 of St. Louis T.B. 169

To 2nd 1/2 of St. Louis T.B. 170

To 2nd 1/2 of St. Louis T.B. 171

To 2nd 1/2 of St. Louis T.B. 172

To 2nd 1/2 of St. Louis T.B. 173

To 2nd 1/2 of St. Louis T.B. 174

To 2nd 1/2 of St. Louis T.B. 175


To 2nd 1/2 of St. Louis T.B. 176


To 2nd 1/2 of St. Louis T.B. 177

To 2nd 1/2 of St. Louis T.B. 178

To 2nd 1/2 of St. Louis T.B. 179

To 2nd 1/2 of St. Louis T.B. 180

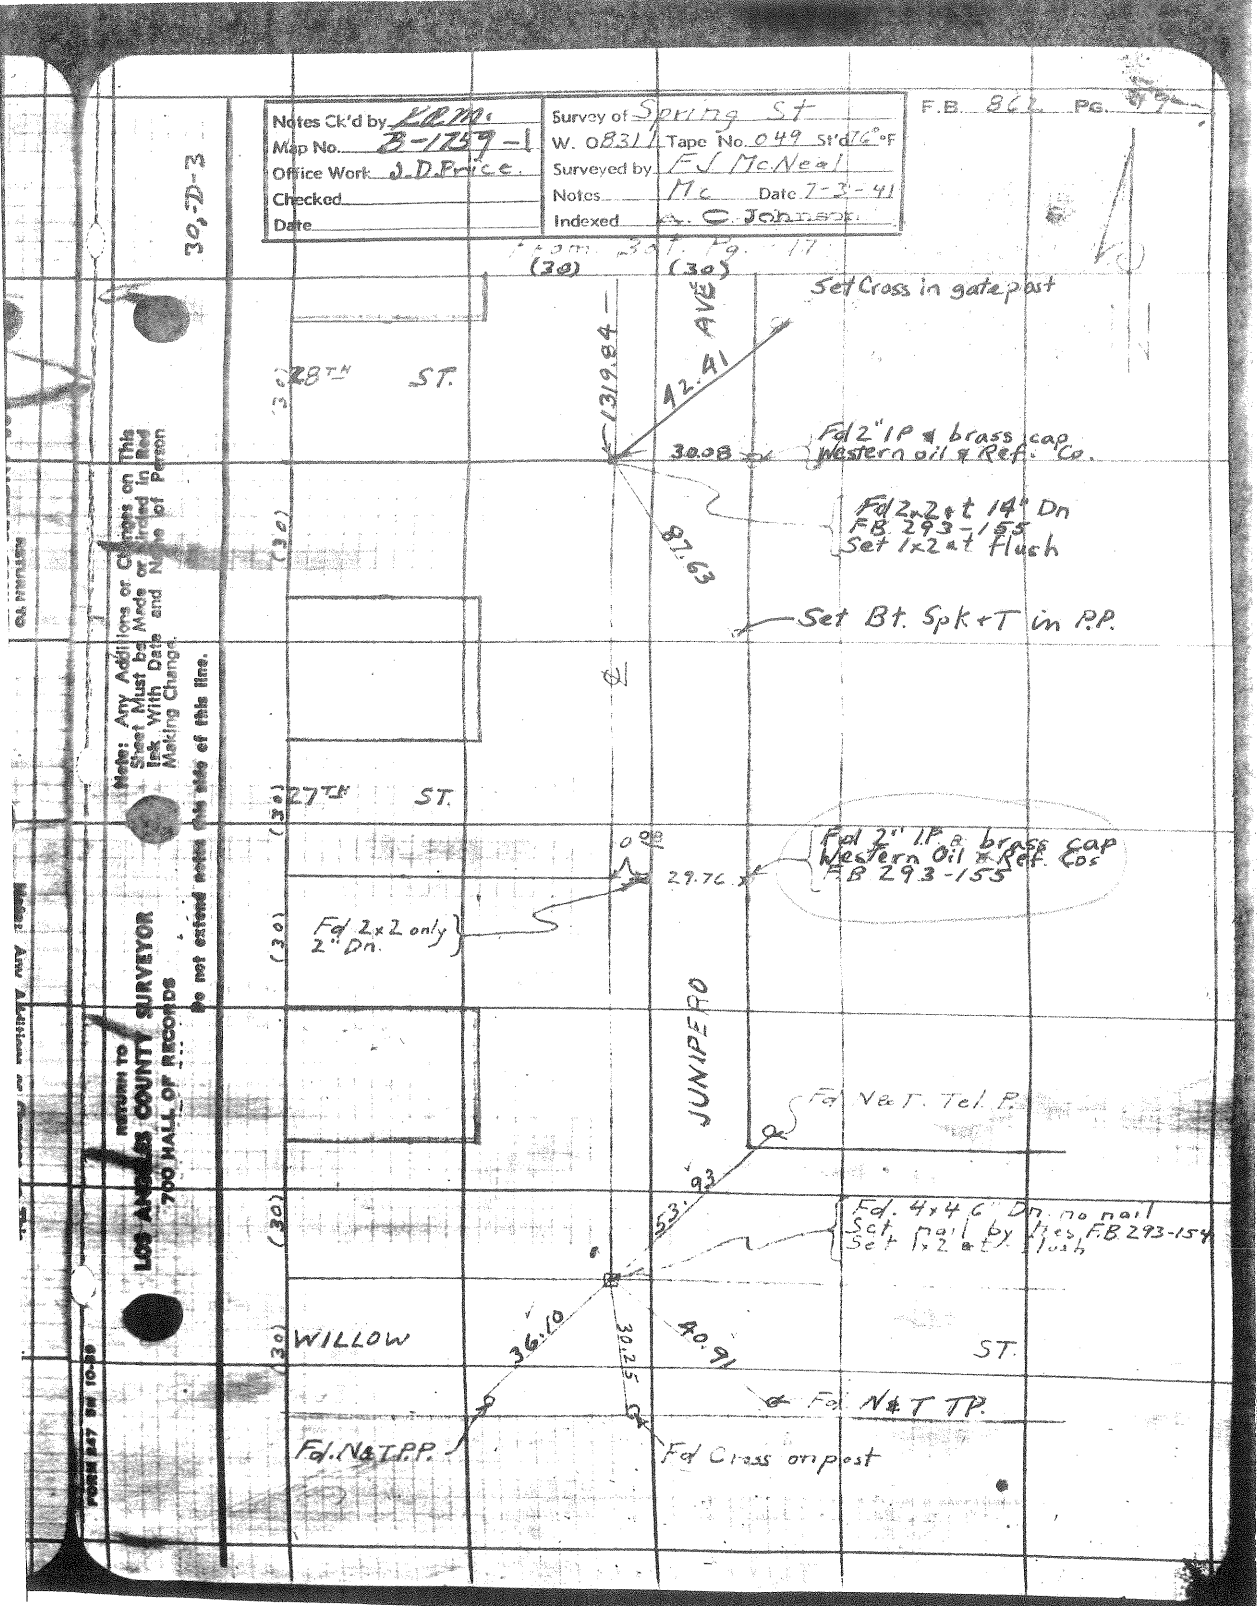

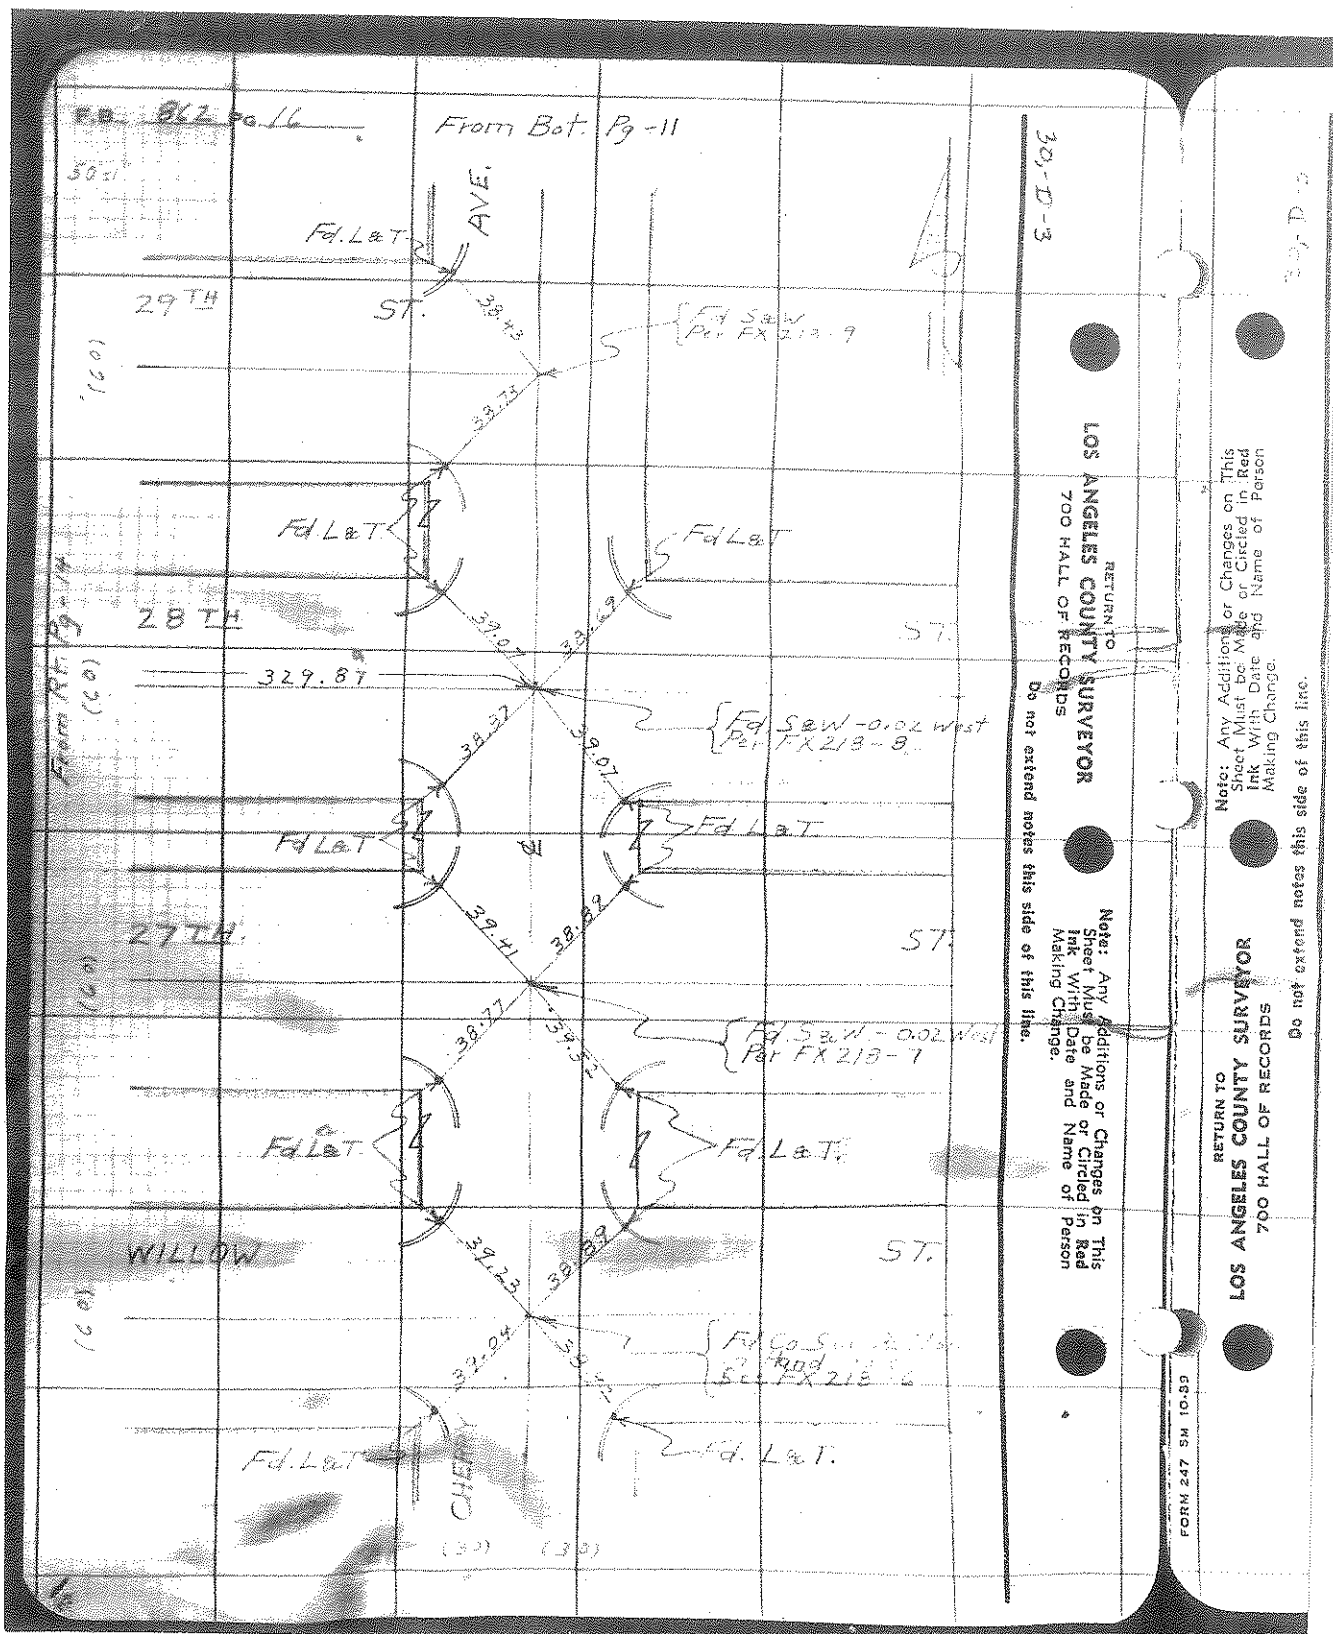

SURVEY OF CITY SIGNAL HILL


JOB NO. 24362 BOO

34

SURVEYED BY COWAN, LOONEY, ROCKY

DATE 8-3-89

Robert Bein, William Frost & Associates
PROFESSIONAL ENGINEERS, PLANNERS & SURVEYORS
P.O. BOX 19739 • 14725 ALTON PARKWAY • IRVINE, CA 92716
(714) 472-3505 • FAX (714) 472-8373

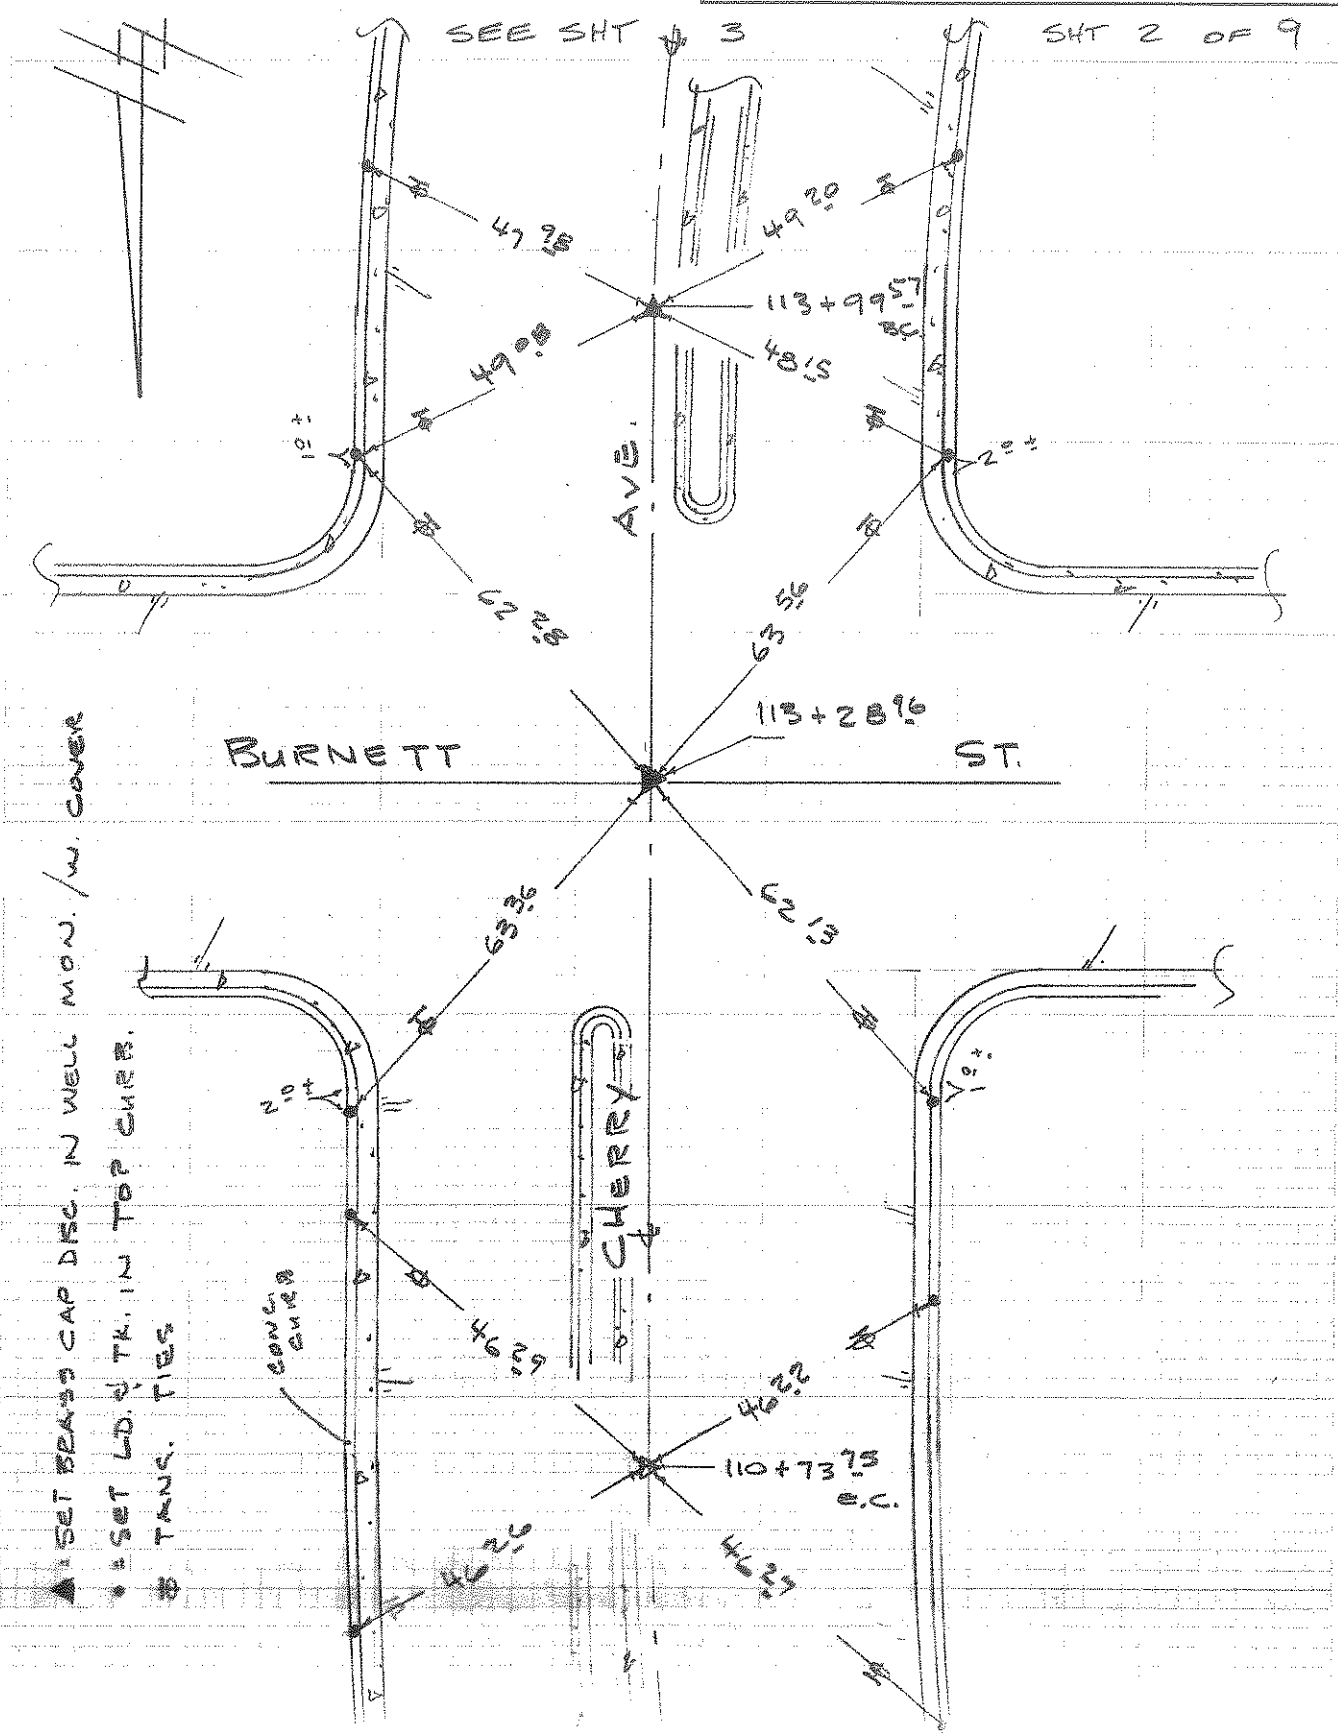

SURVEY OF CITY OF SIGNAL HILL
SURVEYED BY SMITH, ROCKWELL


JOB NO. 24362 BOOK 801
DATE 8-3-89

35

Robert Bein, William Frost & Associates

PROFESSIONAL ENGINEERS, PLANNERS & SURVEYORS
P.O. BOX 19739 • 14725 ALTON PARKWAY • IRVINE, CA 92718
(714) 472-3505 • FAX (714) 472-8373


4 TIES

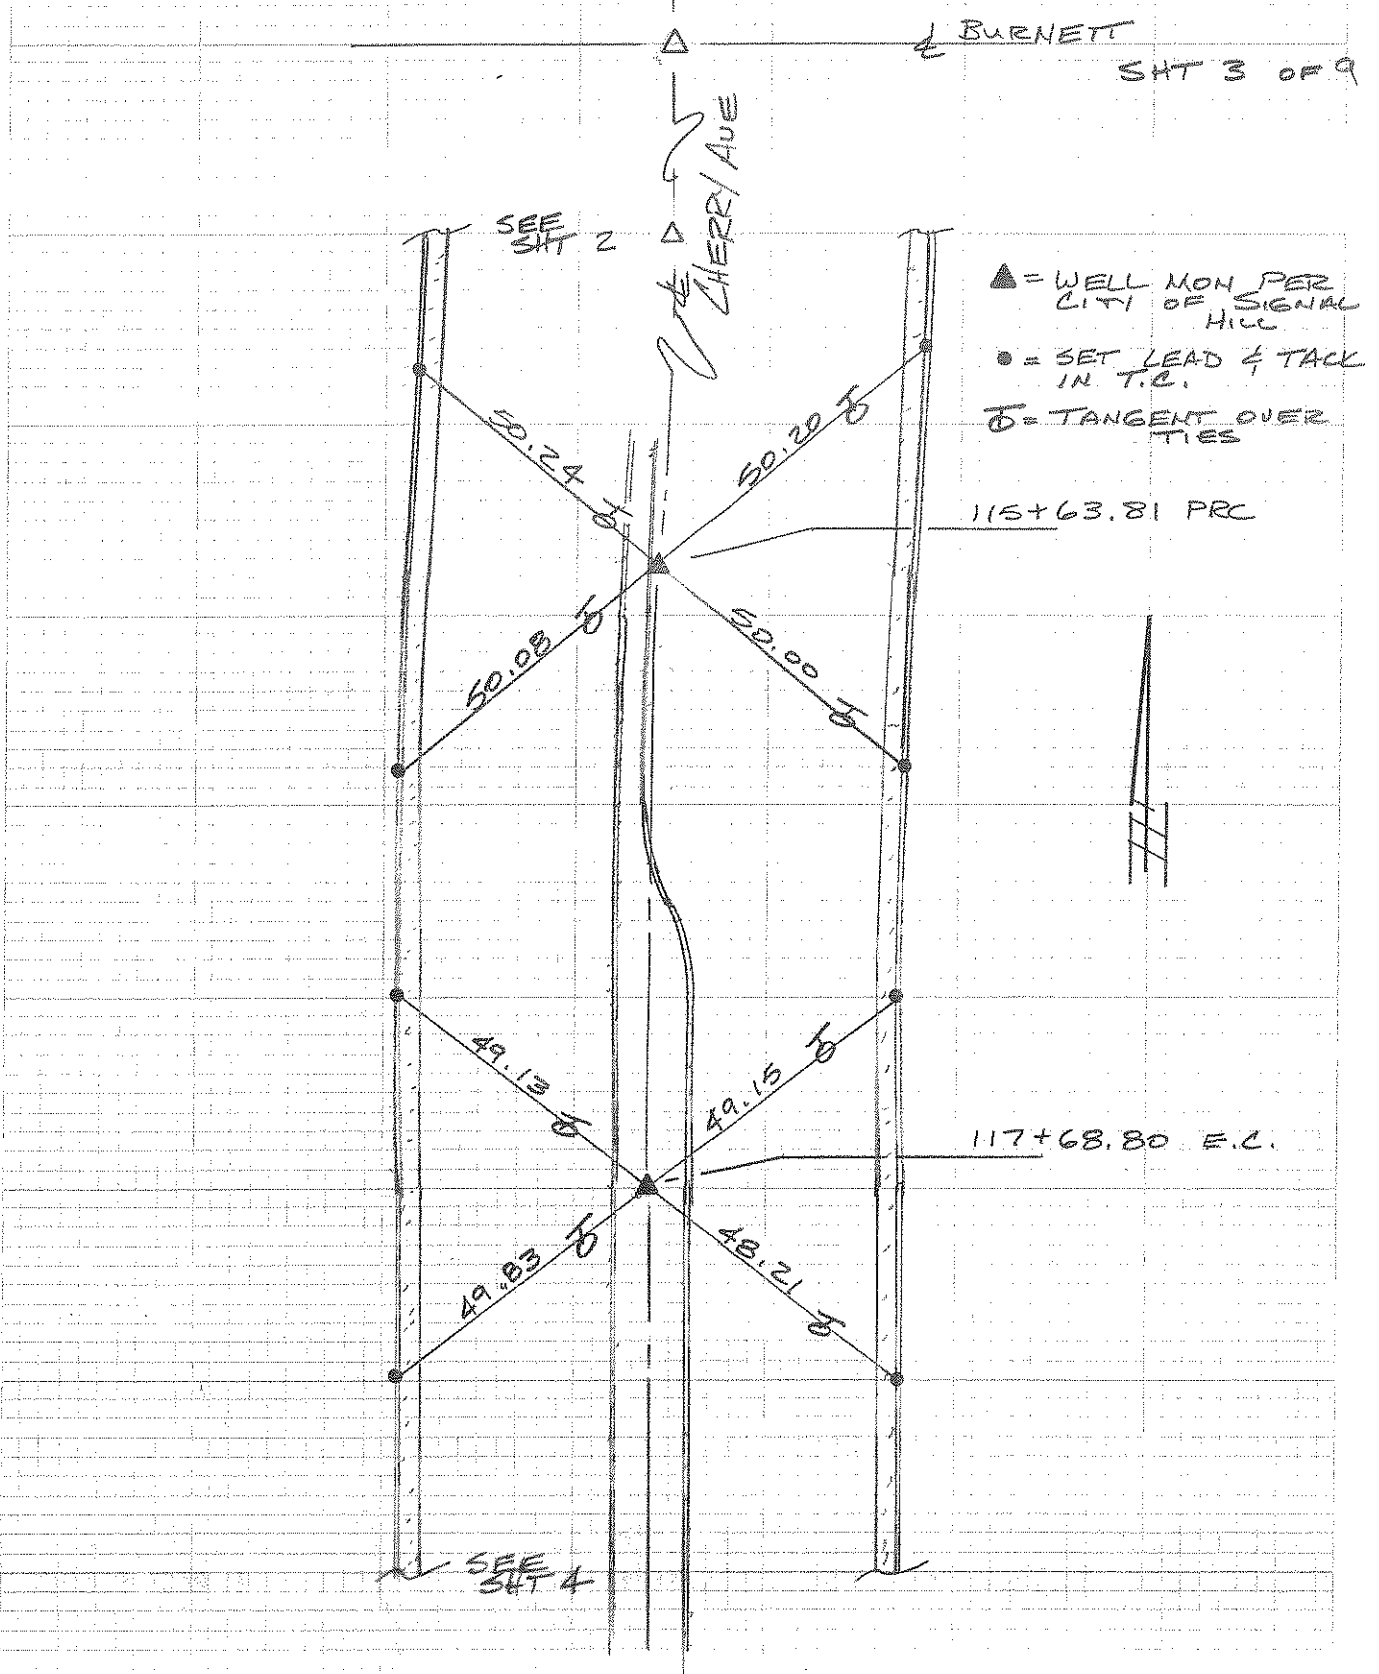


Robert Bein, William Frost & Associates
PROFESSIONAL ENGINEERS, PLANNERS & SURVEYORS
P.O. BOX 19739 • 14725 ALTON PARKWAY • IRVINE, CA 92718
(714) 472-3505 • FAX (714) 472-8373

SHT 4 OF 9

- ▲ = WELL MON PER CITY OF SIGNAL HILL
- = SET LEAD & TACK IN T.C.
- ⊘ = TANGENT OVER TIES

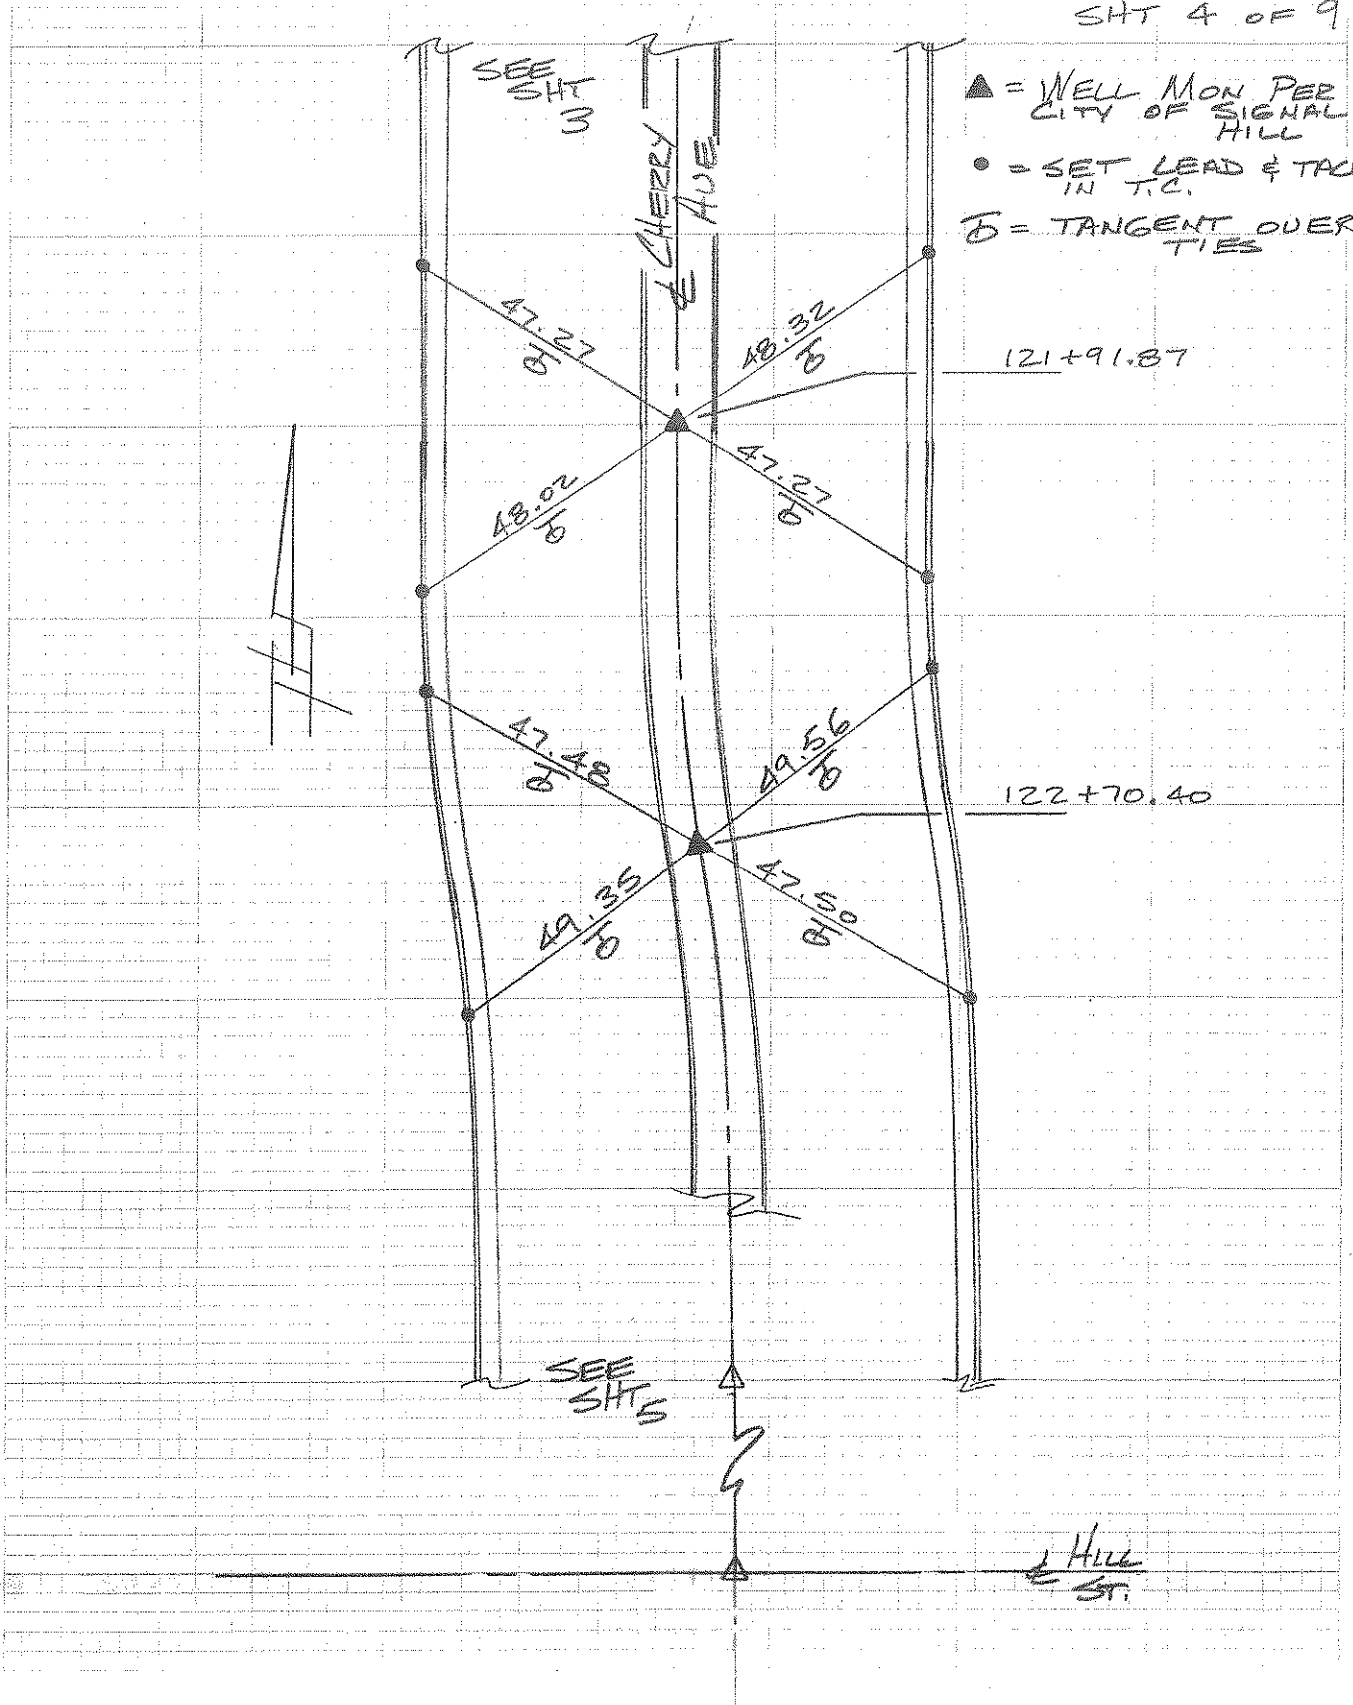

Robert Bein, William Frost & Associates
 PROFESSIONAL ENGINEERS, PLANNERS & SURVEYORS
 P.O. BOX 19739 • 14725 ALTON PARKWAY • IRVINE, CA 92718
 (714) 472-3505 • FAX (714) 472-8373

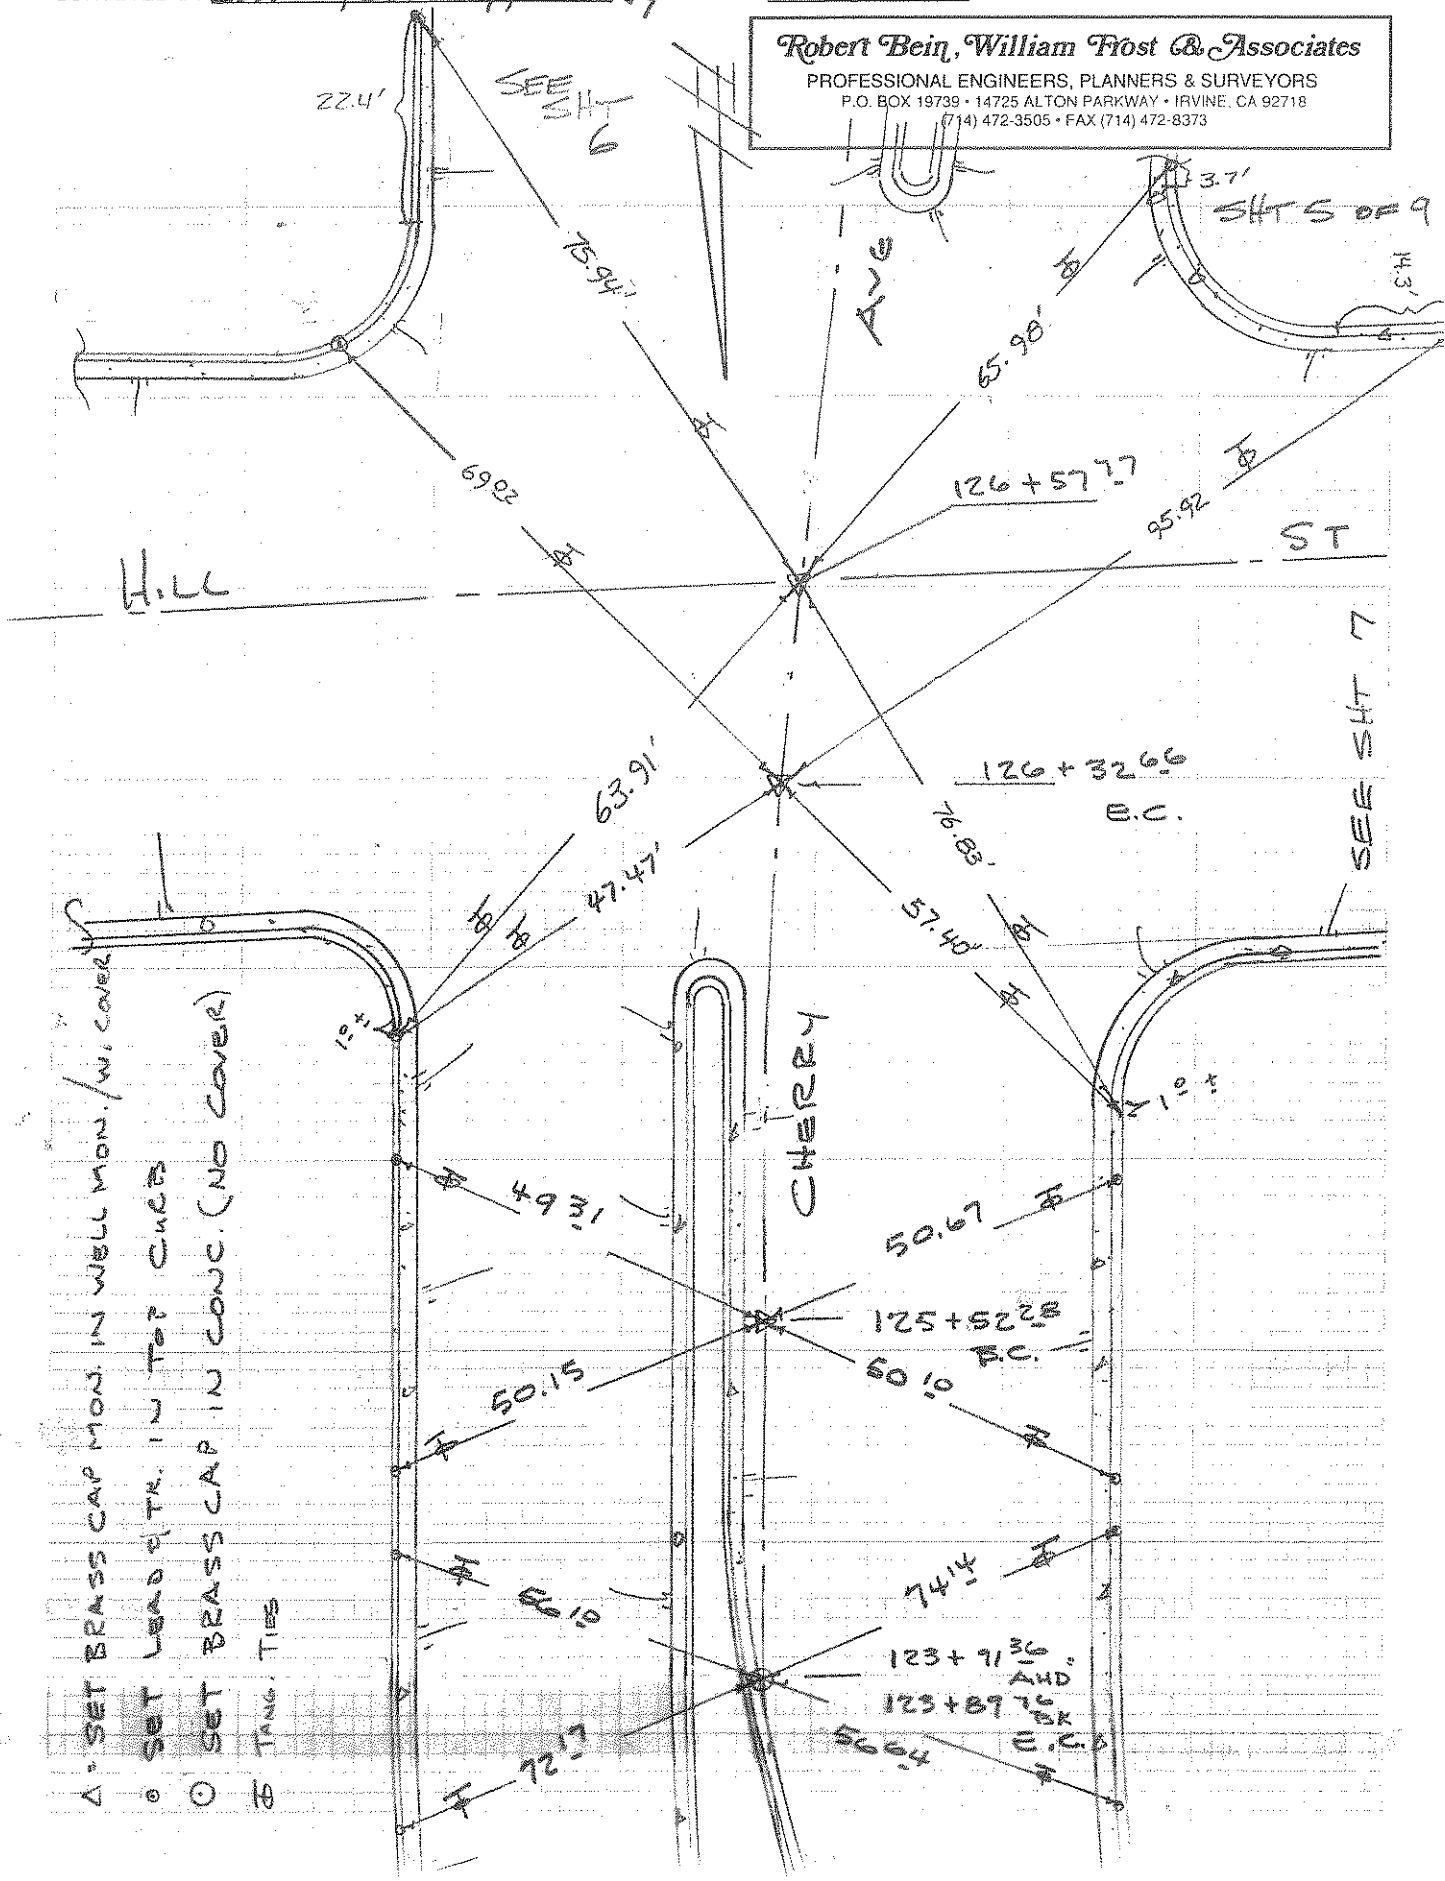



△ SET BRASS CAP MON. IN WELL MON. W/ COVER
 ○ SET LEAD QTR. IN TOP CURBS
 ○ SET BRASS CAP IN CONC. (NO COVER)
 ⊕ TANG. TIES

2175 Cherry Avenue Signal Hill, California 90806 (310) 989-7300 FAX (310) 989-7393/7391

L.S. 2488

DO NOT EXTEND NOTES THIS SIDE OF LINE

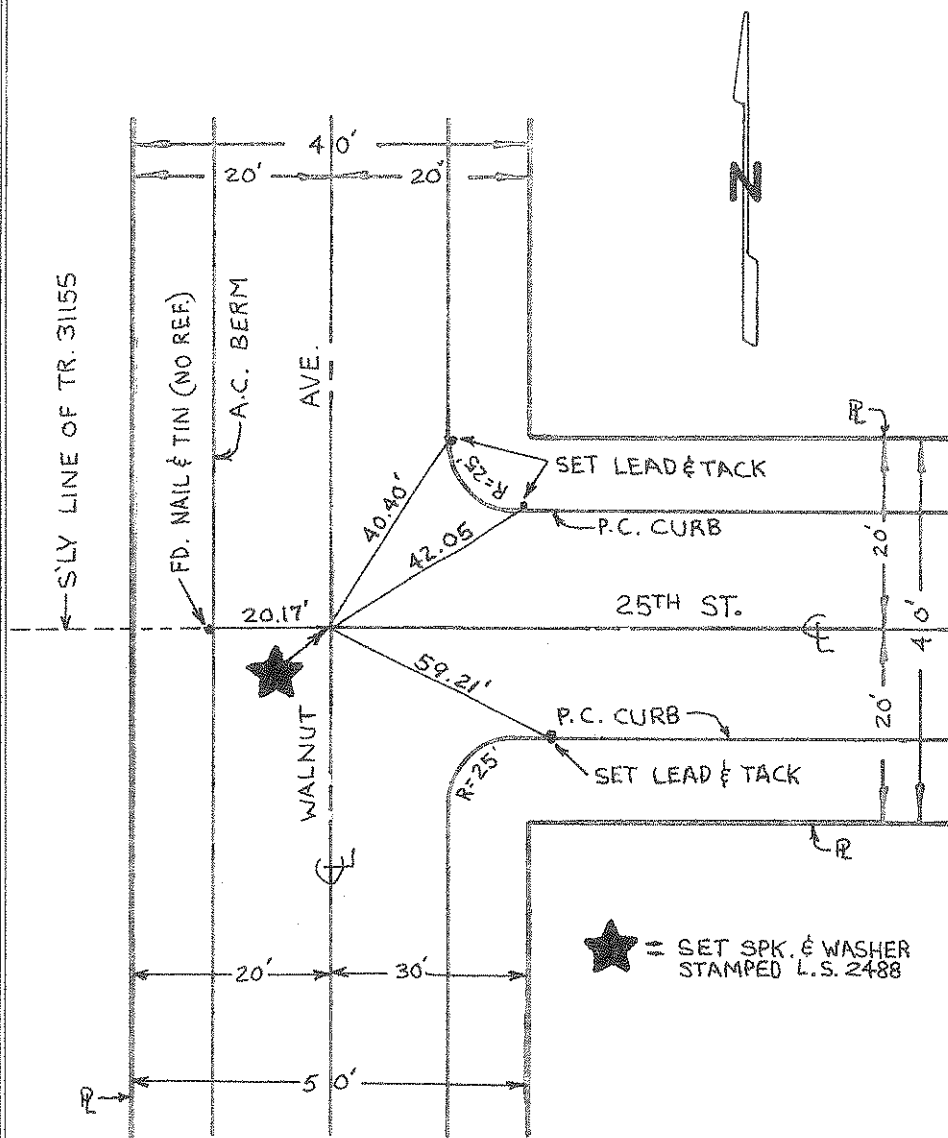

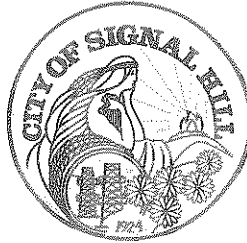


CITY OF SIGNAL HILL

2175 Cherry Avenue Signal Hill, California 90806 (310) 989-7300 FAX (310) 989-7393/7391

SURVEY OF HILL ST. & MOLINO AVE F B NO. PAGE
 R.V. PEARSALL INC. PER C.S.H.
 SURVEY BY SURVEY MARKED PLOTHILL TRACT NO. "PLOTHILL" SURVEY
 DATE APRIL 5, 1981

SURVEYORS SERVICE COMPANY. STA MESA - STOCK NO. 411

DO NOT EXTEND NOTES THIS SIDE OF LINE

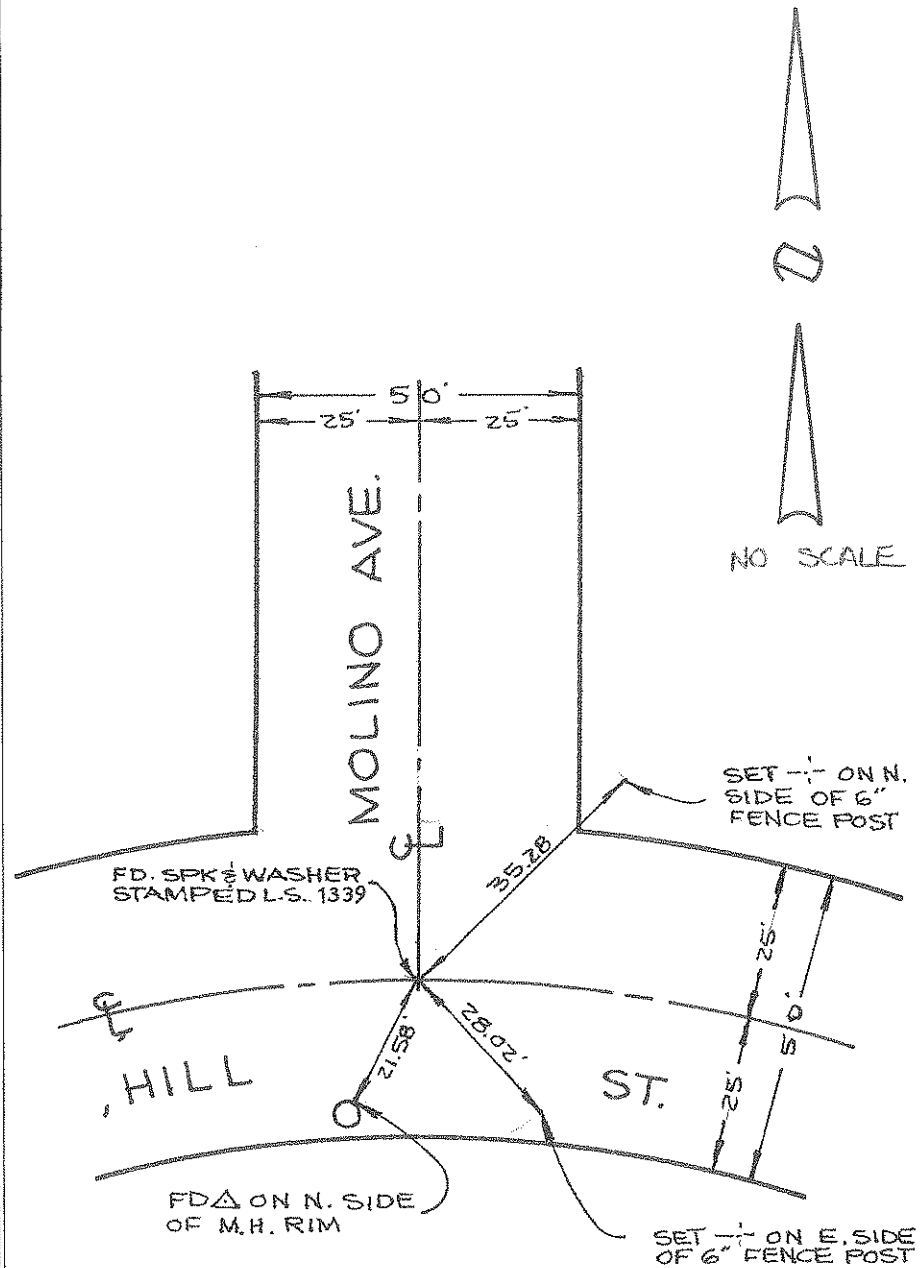




CITY OF SIGNAL HILL

2175 Cherry Avenue Signal Hill, California 90806 (310) 989-7300 FAX (310) 989-7393/7391

SURVEY OF 2 TIES - GAVIOTA AVENUE F. B. _____ Pg. _____
SURVEY BY _____ TR. No. _____
DATE 3/1/76


SO. CALIF. BLUE PRINT CO. -

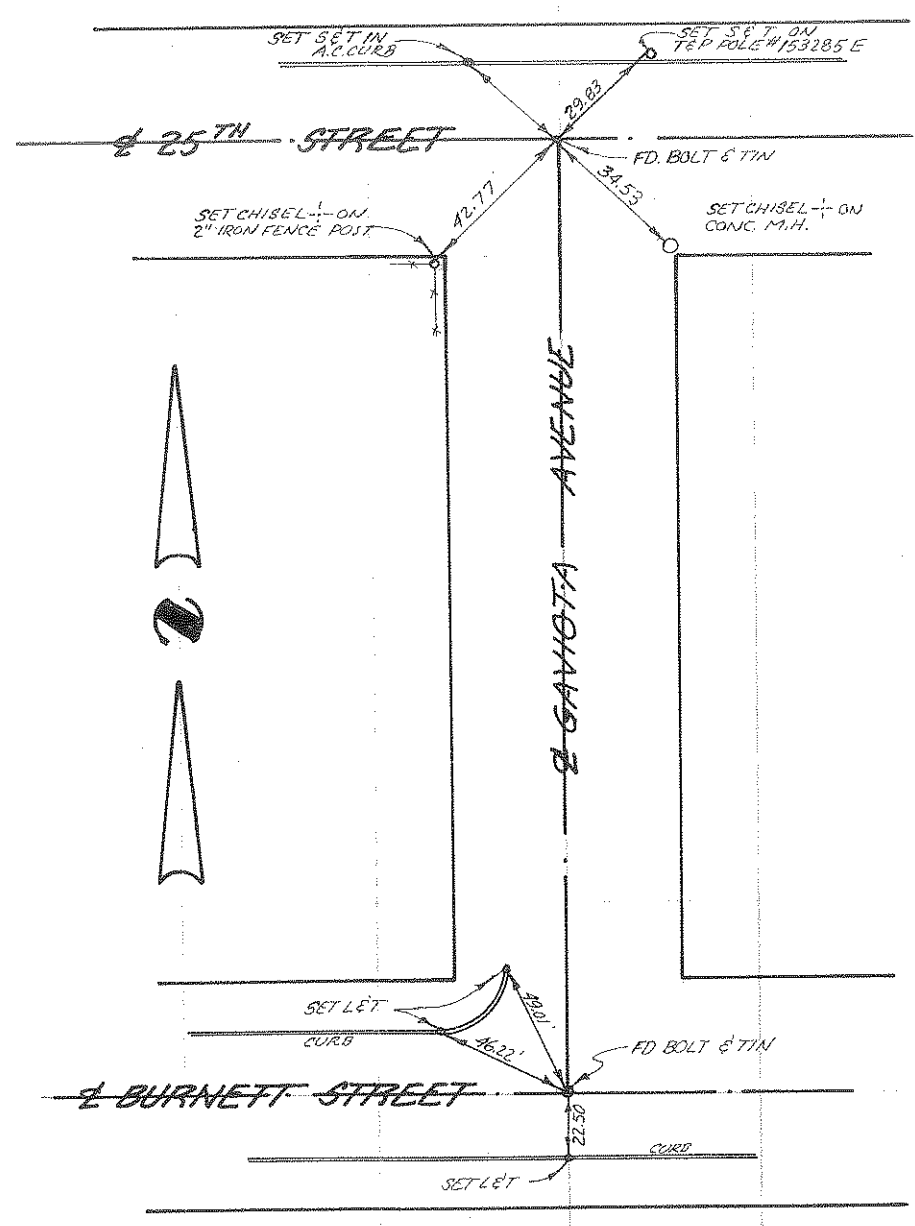




CITY OF SIGNAL HILL

2175 Cherry Avenue · Signal Hill, California 90806 · (310) 989-7300 · FAX (310) 989-7393/7391

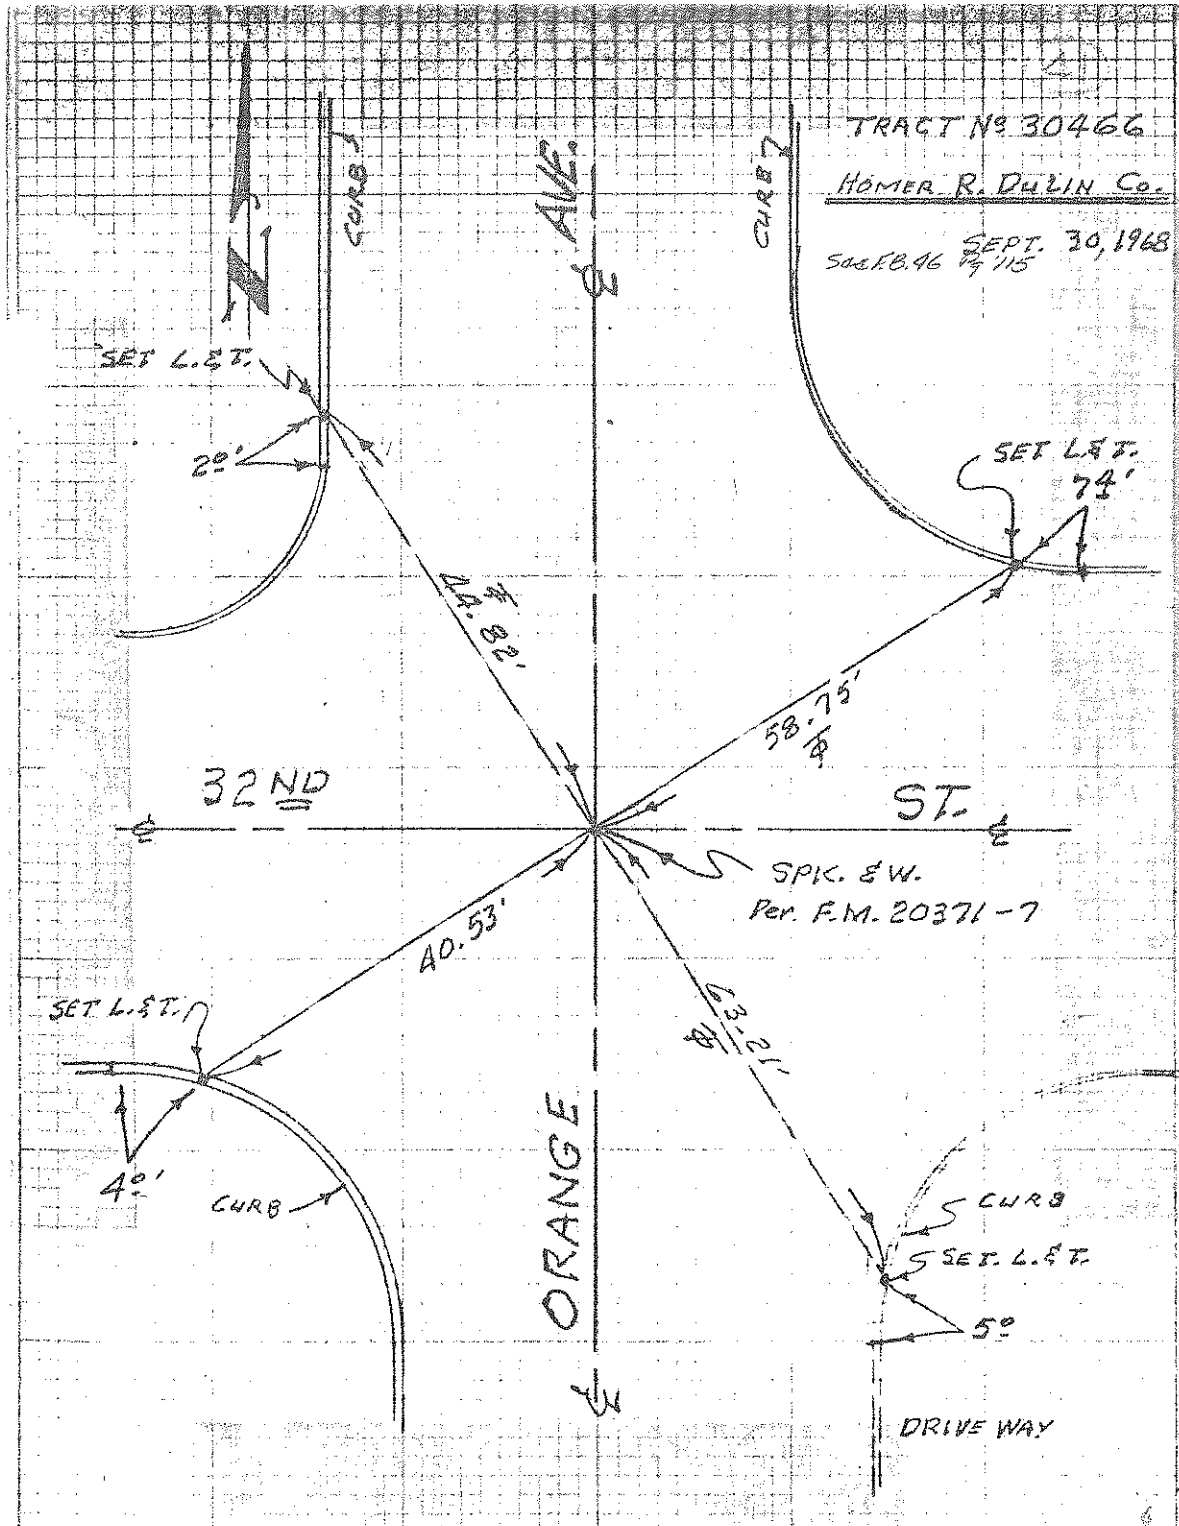

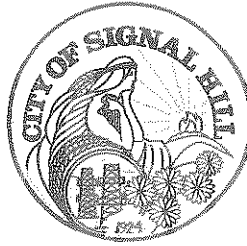


CITY OF SIGNAL HILL


2175 Cherry Avenue Signal Hill, California 90806 (310) 989-7300 FAX (310) 989-7393/7391

SURVEY OF ℄ HILL ST. & TEMPLE AV. F B NO. _____ PAGE _____
SURVEY BY R.V. PEARSALL INC. P.M. 14912
DATE 1-25-82

SURVEYORS SERVICE COMPANY NSTA MESA - STOCK NO. 411

DO NOT EXTEND NOTES THIS SIDE OF LINE

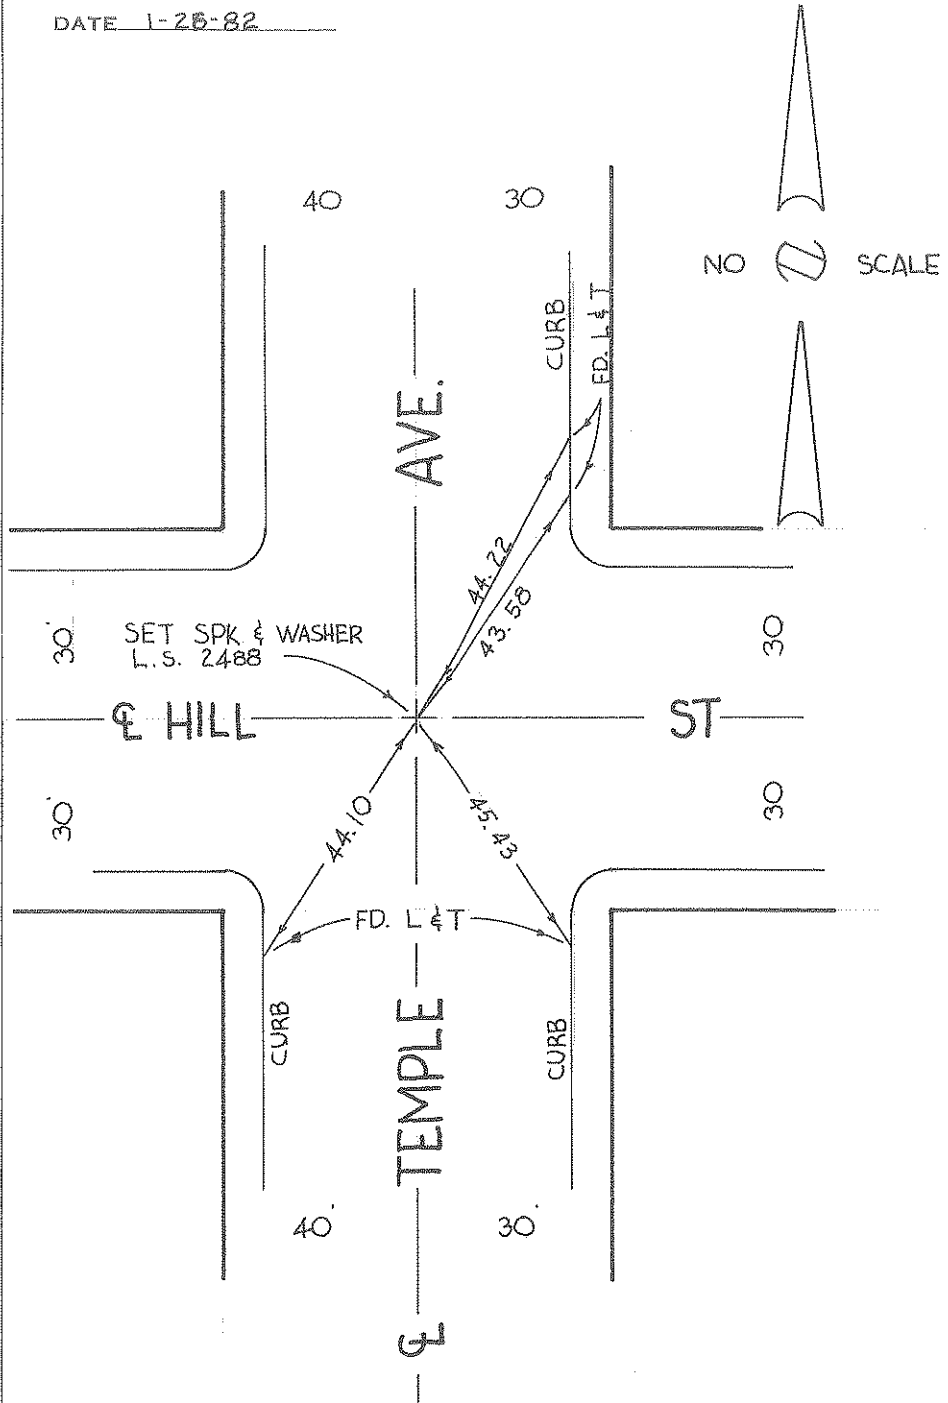

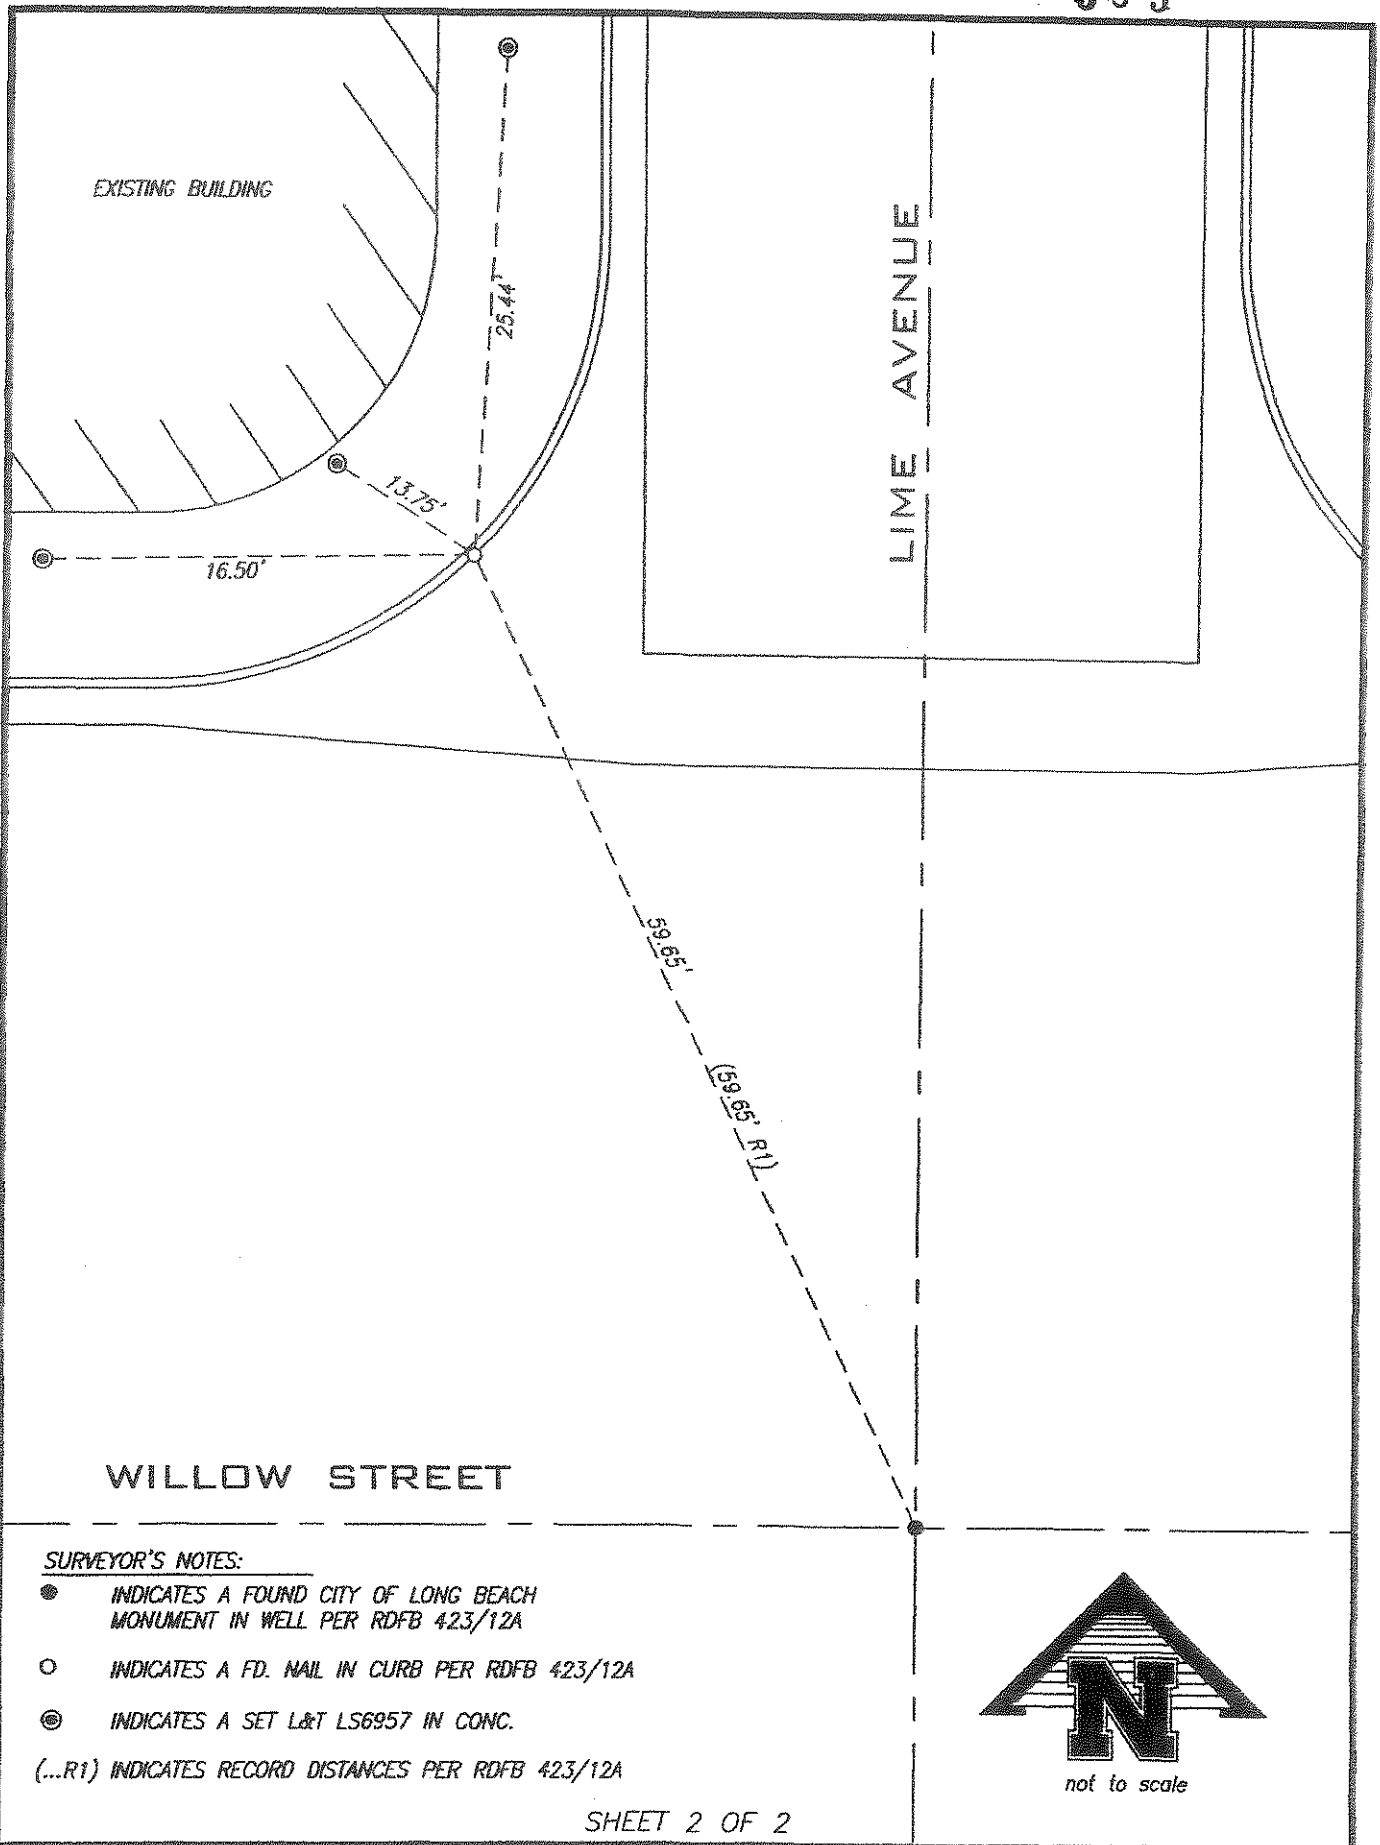

Line 1070

40

2013

99
+

S'walk

2000

1-5-4

12

15.51

2

100

10

0+88.2

+ 36.6


10

7540
7540

259.95

43.

olive ave

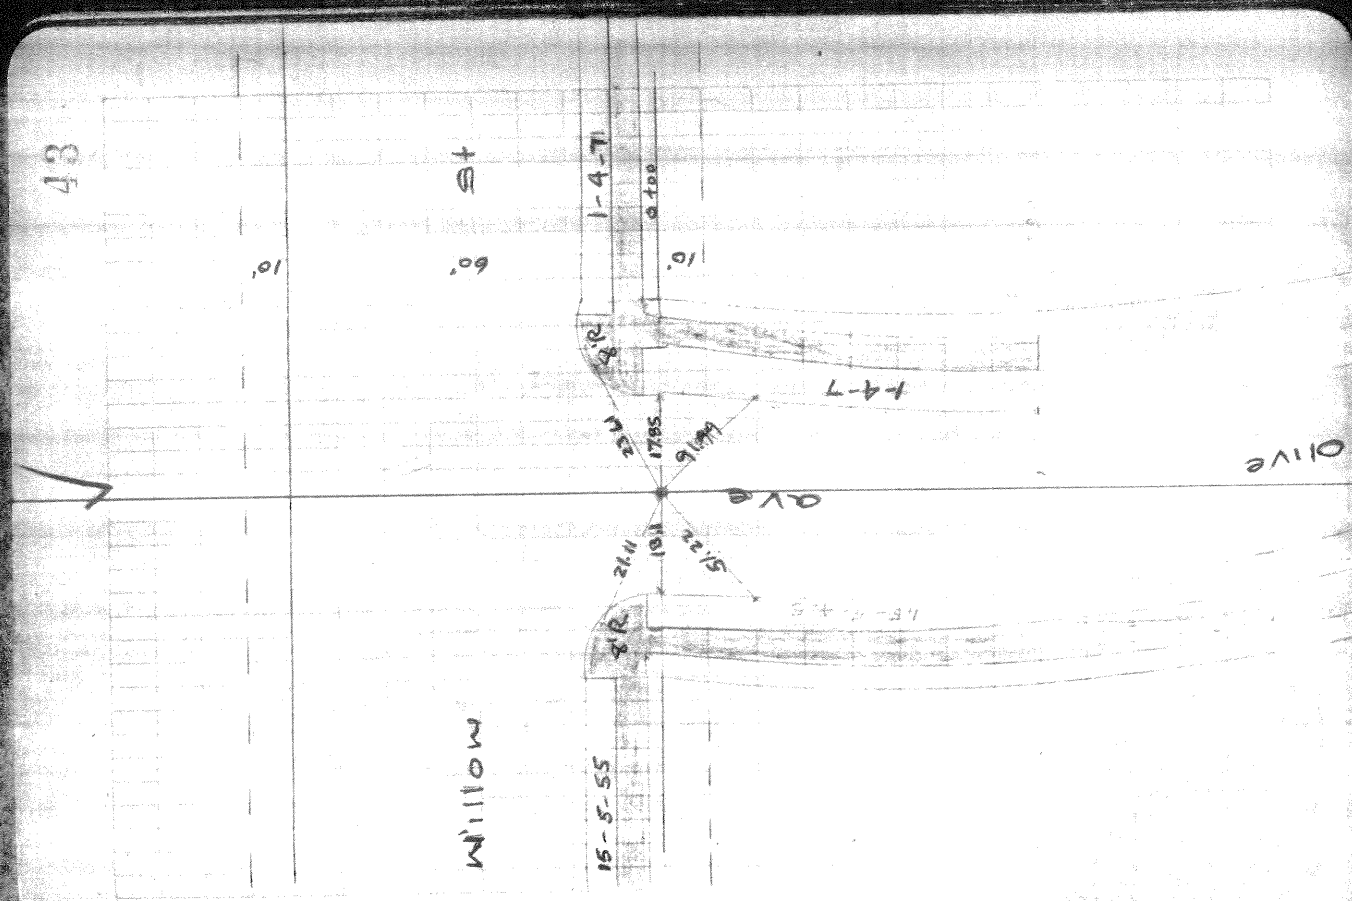




CITY OF SIGNAL HILL

2175 Cherry Avenue Signal Hill, California 90806 (310) 989-7300 FAX (310) 989-7393/7391

SURVEY OF D-58 F B NO. 2 PAGE
SURVEY BY _____ TRACT NO. _____
DATE 6-75

SURVEYORS SERVICE COMPANY, COSTA MESA - STOCK NO. 411

DO NOT EXTEND NOTES THIS SIDE OF LINE

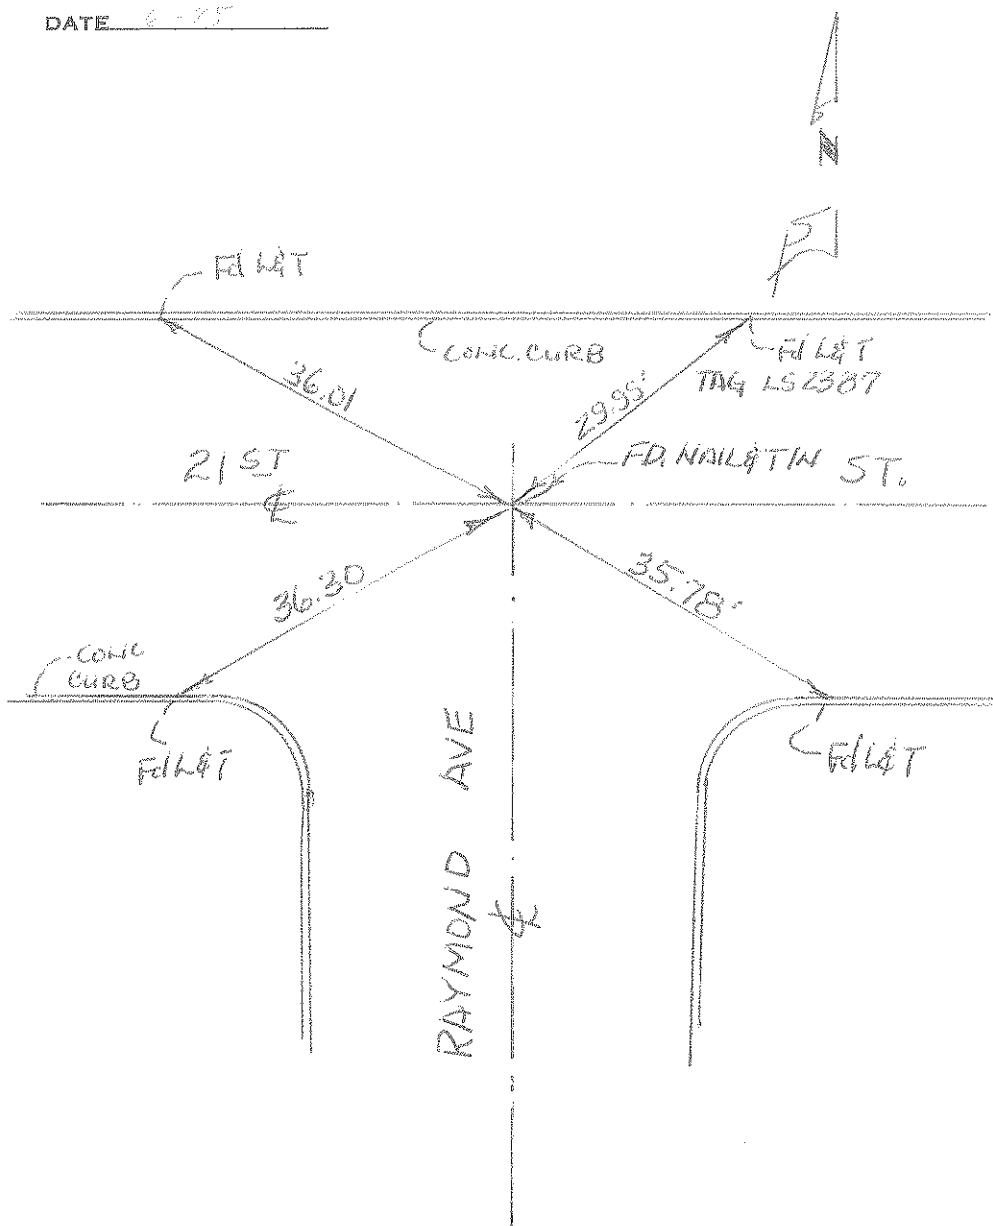





CITY OF SIGNAL HILL

2175 Cherry Avenue Signal Hill, California 90806 (310) 989-7300 FAX (310) 989-7393/7391

SURVEY OF TIE SHT. & GRANT ST. & OBISPO F. B. Pg. 60F6
SURVEY BY JAY THIENES TR. No. 42199
DATE 10-14-81

80. CALIF. BLUE PRINT CO. -

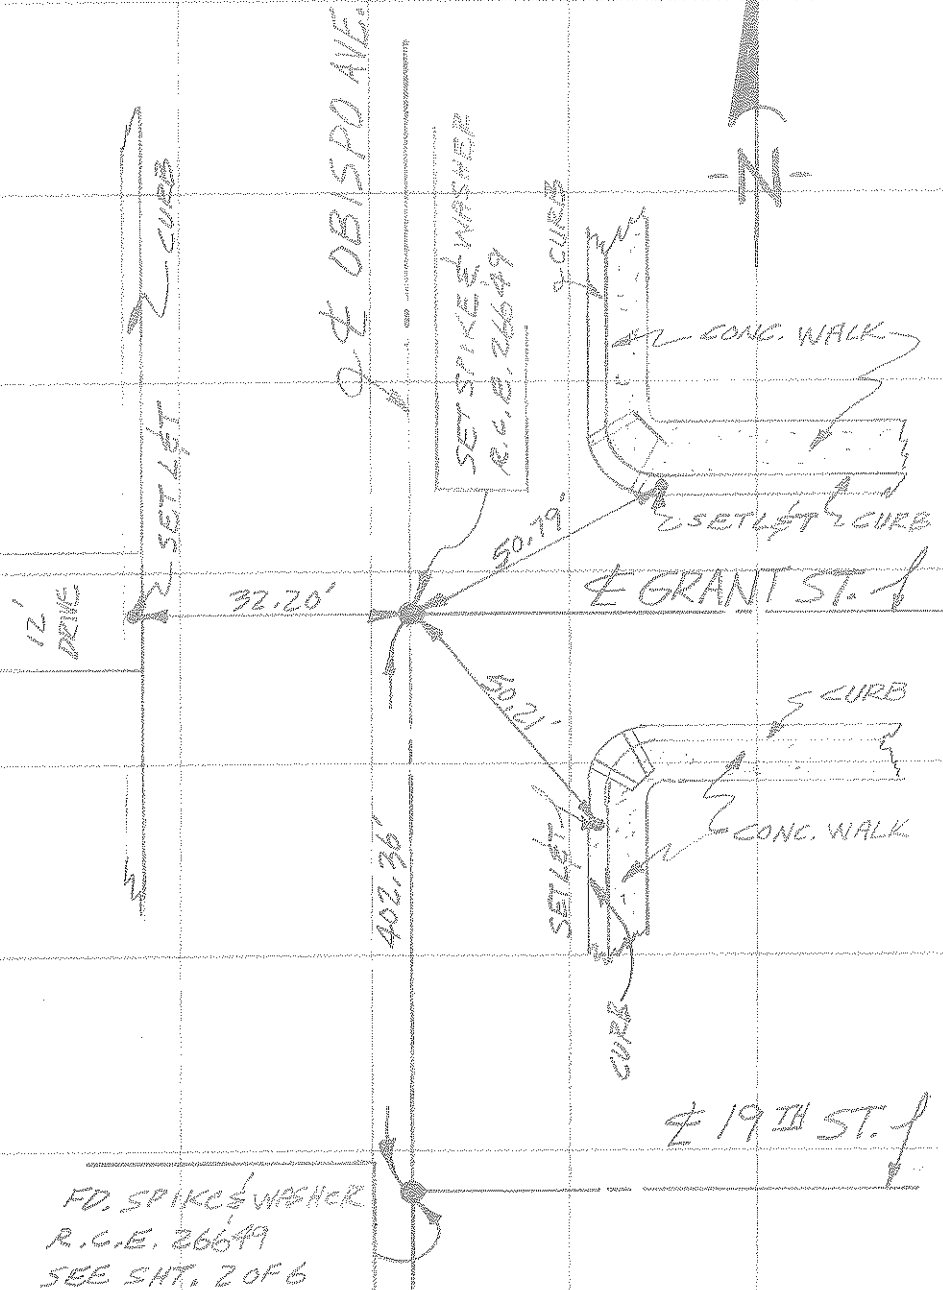

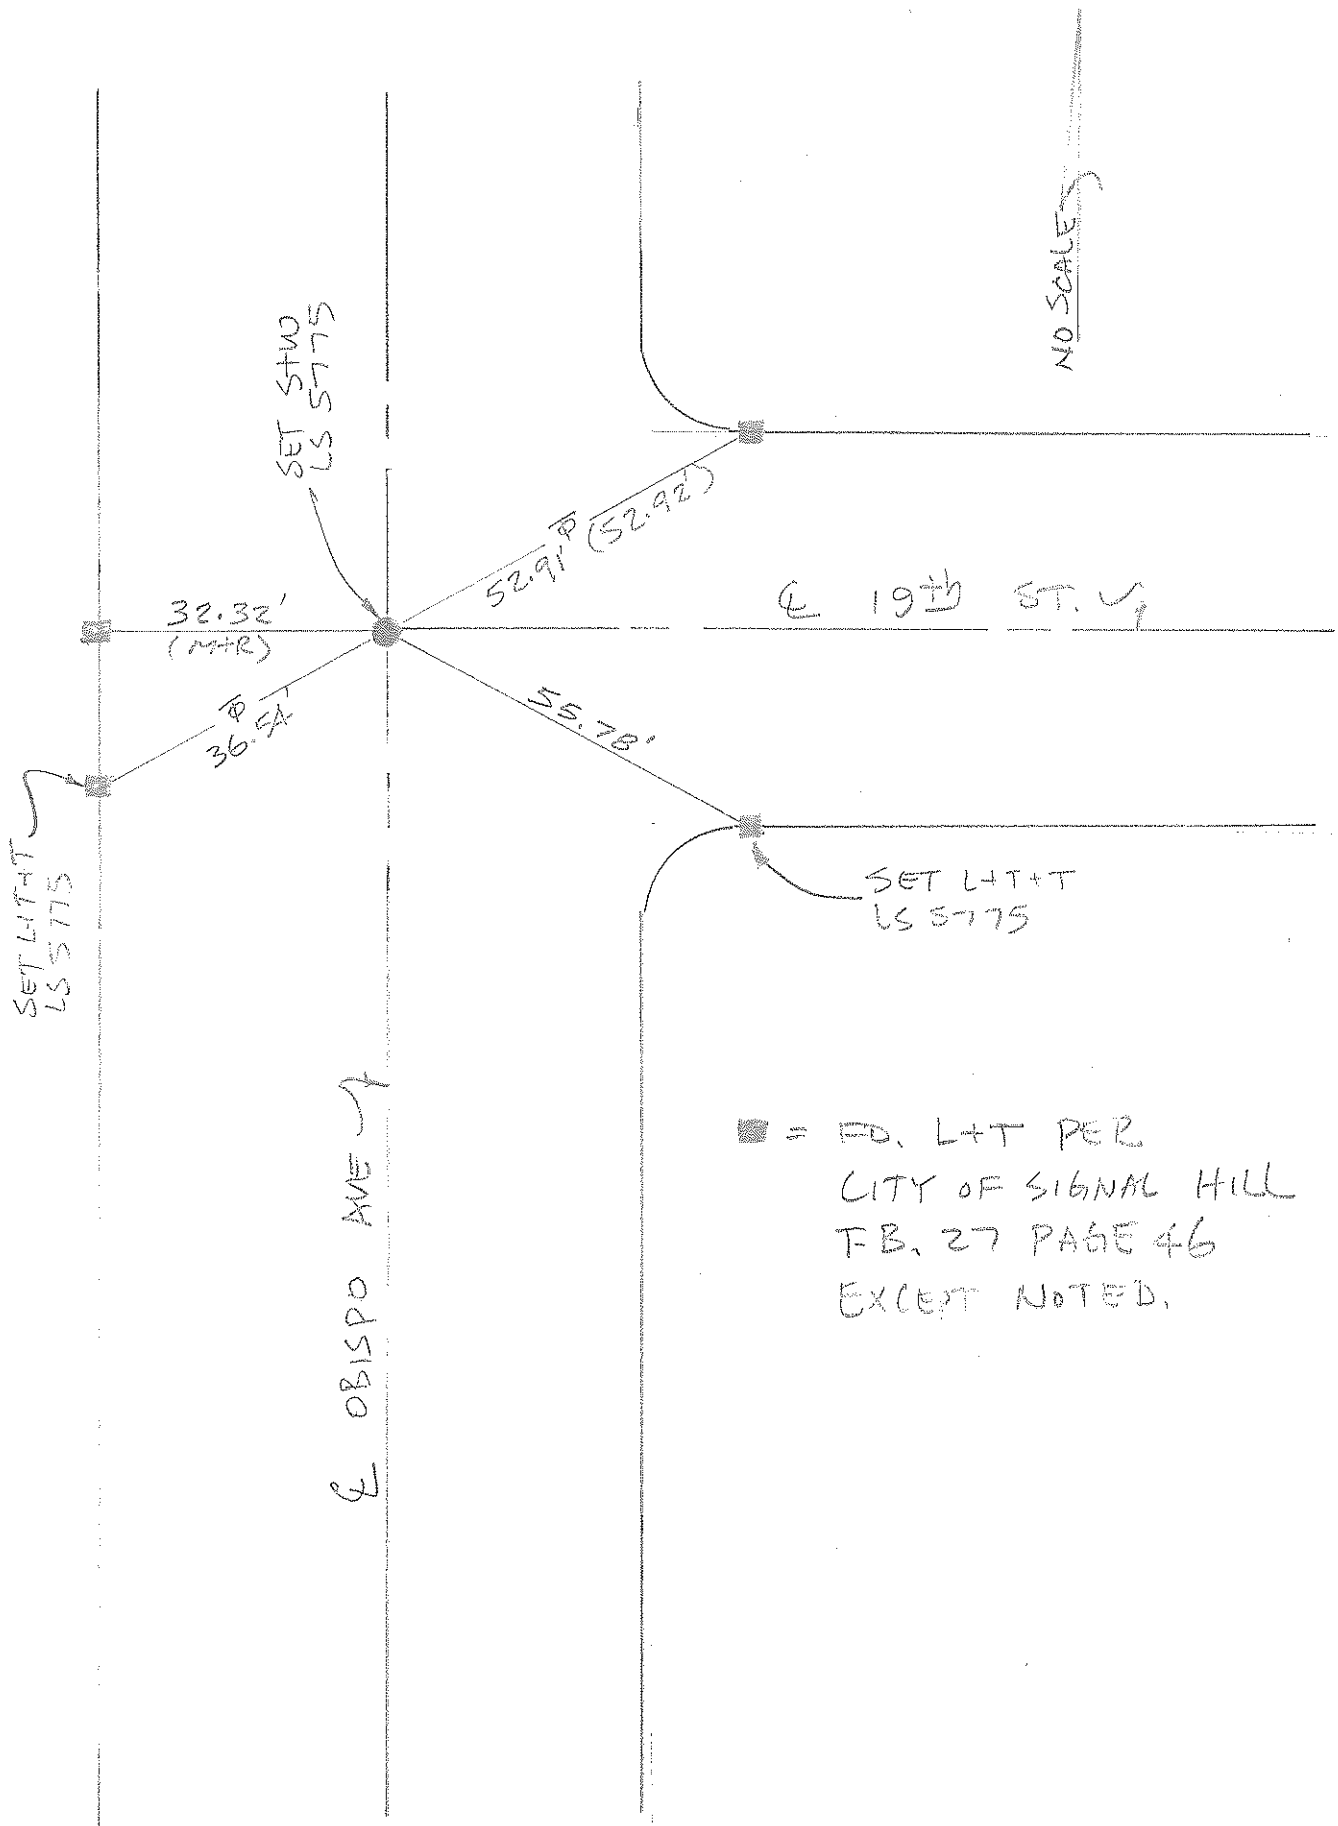


CORNER RECORD

City of SIGNAL HILL

Document Number _____

County of Los Angeles, California

Brief Legal Description CENTER LINE TIES @ OBISPO AVE & 19TH ST.

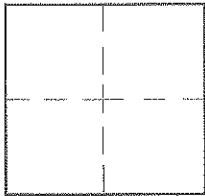

CORNER TYPE

Govt. Corner ☐ Control ☒
Meander ☐ Property ☐
Rancho ☐ Other ☐
Date of Survey 12/2011

COORDINATES (Optional)

N. _____
E. _____
Zone _____ NAD27 ☐ NAD83 ☐
NAD83 Epoch _____
Elev. _____
Vert. Datum: NGVD29 ☐ NAVD88 ☐
Meas. Units: Metric ☐ Imperial ☐

Corner - Left as found ☒ Found & tagged ☐ Established ☐ Reestablished ☒ Rebuilt ☐

Identification and type of corner found: Evidence used to identify or procedure used to establish or reestablish the corner:

SEE SKETCH

A description of the physical condition of the monument as found and as set or reset:

SEE SKETCH

SURVEYOR'S STATEMENT

This Corner Record was prepared by me or under my direction in conformance

with the Land Surveyors' Act on DEC 2011

Signed [Signature] P.L.S. or R.C.E. No. 5775



COUNTY SURVEYOR'S STATEMENT

This Corner Record was received _____

and examined and filed _____

Signed _____ P.L.S. or R.C.E. No. _____

Title: _____

County Surveyor's Comment _____




CITY OF SIGNAL HILL


2175 Cherry Avenue Signal Hill, California 90806 (310) 989-7300 FAX (310) 989-7393/7391

SURVEY OF 2 TIES HT 19TH ST & OBISPO F. B. _____ Pg. 20F6
 SURVEY BY JAY THIENES TR. No. 42199
 DATE 10-14-81

& GRANT ST.

SO. CALIF. BLUE PRINT CO. -

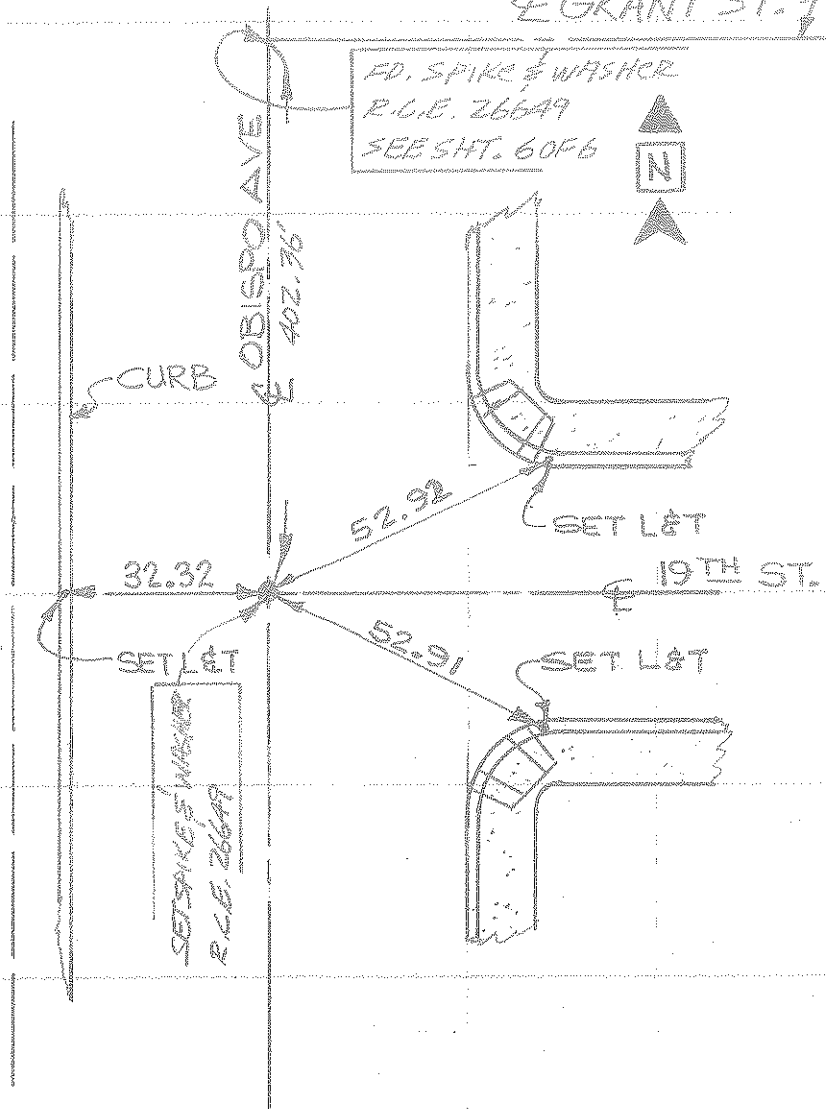

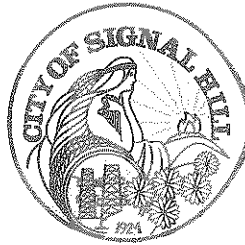

CITY OF SIGNAL HILL


2175 Cherry Avenue Signal Hill, California 90806 (310) 989-7300 FAX (310) 989-7393/7391

SURVEY OF 6 TIES 23RD ST. & RAYMOND F. B. _____ Pg. _____
 SURVEY BY _____ TR. No. _____
 DATE _____

SO. CALIF. BLUE PRINT CO. -

RAYMOND AVE.

N
 NO SCALE

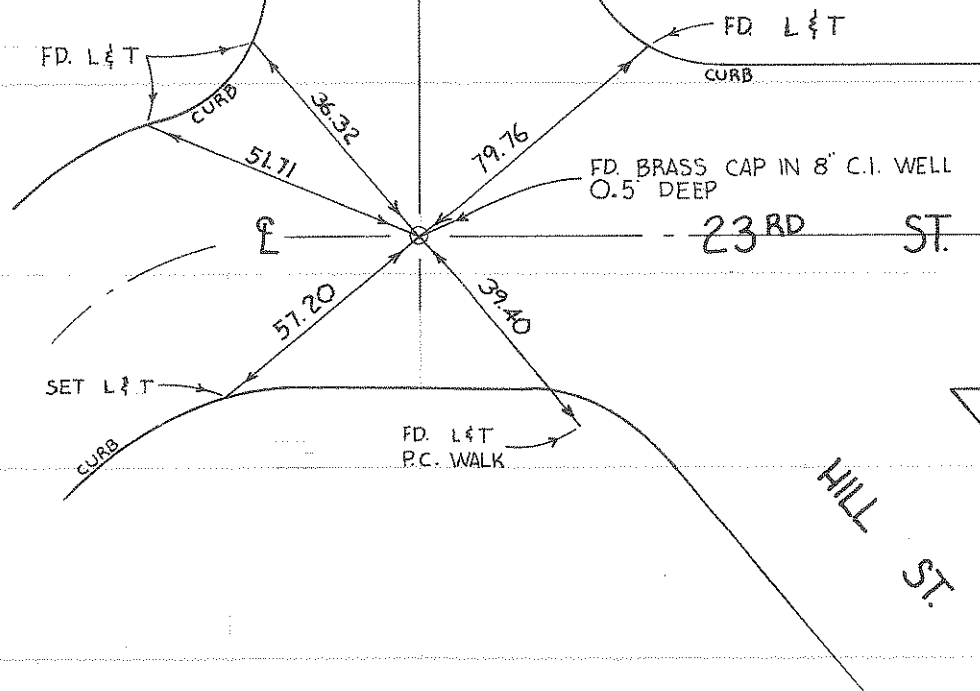




CITY OF SIGNAL HILL

2175 Cherry Avenue · Signal Hill, California 90806 (310) 989-7300 FAX (310) 989-7393/7391

SURVEY OF 6 TIES 23RD & JUNIPERO F. B. _____ Pg. _____
SURVEY BY _____ TR. No. _____
DATE _____

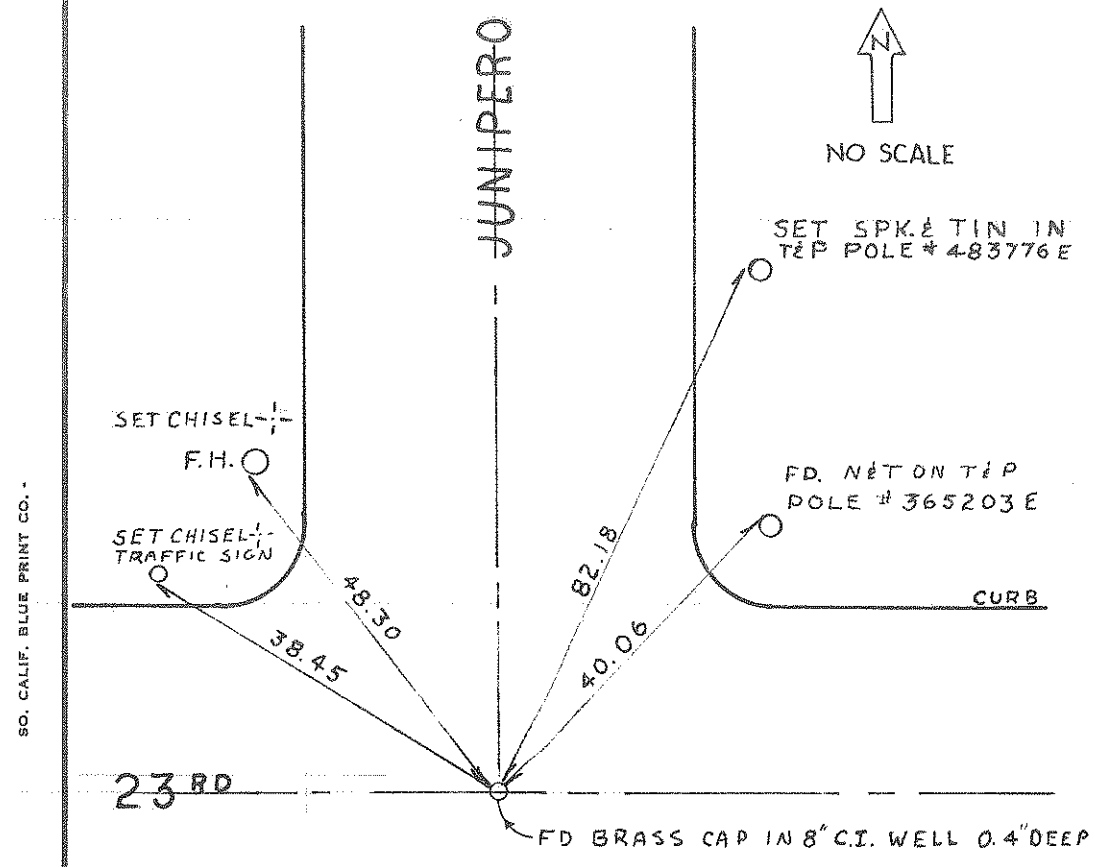



CITY OF SIGNAL HILL

2175 Cherry Avenue · Signal Hill, California 90806 · (310) 989-7300 · FAX (310) 989-7393/7391

SURVEY OF 4 TIES 23RD ST & OHIO F. B. 2 Pg. 155
SURVEY BY R.V. PEARSALL INC. L.S. 1339
DATE 12/1/76 TR. No. 32859

SO. CALIF. BLUE PRINT CO. -

