




CITY OF SIGNAL HILL

2175 Cherry Avenue Signal Hill, California 90806 (310) 989-7300 FAX (310) 989-7393/7391

SURVEY OF TIE SHT 19TH & REDONDO F. B. _____ Pg. 10 of 6
 SURVEY BY JAY THIENES TR. No. 42199
 DATE 10-14-81

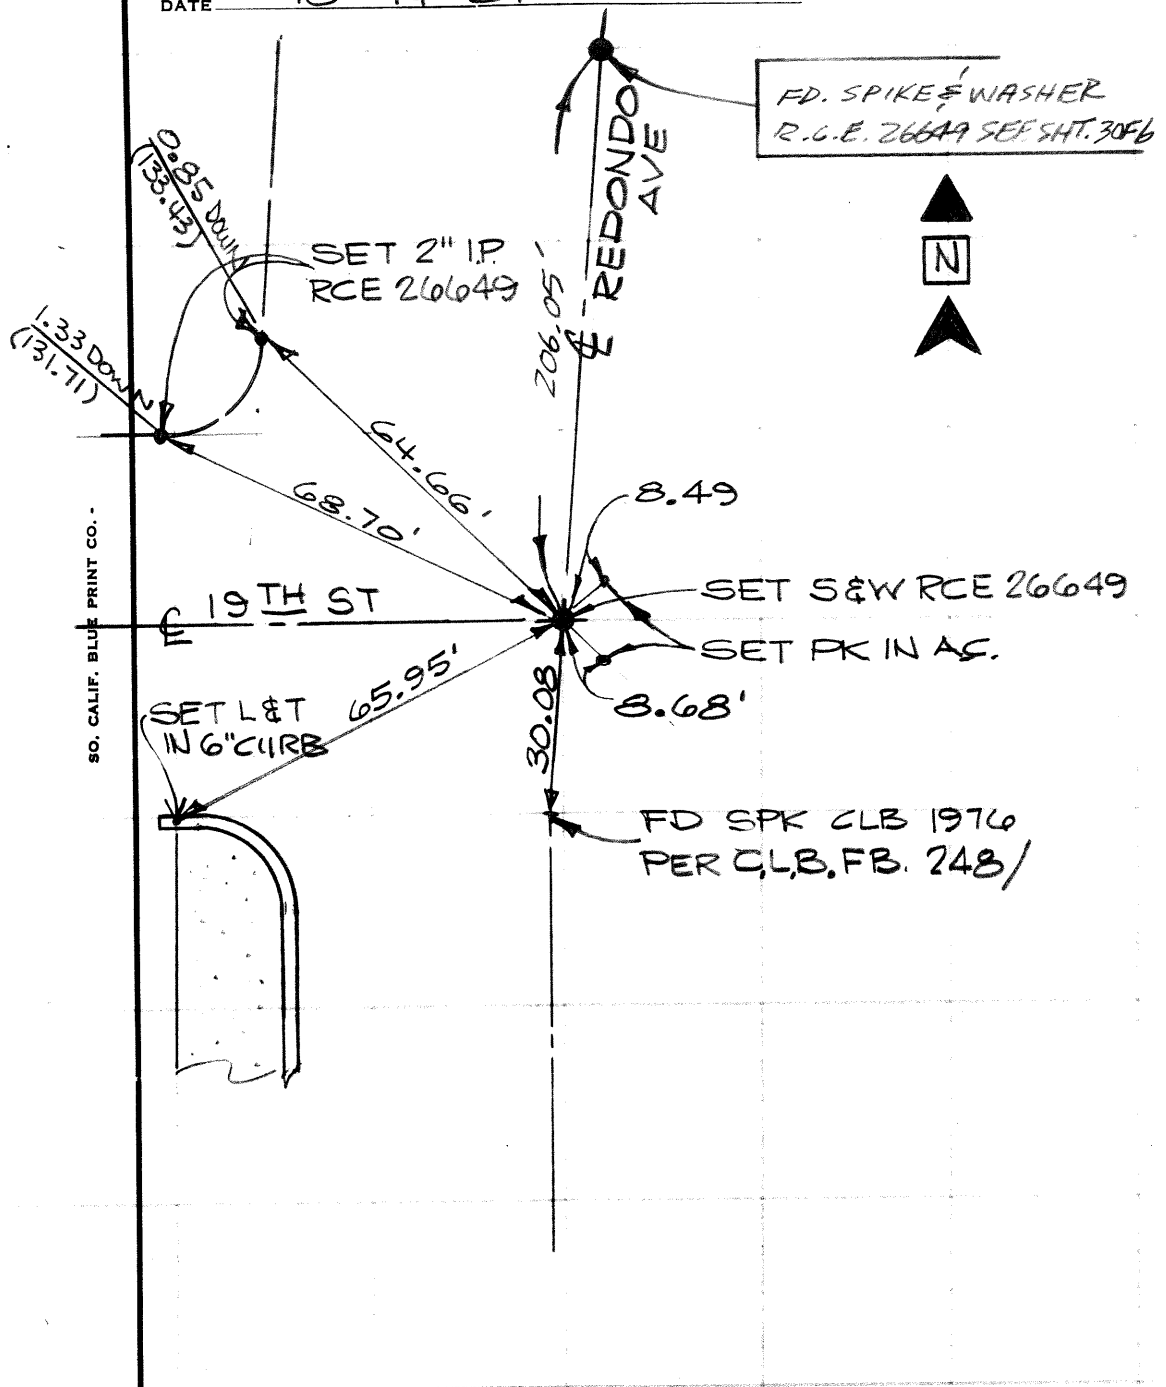




CITY OF SIGNAL HILL

2175 Cherry Avenue Signal Hill, California 90806 (310) 989-7300 FAX (310) 989-7393/7391

SURVEY OF TIE SHT. R & REDONDO AVE. F. B. _____ Pg. 30F6
 SURVEY BY JAY THIENES TR. No. 42199
 DATE 10-14-81


SO. CALIF. BLUE PRINT CO. -

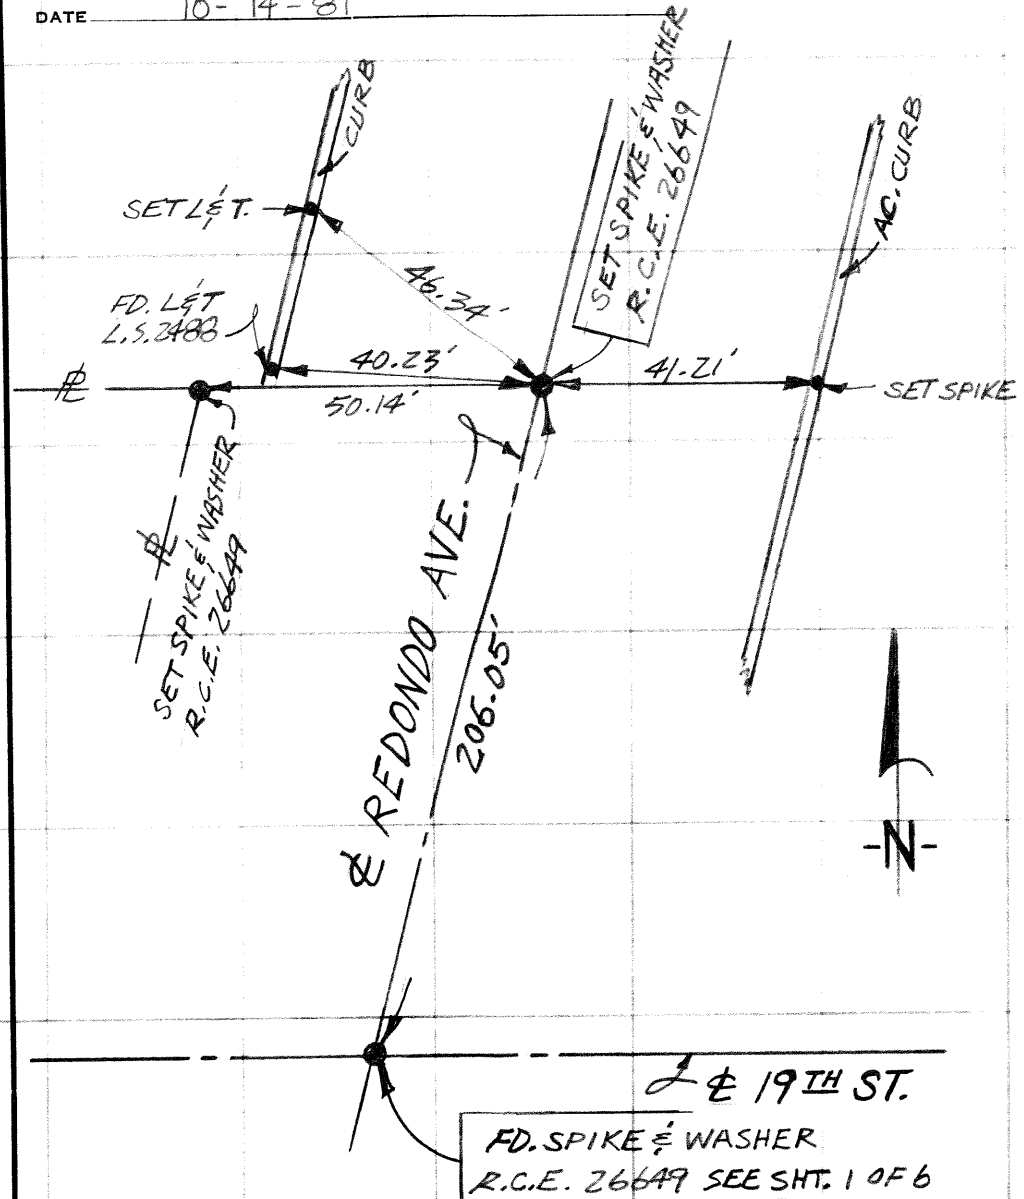



CITY OF SIGNAL HILL

2175 Cherry Avenue Signal Hill, California 90806 (310) 989-7300 FAX (310) 989-7393/7391

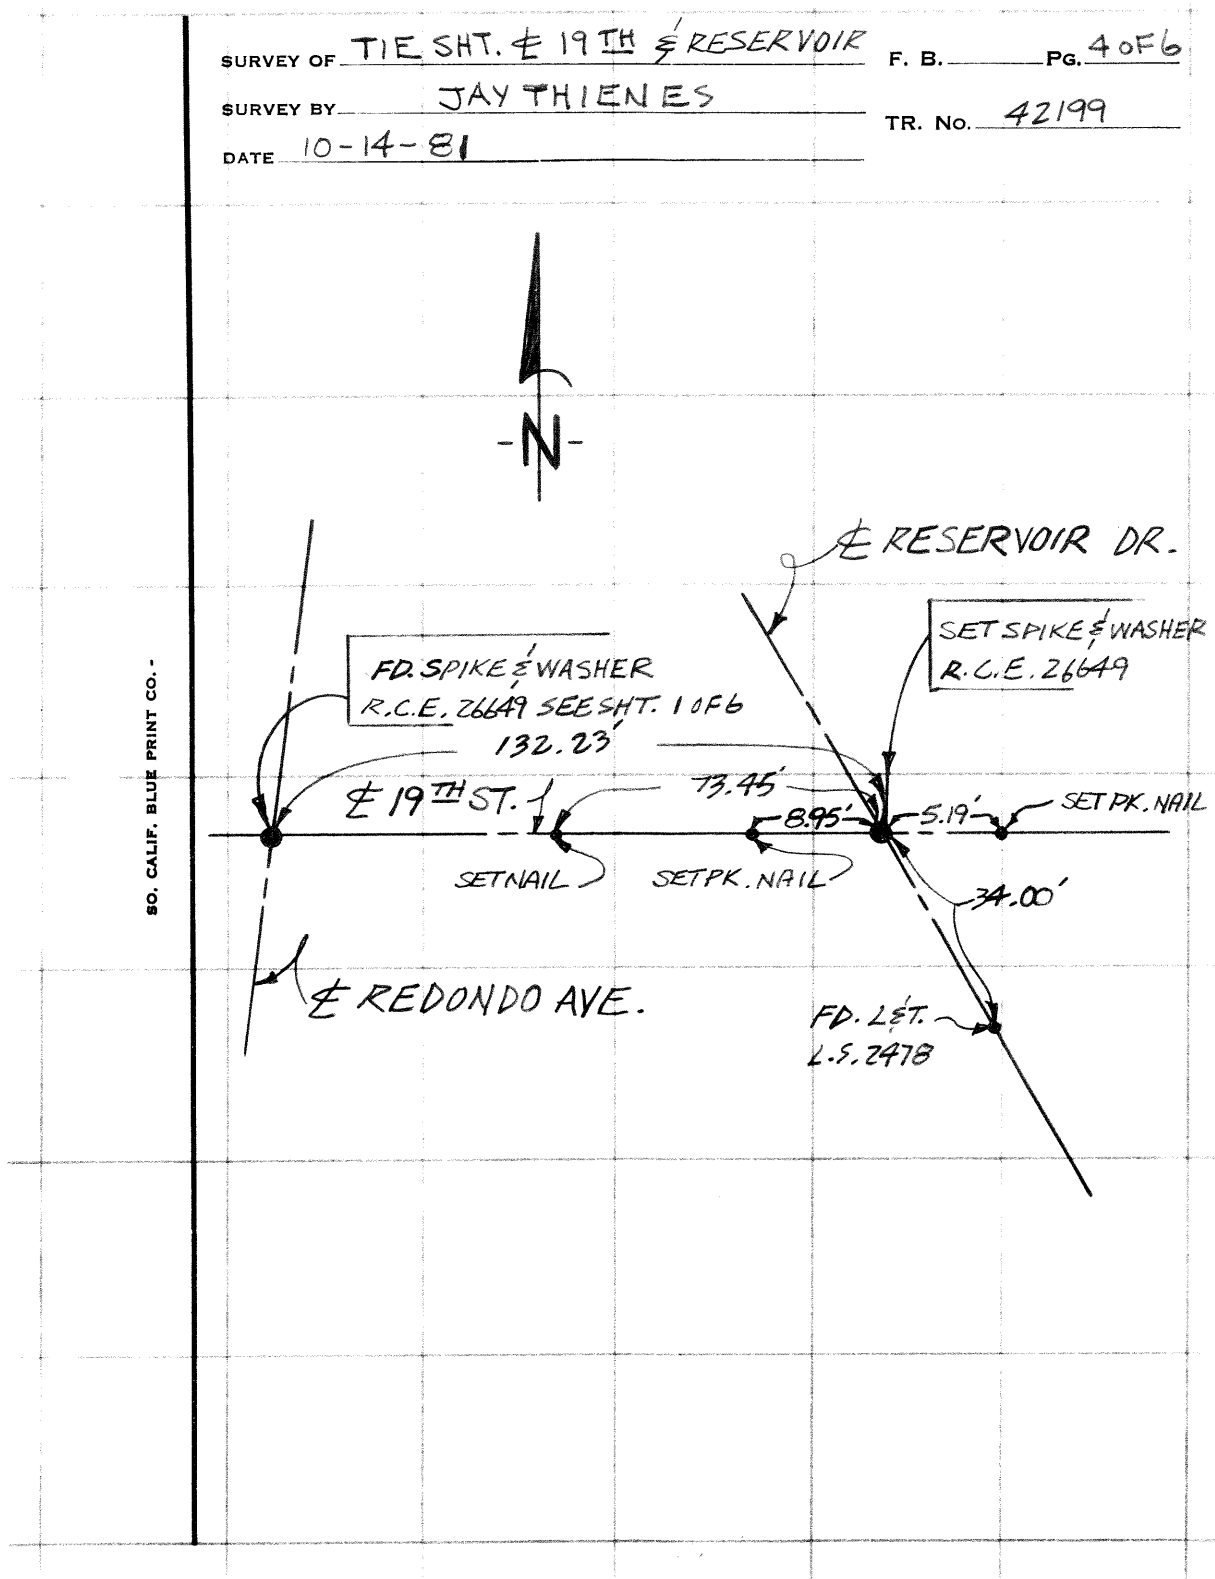




CITY OF SIGNAL HILL

2175 Cherry Avenue Signal Hill, California 90806 (310) 989-7300 FAX (310) 989-7393/7391

SURVEY OF TIE SHT. & 19TH ST. F. B. 50F6
 SURVEY BY JAY THIENES TR. No. 42199
 DATE 10-14-81

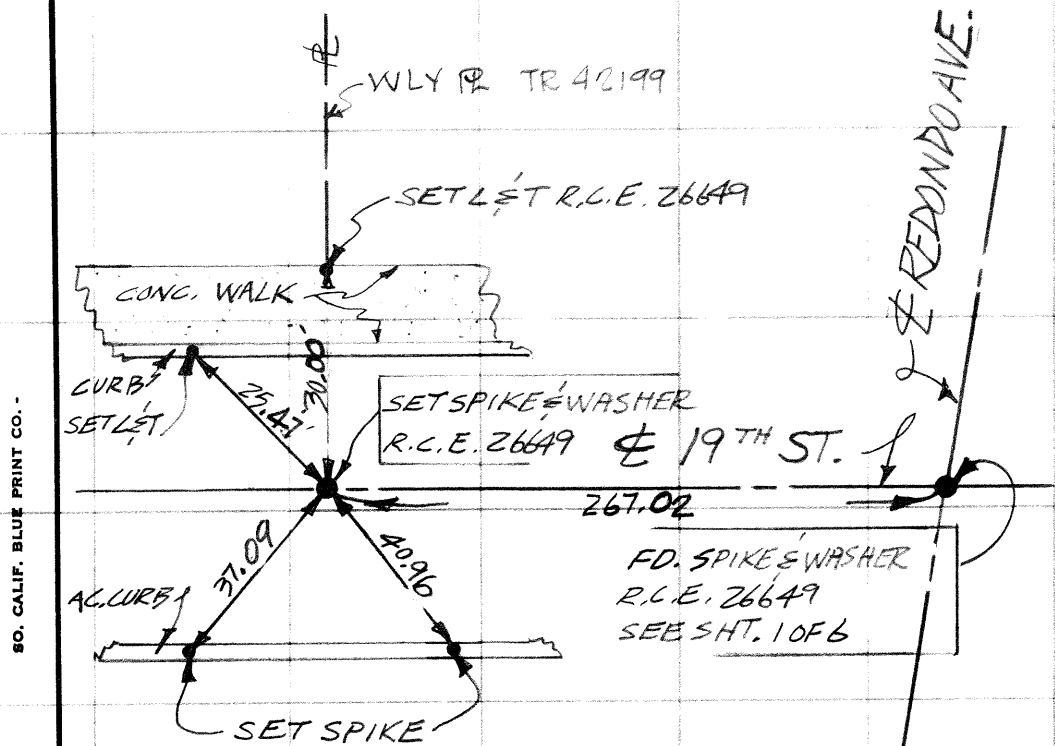


SURVEY OF CITY OF SIGNAL HILL
SURVEYED BY KENDALL, TENNEY

BOOK 52
JOB NO. 4562 BOOK C
DATE 8-4-89

Robert Bein, William Frost & Associates

PROFESSIONAL ENGINEERS, PLANNERS & SURVEYORS
74-410 HIGHWAY 111 • PALM DESERT, CA 92260
(619) 346-7481 • FAX (619) 346-8315

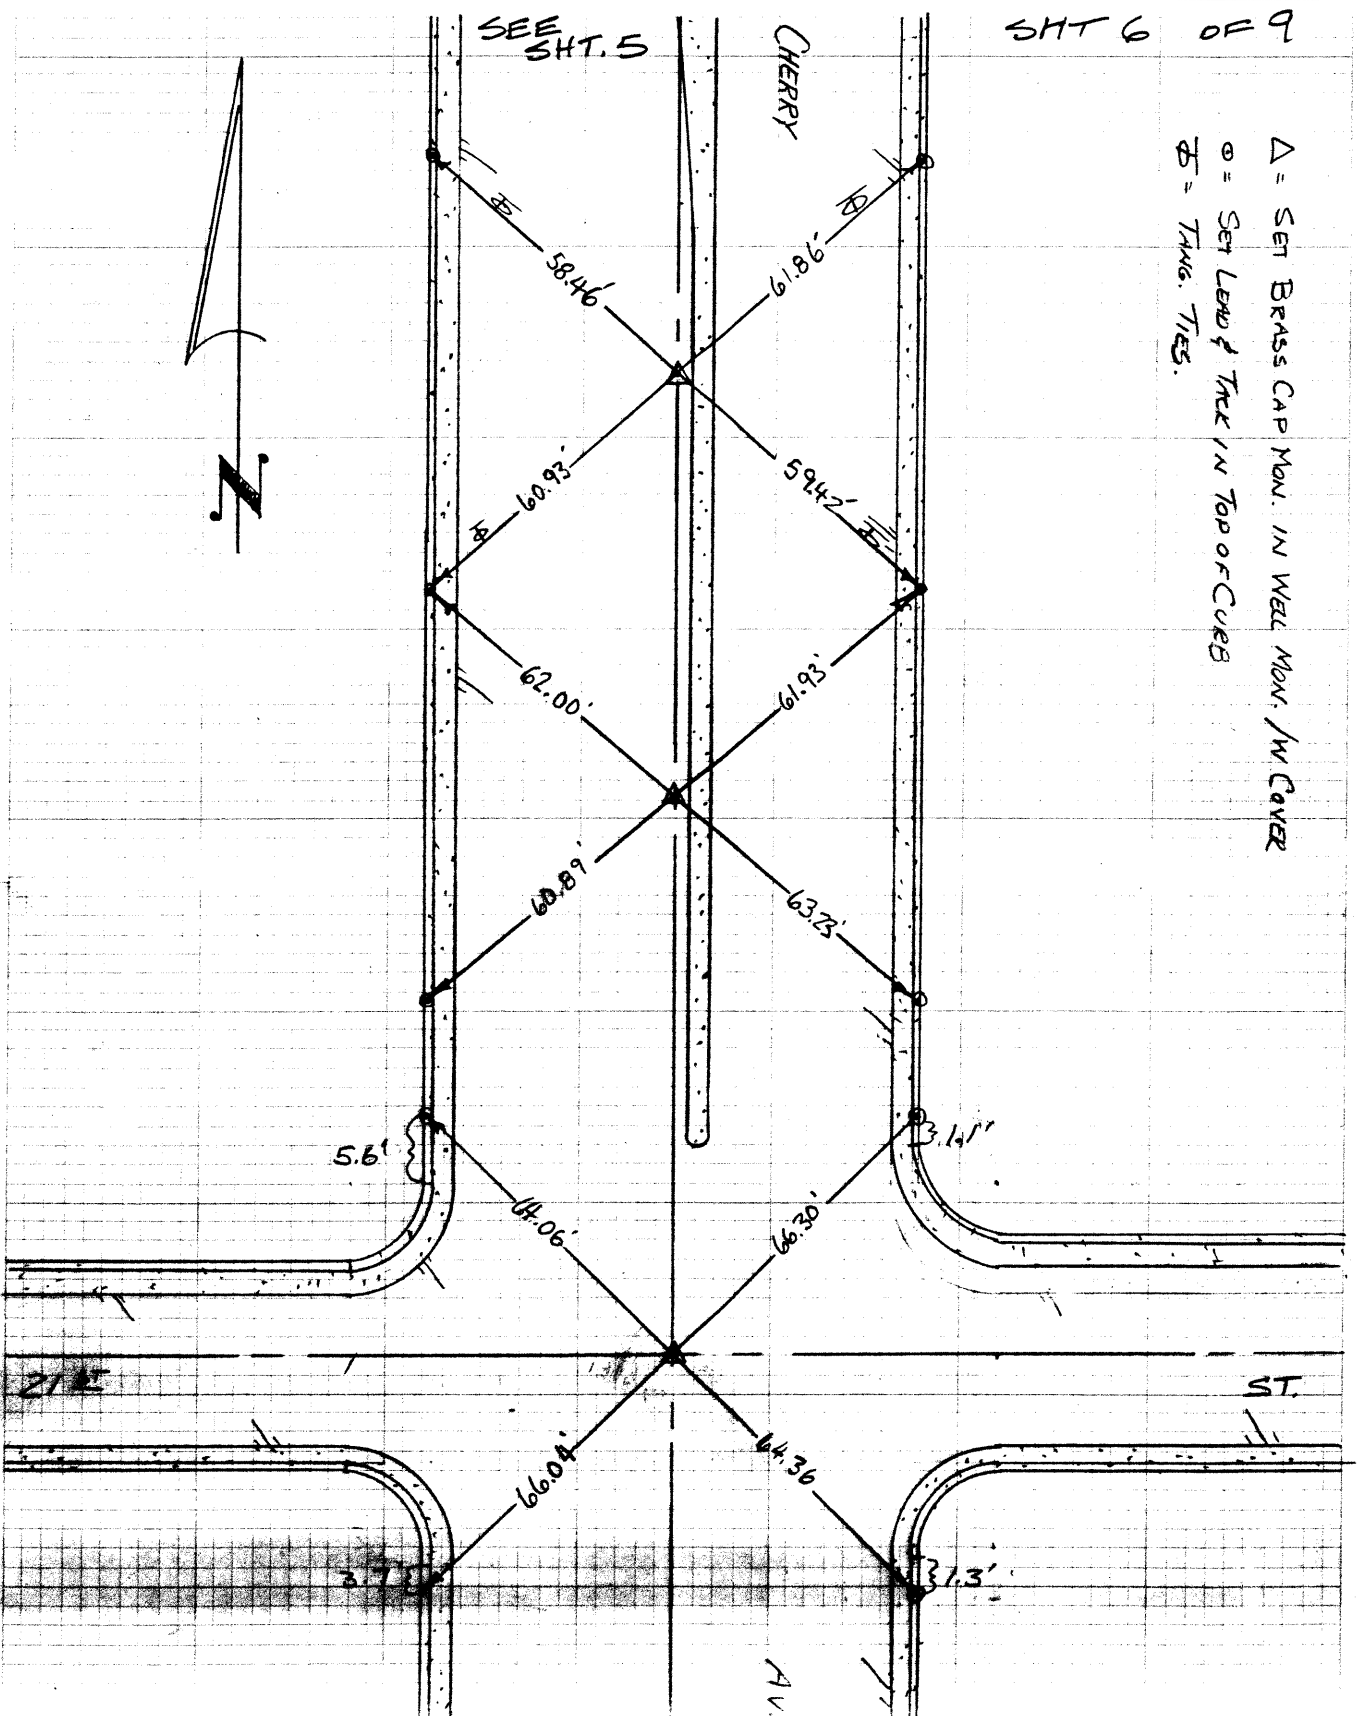

SURVEY OF CHERRY AVE

JOB NO. 24362 BOOK _____

Book

53

SURVEYED BY SMITH, ROCKWELL,
RODRIGUEZ


DATE 7-19-89


Robert Bein, William Frost & Associates

PROFESSIONAL ENGINEERS, PLANNERS & SURVEYORS
P.O. BOX 19739 • 14725 ALTON PARKWAY • IRVINE, CA 92718
(714) 472-3505

& TIES

SHT 1 OF 9

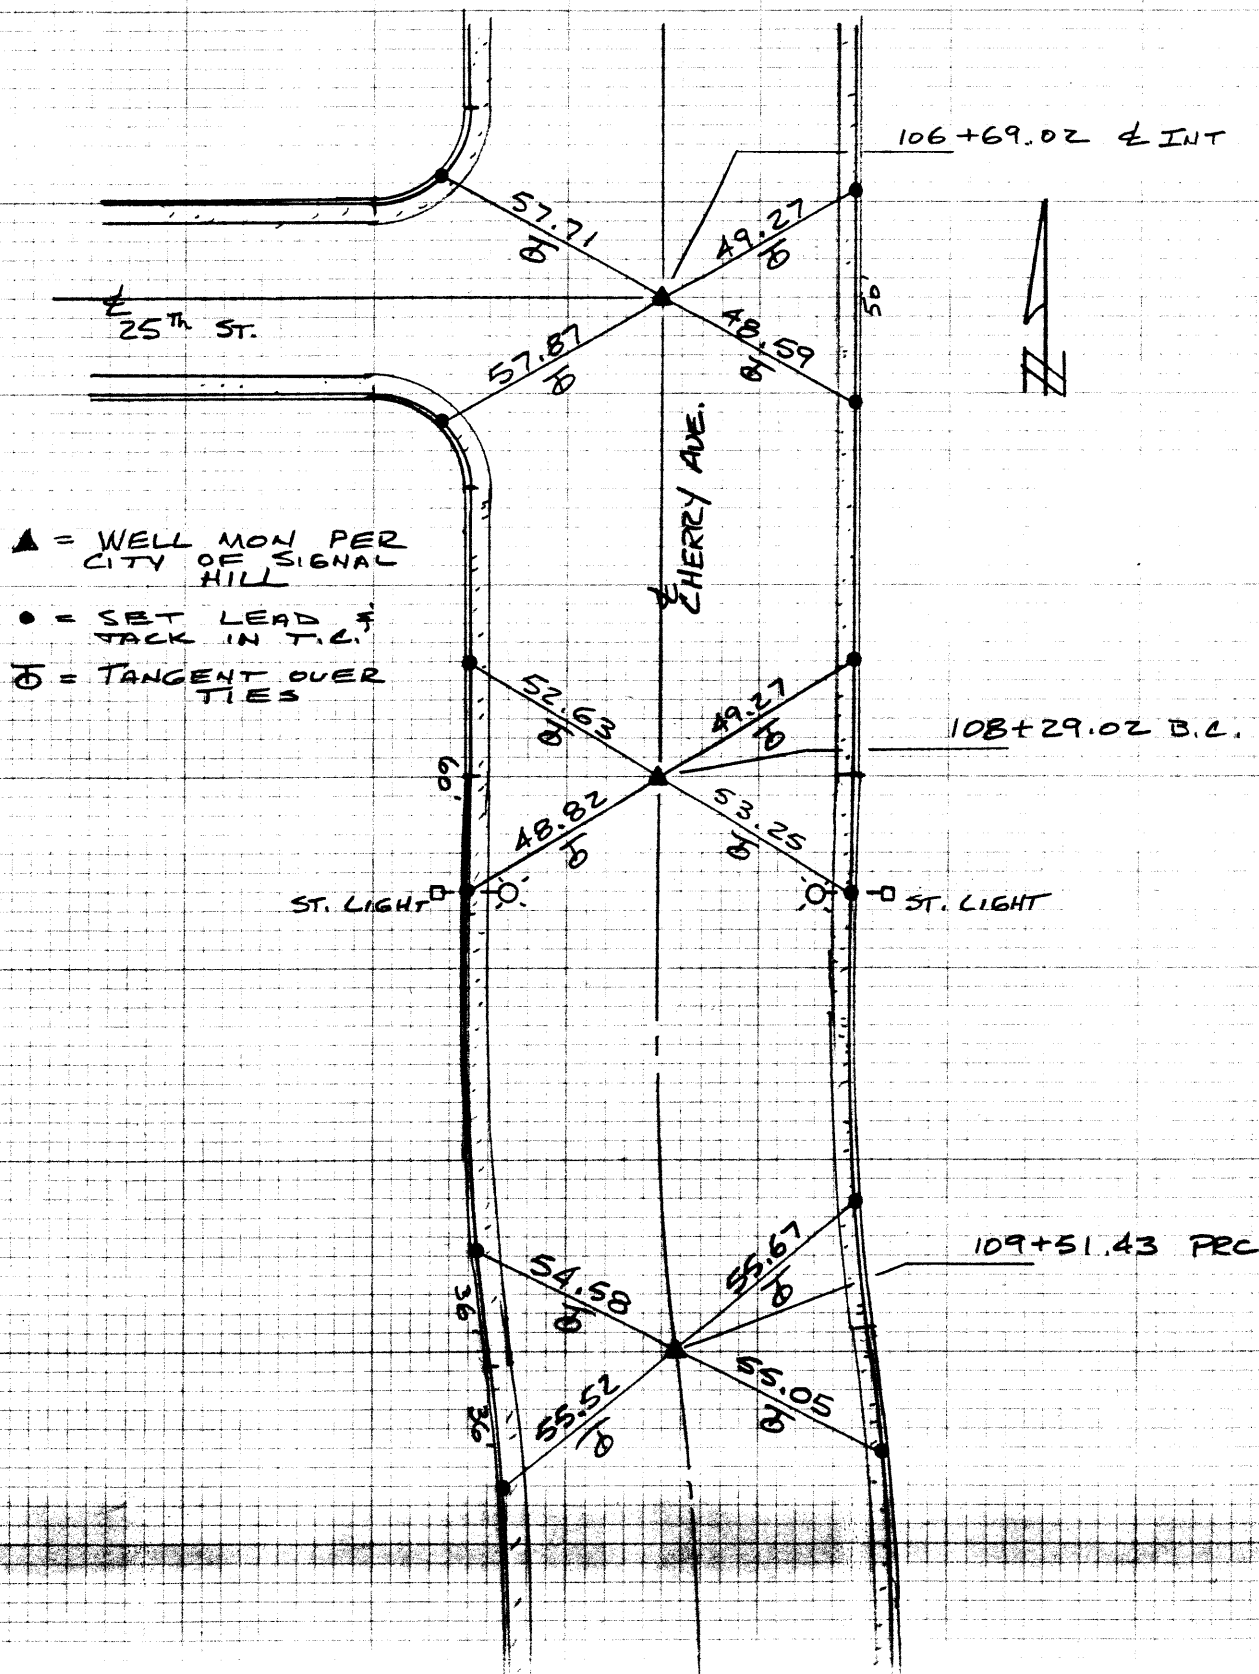

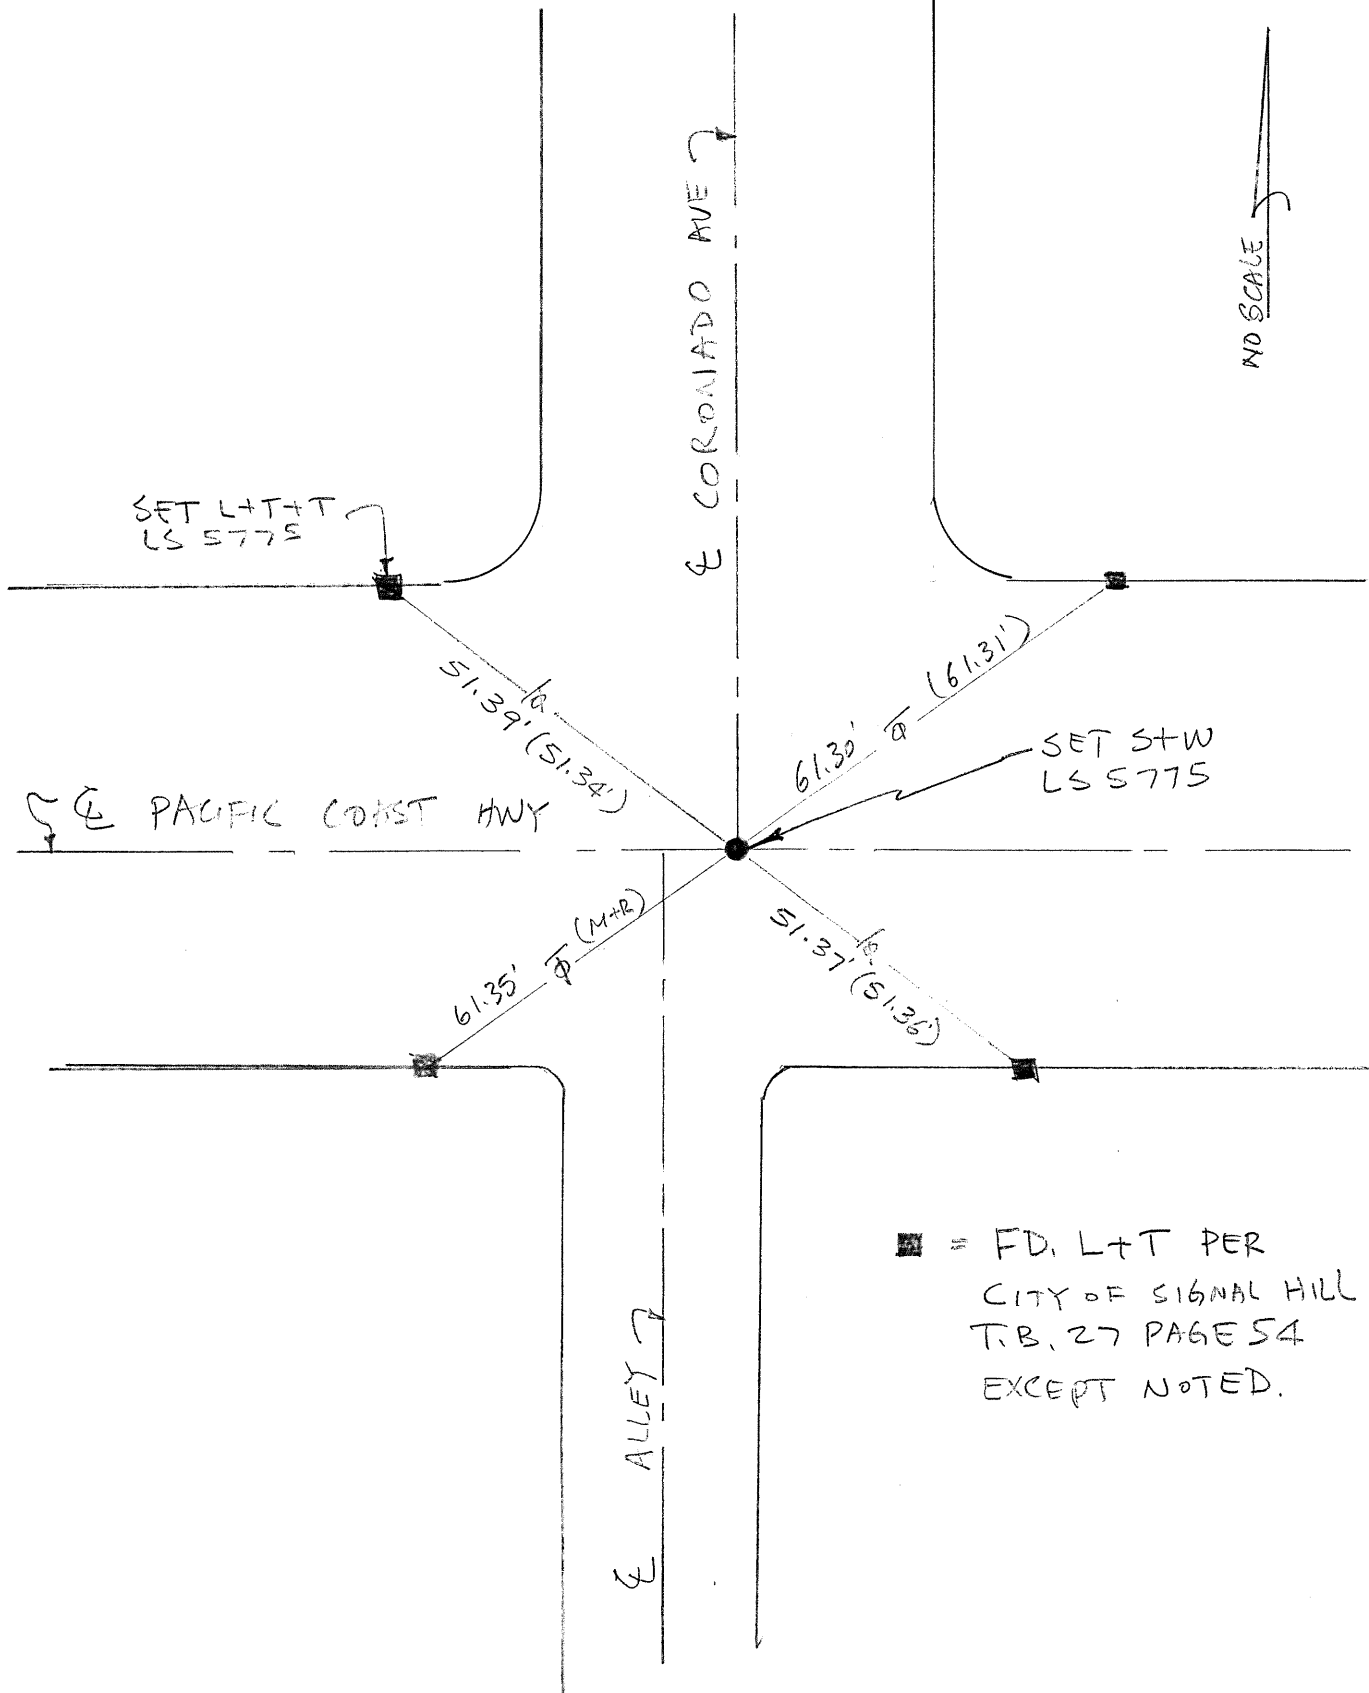


CORNER RECORD

City of SIGNAL HILL

Document Number _____

County of Los Angeles, California

Brief Legal Description CENTER LINE TIES @ PACIFIC COAST HWY & CORONADO AVE

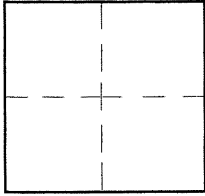

CORNER TYPE

Govt. Corner ☐ Control ☒
Meander ☐ Property ☐
Rancho ☐ Other ☐
Date of Survey 12/20/11

COORDINATES (Optional)

N. _____
E. _____
Zone _____ NAD27 ☐ NAD83 ☐
NAD83 Epoch _____
Elev. _____
Vert. Datum: NGVD29 ☐ NAVD88 ☐
Meas. Units: Metric ☐ Imperial ☐

Corner - Left as found ☒ Found & tagged ☐ Established ☐ Reestablished ☒ Rebuilt ☐

Identification and type of corner found: Evidence used to identify or procedure used to establish or reestablish the corner:

SEE SKETCH

A description of the physical condition of the monument as found and as set or reset:

SEE SKETCH

SURVEYOR'S STATEMENT

This Corner Record was prepared by me or under my direction in conformance

with the Land Surveyors' Act on DEC 2011

Signed [Signature] P.L.S. or R.C.E. No. 5775



COUNTY SURVEYOR'S STATEMENT

This Corner Record was received _____


and examined and filed _____

Signed _____ P.L.S. or R.C.E. No. _____

Title: _____

County Surveyor's Comment _____

NO SCALE

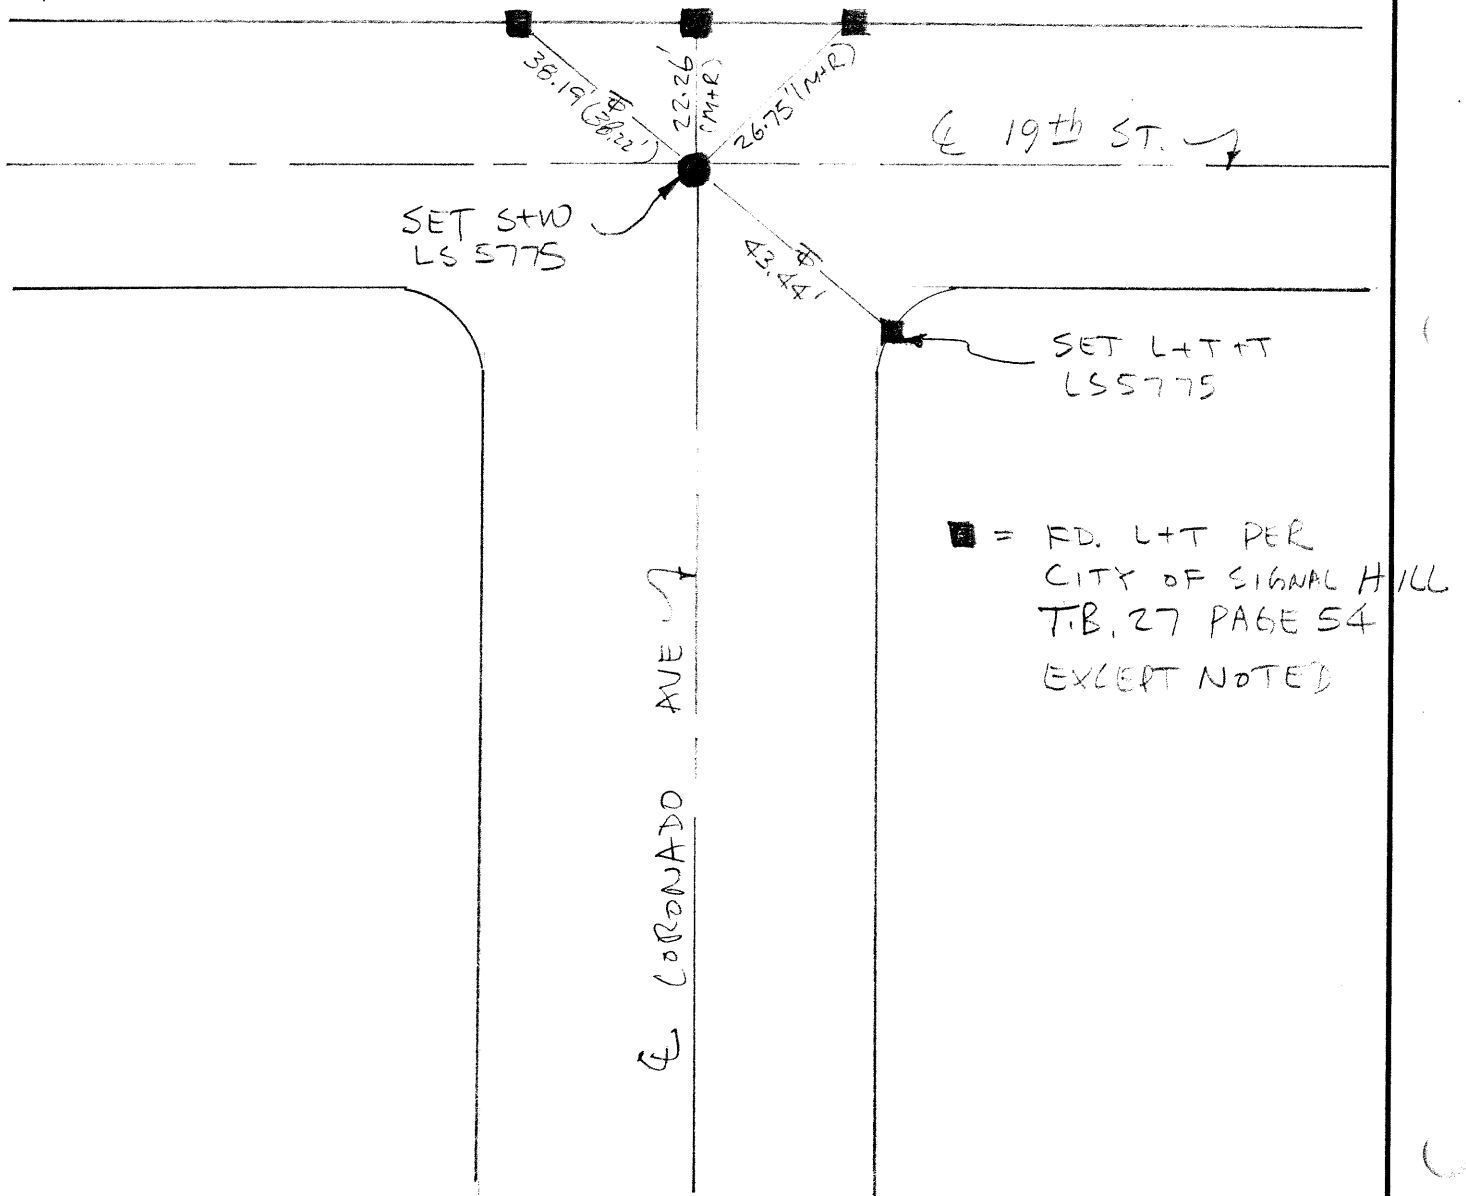


CORNER RECORD

City of SIGNAL HILL

Document Number _____

County of Los Angeles, California

Brief Legal Description CENTER LINE TIES @ CORONADO AVE & 19th ST.

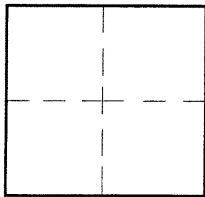

CORNER TYPE

Govt. Corner ☐ Control ☒
Meander ☐ Property ☐
Rancho ☐ Other ☐
Date of Survey 12/2011

COORDINATES (Optional)

N. _____
E. _____
Zone _____ NAD27 ☐ NAD83 ☐
NAD83 Epoch _____
Elev. _____
Vert. Datum: NGVD29 ☐ NAVD88 ☐
Meas. Units: Metric ☐ Imperial ☐

Corner - Left as found ☒ Found & tagged ☐ Established ☐ Reestablished ☒ Rebuilt ☐

Identification and type of corner found: Evidence used to identify or procedure used to establish or reestablish the corner:

SEE SKETCH

A description of the physical condition of the monument as found and as set or reset: _____

SEE SKETCH

SURVEYOR'S STATEMENT

This Corner Record was prepared by me or under my direction in conformance

with the Land Surveyors' Act on DEC. 2011.

Signed [Signature] P.L.S. or R.C.E. No. 5775



COUNTY SURVEYOR'S STATEMENT

This Corner Record was received _____

and examined and filed _____

Signed _____ P.L.S. or R.C.E. No. _____

Title: _____


County Surveyor's Comment _____



CITY OF SIGNAL HILL

2175 Cherry Avenue Signal Hill, California 90806 (310) 989-7300 FAX (310) 989-7393/7391

SURVEY OF CORONADO, 19th, P.C.H. F B NO. PAGE
SURVEY BY JOHN COMBS P.M. NO. 13793
DATE 11/30/84

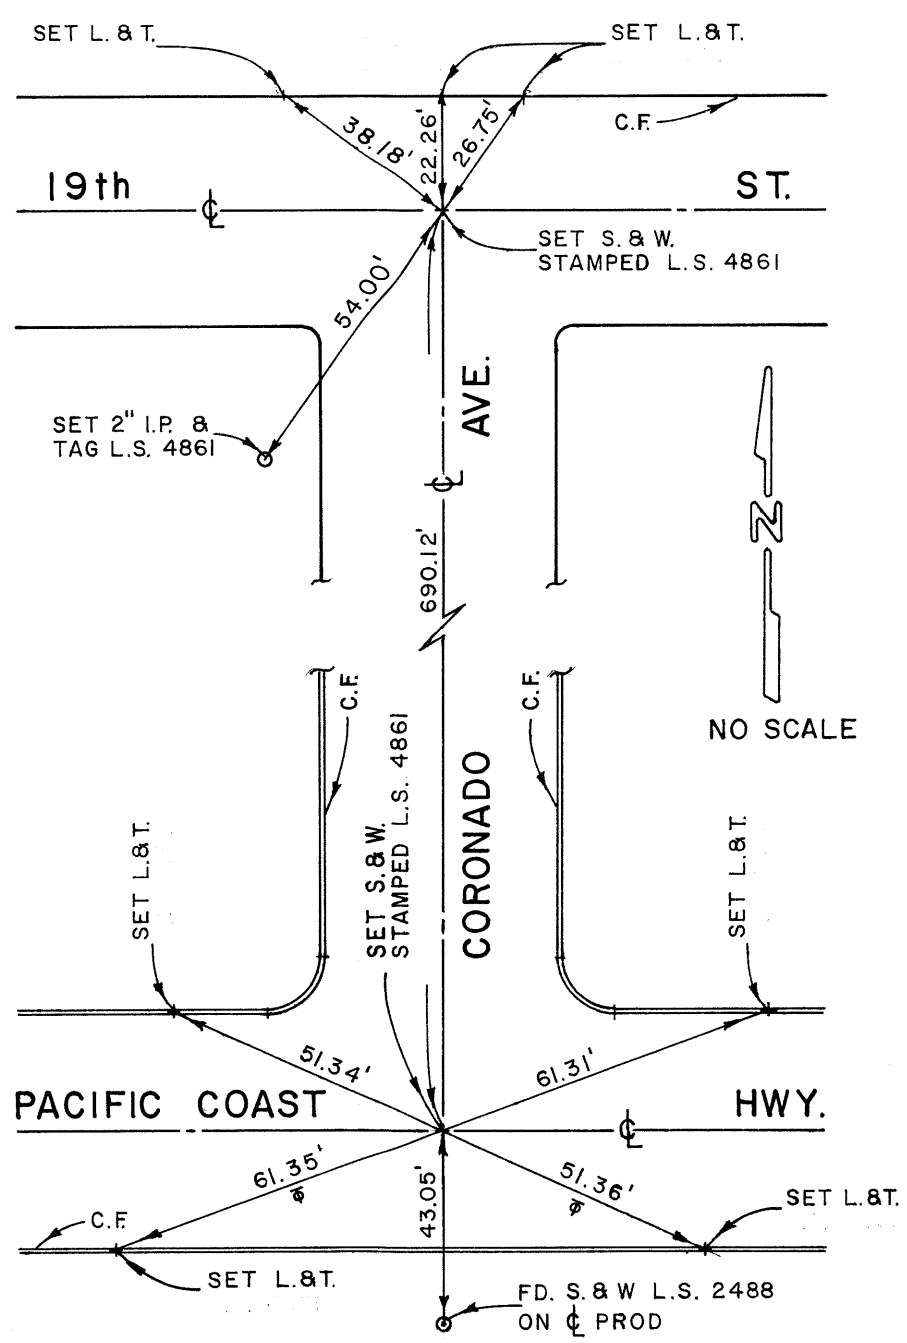

SURVEYORS SERVICE COMPANY - STA MESA - STOCK NO. 411

DO NOT EXTEND NOTES THIS SIDE OF LINE

C-15

Case # 2215

bottom opp pg

brass tack in
east edge of
bottom window
frame of mast
west of window

about 1800
paced

9270
9285
9295

10

4742

Pg 45

(Survey

1925

345

P. 1

76.81
P. 2.

22

Ke
97

10:11

1892

DR

ORANGE

DRIVE

BORDER

~~TRIPPLE ROOM~~

52° 17' 54"

ОТРАВЕ

Top 456

B.

56

G 21 '85 16:03 RBF IRVINE #2

SURVEY OF CENTRE LINE 72' E. CIPRIN 20th ST
STONAL HILL

JOB NO. 24362

BOOK 53

P. 2/3

PAGE 176


SURVEYED BY CAG SPE

DATE 17 AUGUST 89

Robert Bein, William Frost & Associates

PROFESSIONAL ENGINEERS, PLANNERS & SURVEYORS

P.O. BOX 19739 • 14725 ALTON PARKWAY • IRVINE, CA 92718
(714) 472-3505 • FAX (714) 472-8373

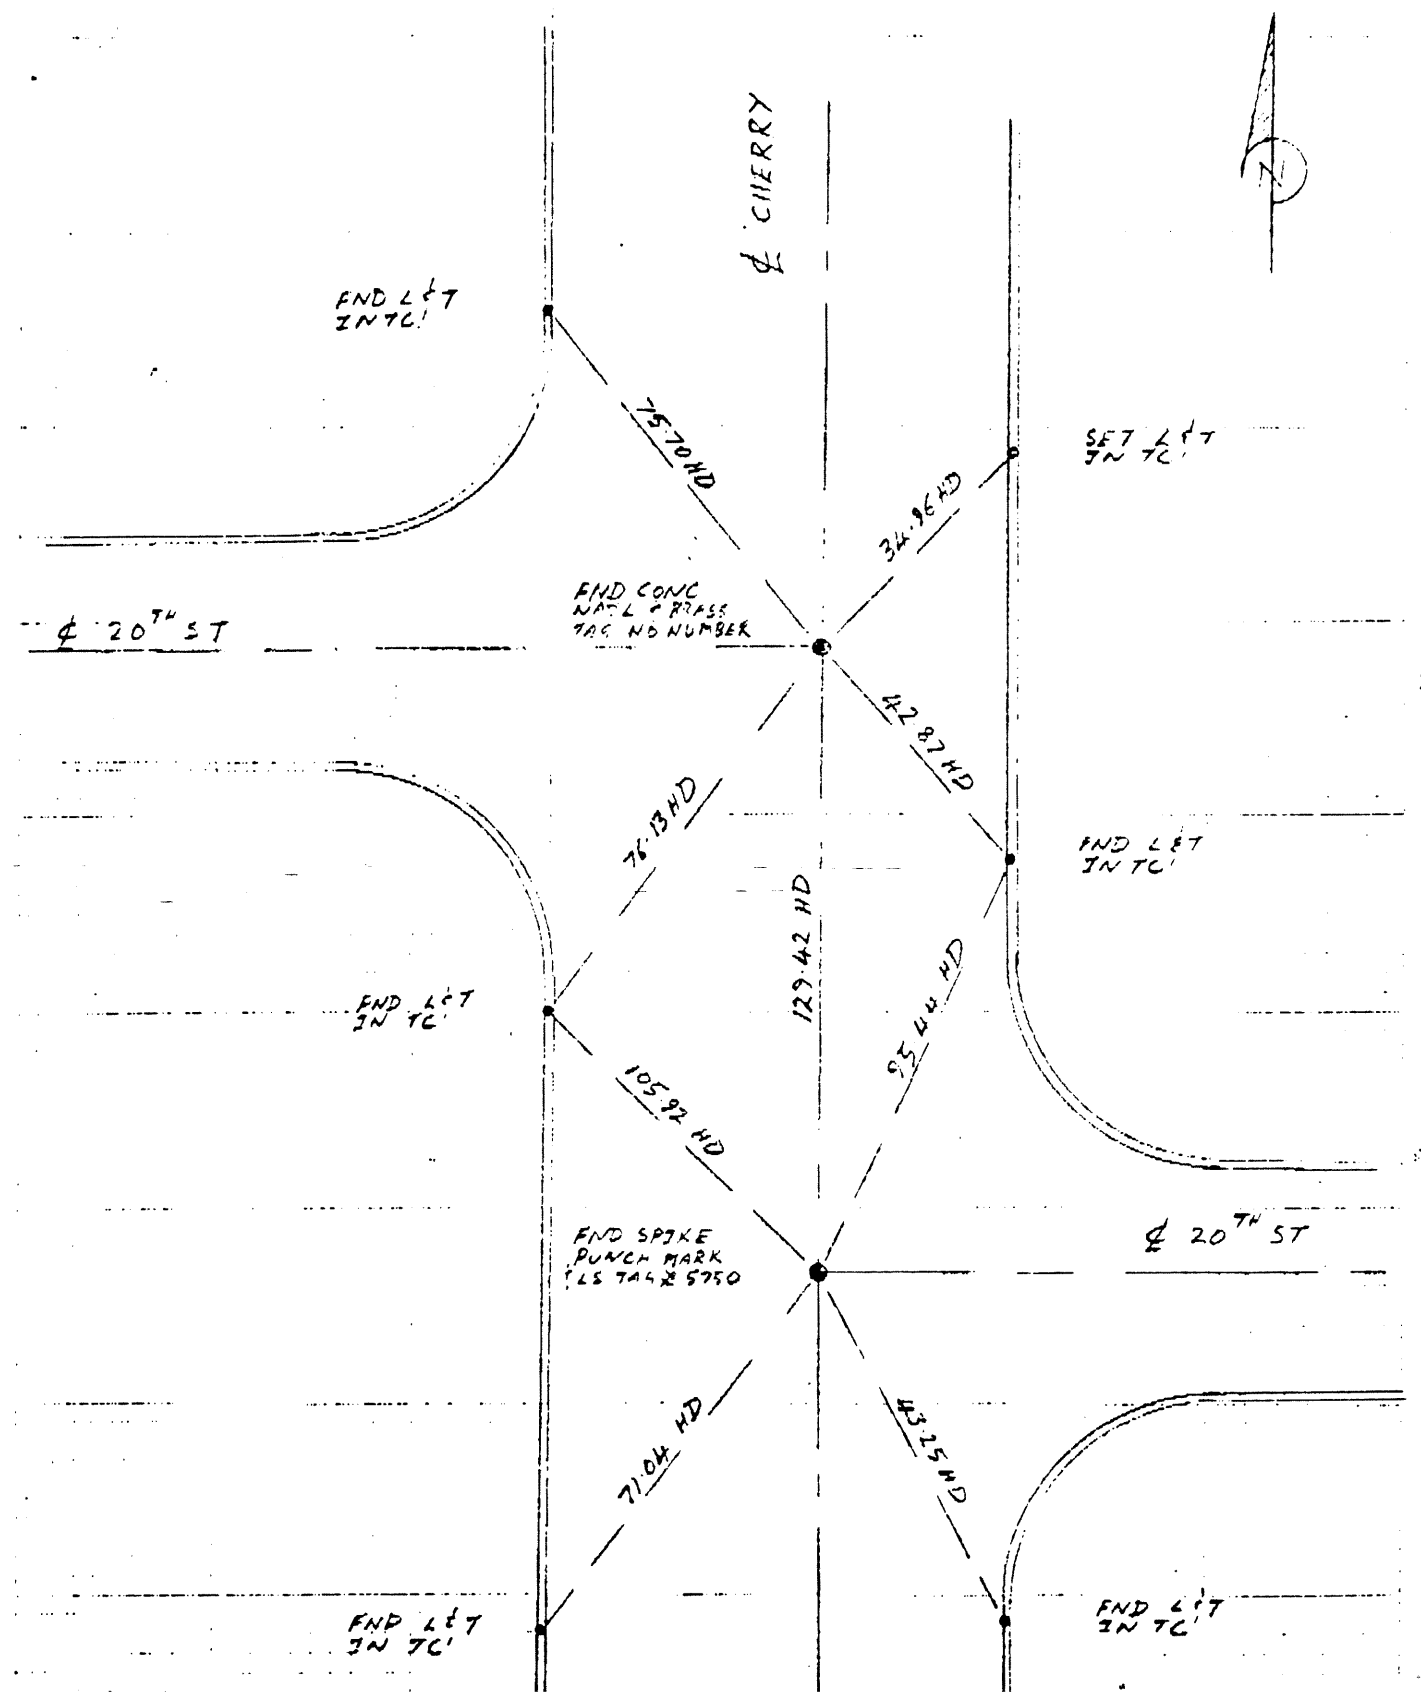

5 21 '89 16:10 RBF IRVINE #2

SURVEY OF SIGNAL HILL / CHERRY AVE

JOB NO. 04262 BO.

57 171

SURVEYED BY KENDALL, RODRIGUEZ


DATE 8-17-89


Robert Bein, William Frost & Associates

PROFESSIONAL ENGINEERS, PLANNERS & SURVEYORS

74-410 HIGHWAY 111 • PALM DESERT, CA 92260

(619) 346-7461 • FAX (619) 346-8315

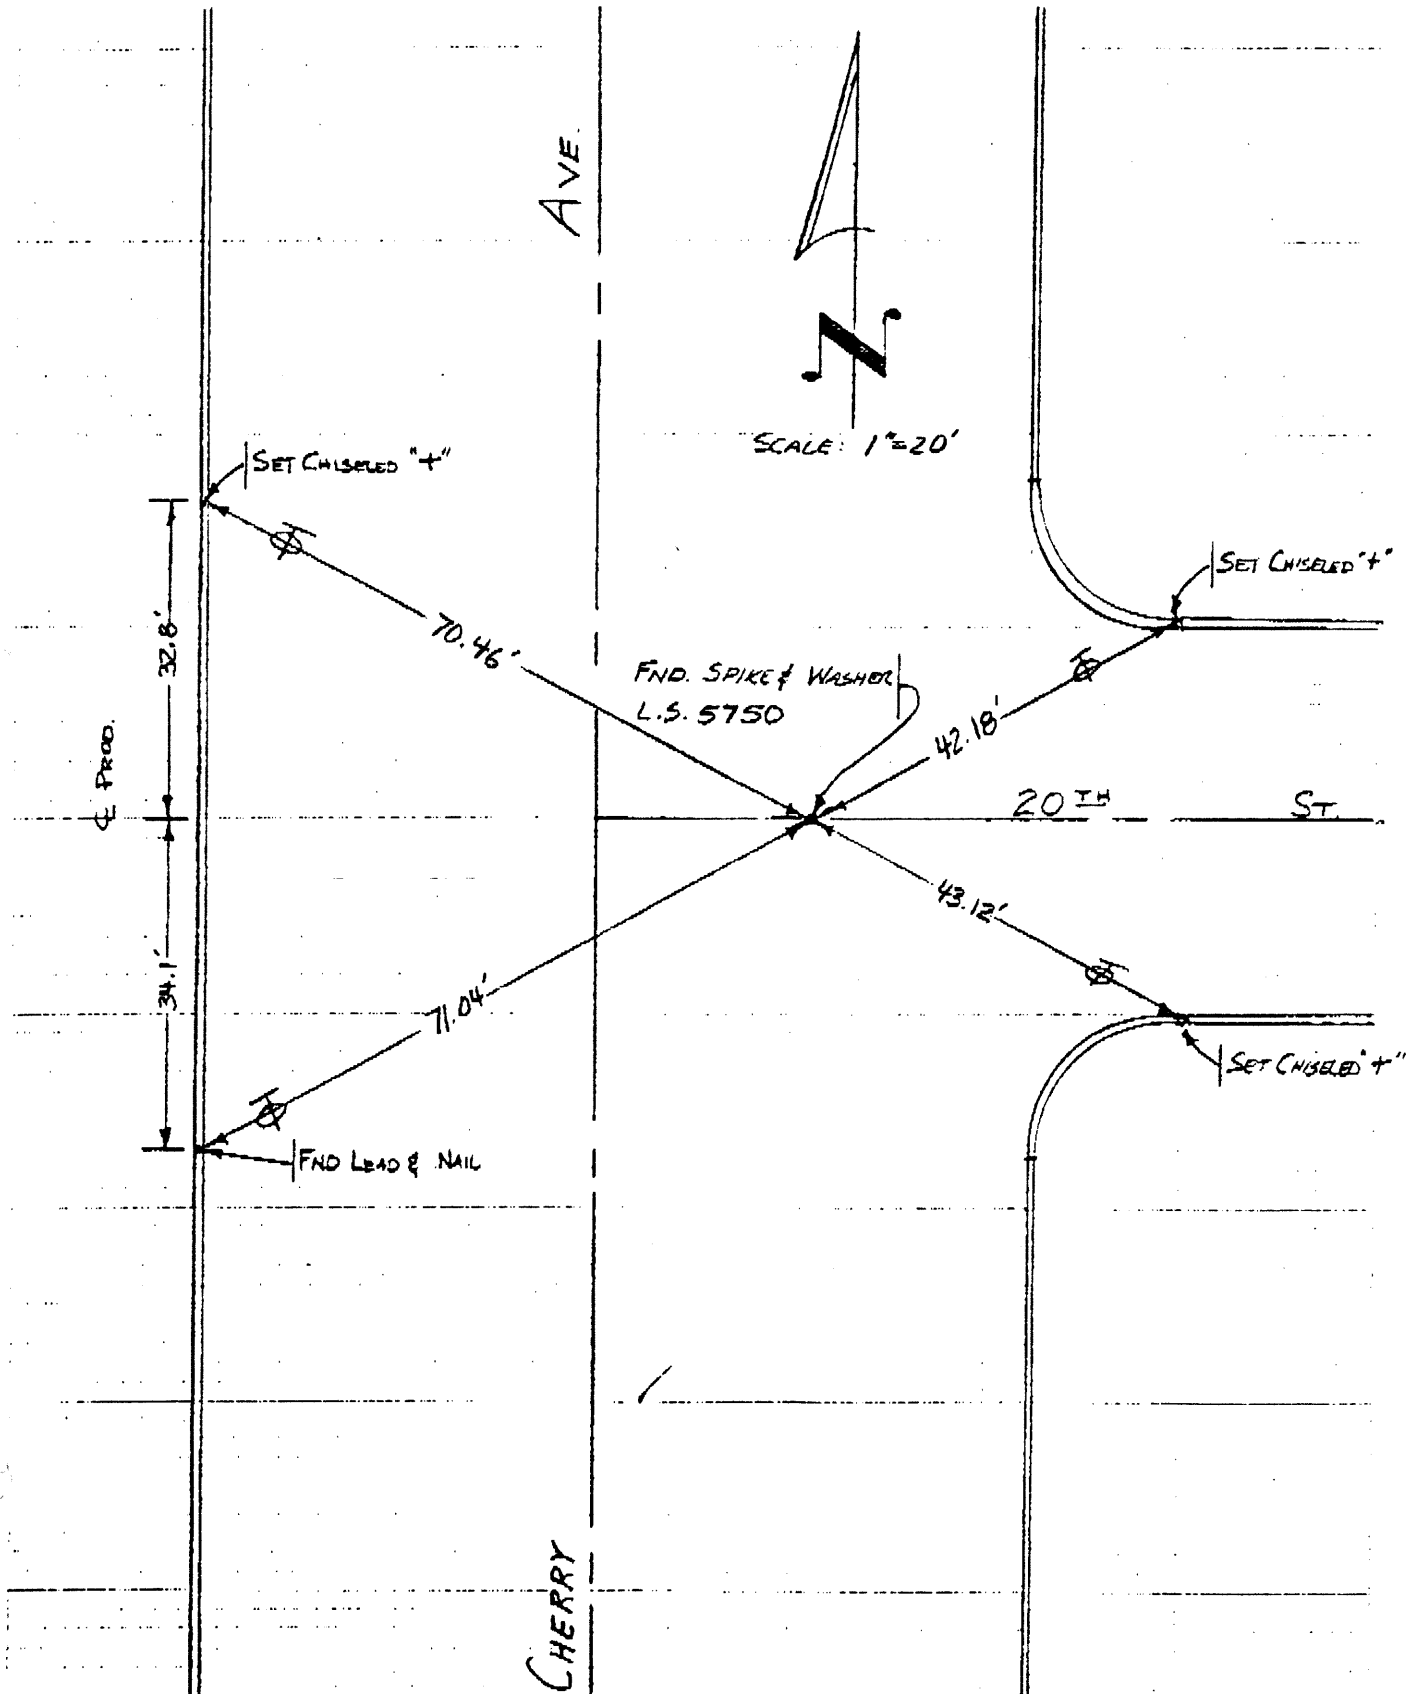

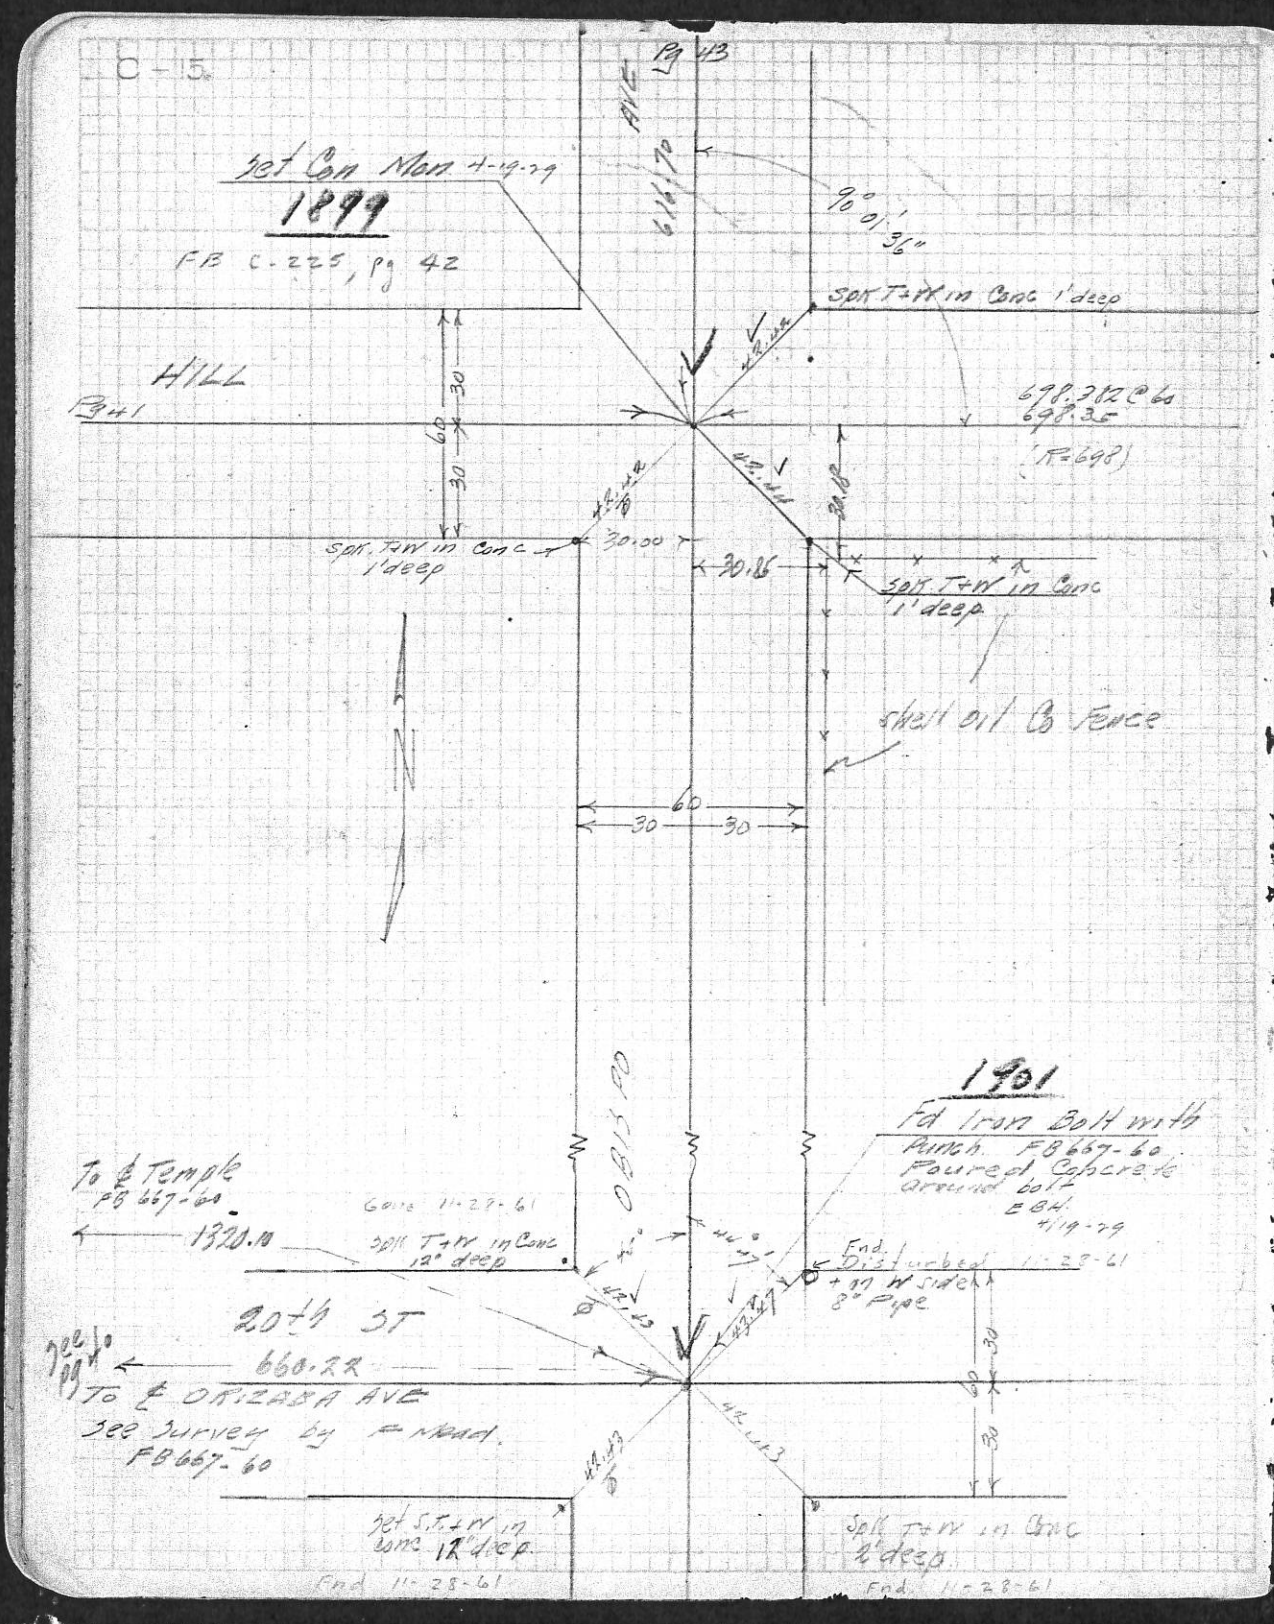

~~Pg 43~~

42

4

Con Mon S
Birdy L Co
1902

FB C-325 p. 42

37
268.96 @ 66
268.96

Con Mon by
B.L. Co.
1900

TIES FB C-225, pg. 111

Established at Hill Street
and Ranch Line to El Chippo
Ave and Ranch Line for proportionate
Record between El Chippo and Ranch
Line and Commission at El Temple
and Ranch Line.

$R = 830$

1542

120°
106°
130°

Ch. C. Con. Mon.
1963 54

FB C-225 pg. 42
FB C-30 pg. 74

B.L. C. Con Man
3' Deep

B. L Co Car Mon.



CITY OF SIGNAL HILL

2175 Cherry Avenue Signal Hill, California 90806 (310) 989-7300 FAX (310) 989-7393/7391


SURVEY OF CENTERLINE TIES F B NO. PAGE 1
 SURVEY BY JHH CONSULTANTS TRACT NO. 34974
 DATE OCTOBER, 1986 ENGINEER:
 HUGH E. HALDERMAN RCE 8793

● INDICATES SET L&T IN CONCRETE CURB UNLESS OTHERWISE NOTED.

○ INDICATES SET SPIKE & WASHER STAMPED RCE 8793


SCALE 1" = 40'

A 21.71'
 B 20.57'
 C 20.50'
 D 21.09'
 E 21.29'
 F 21.55'
 G 20.23'
 H 54.19'
 I 44.21'
 J 45.21'
 K 51.95'
 L 20.68'
 M 20.25'

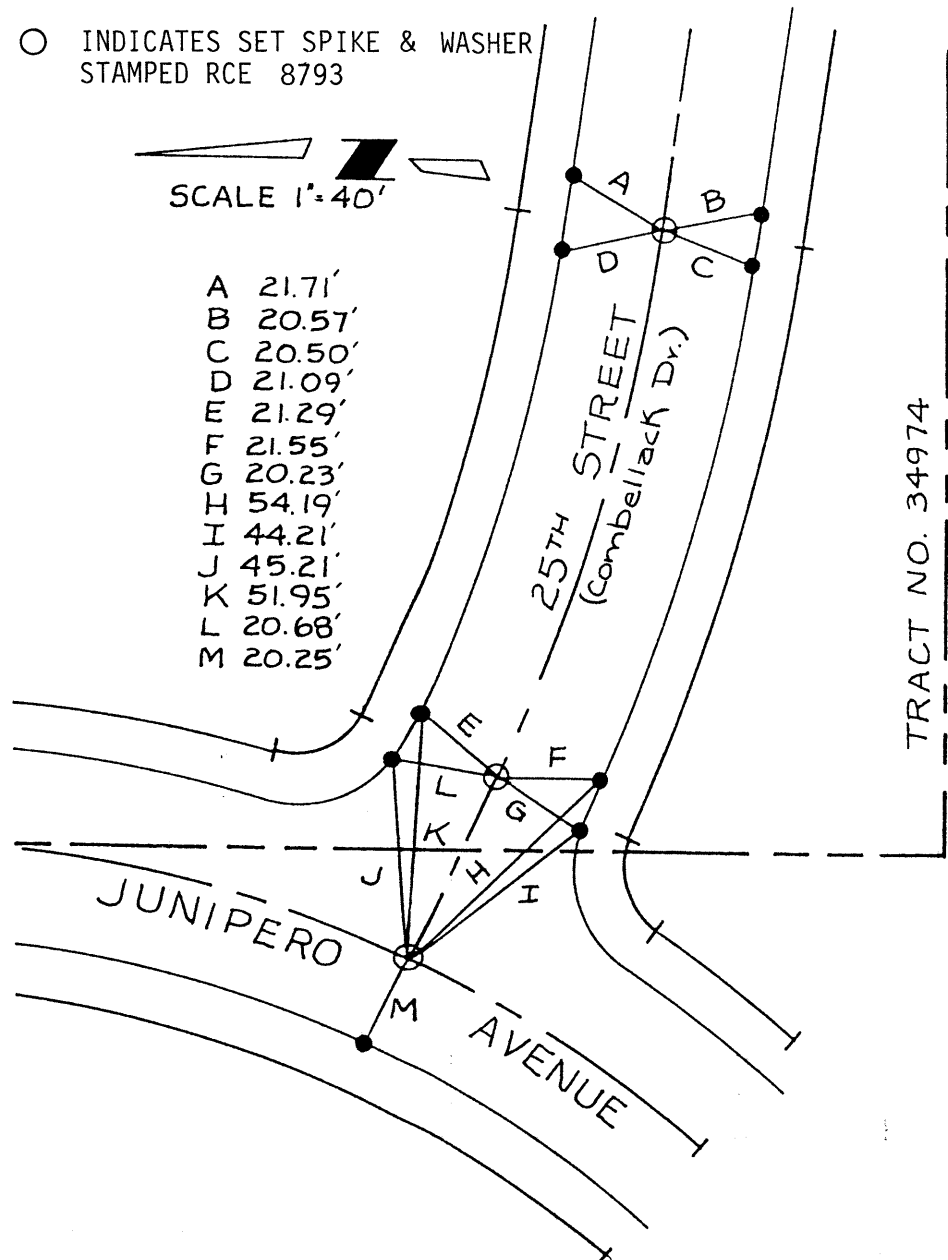


SURVEYOR'S SERVICE COMPANY, COSTA MESA - STOCK NO. 411


DO NOT EXTEND NOTES THIS SIDE OF LINE

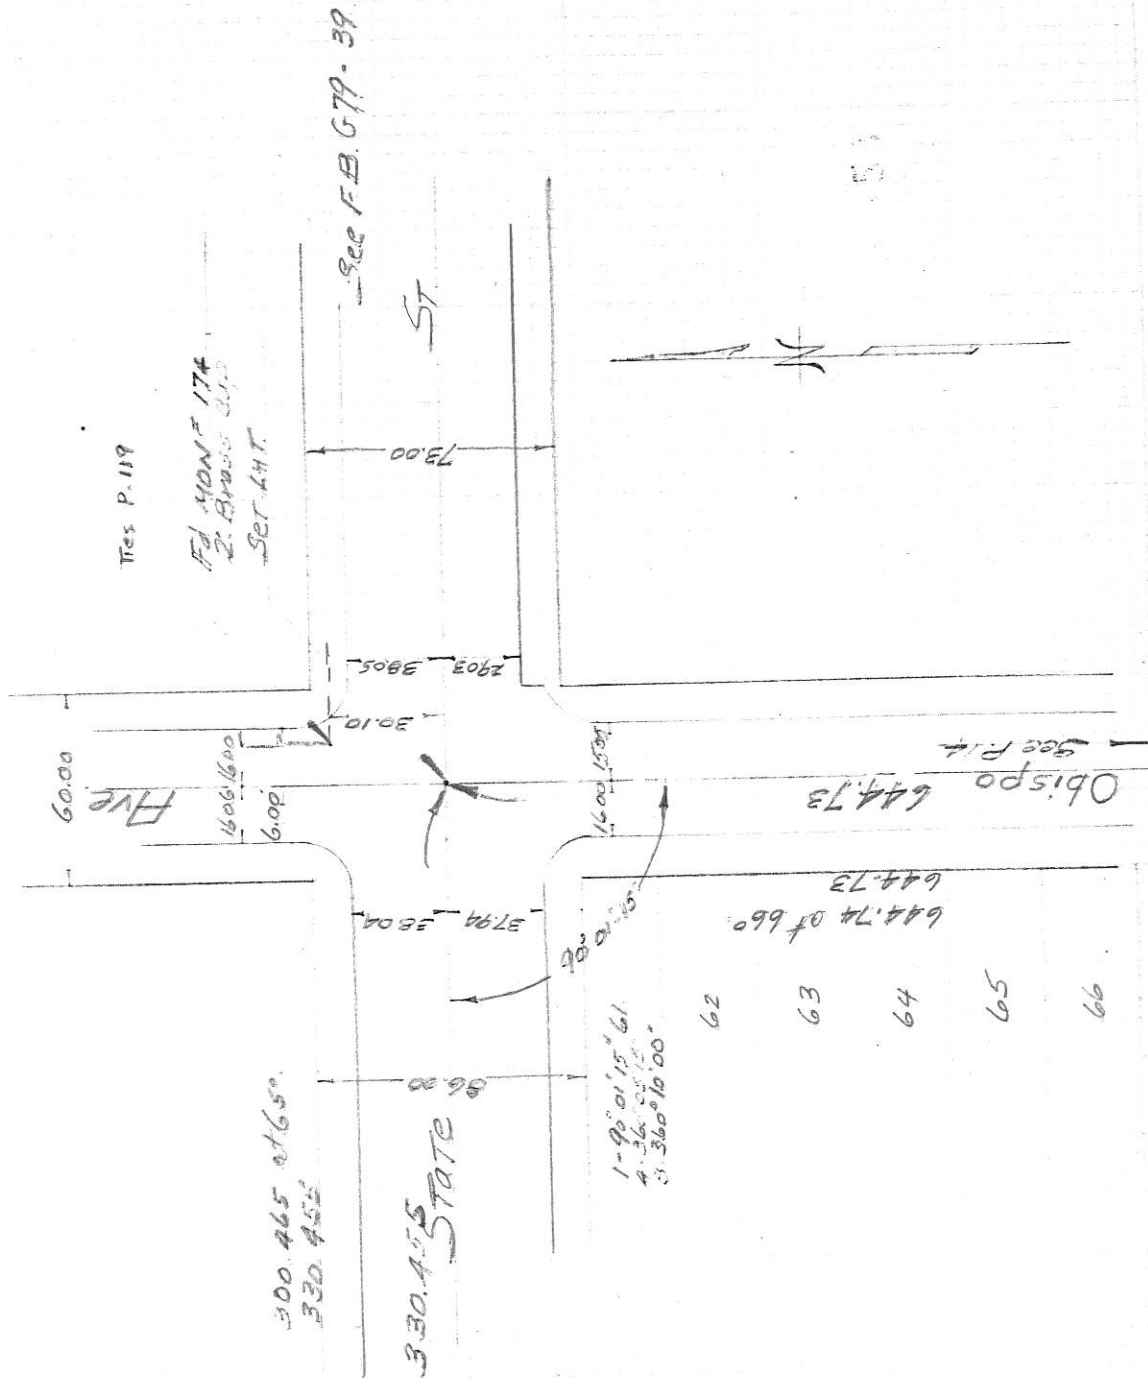

119

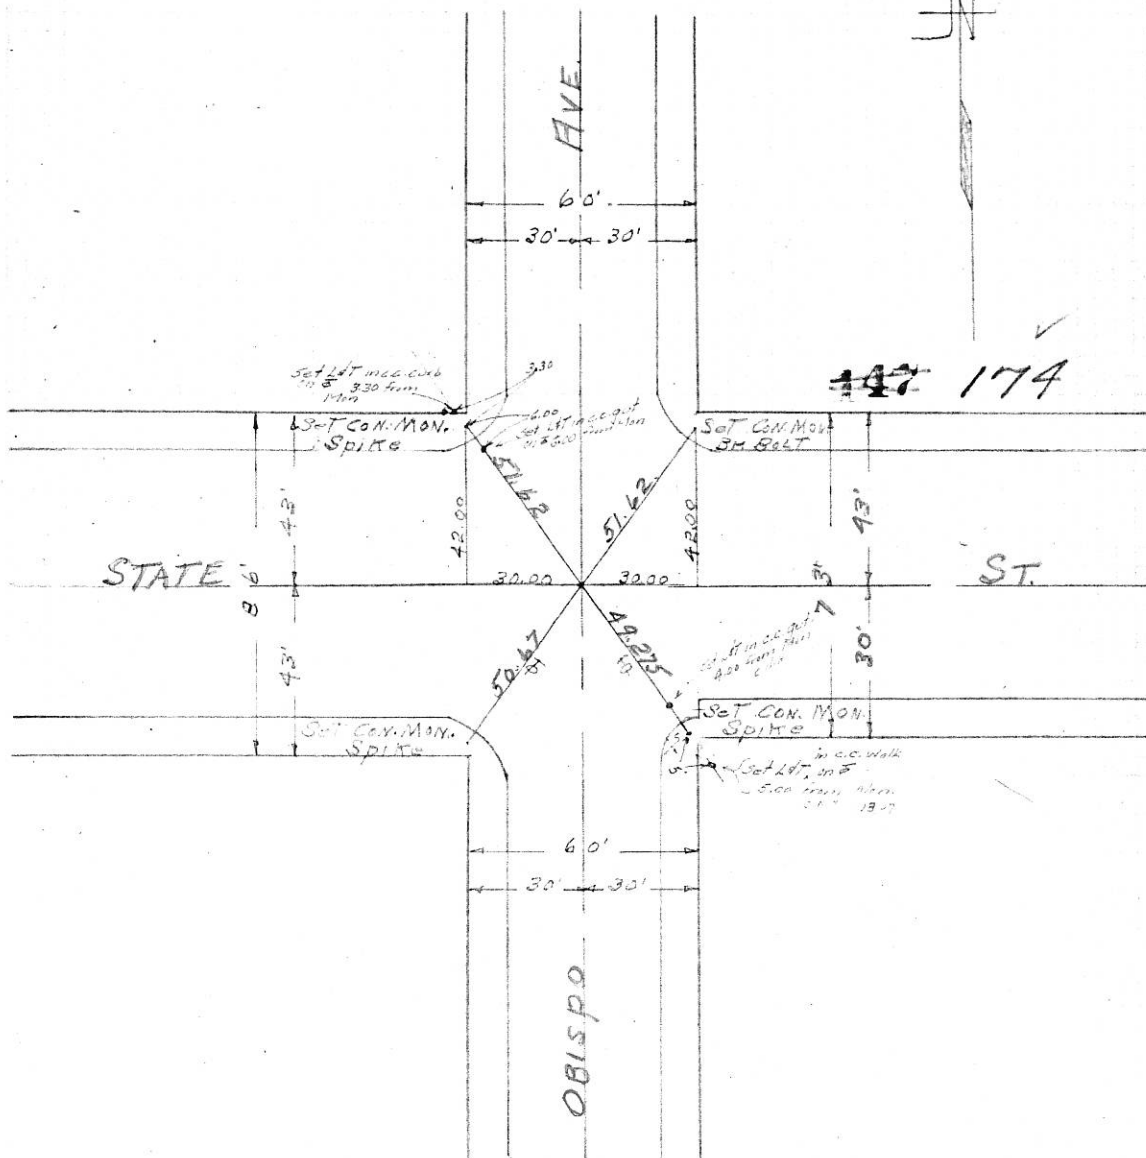



117

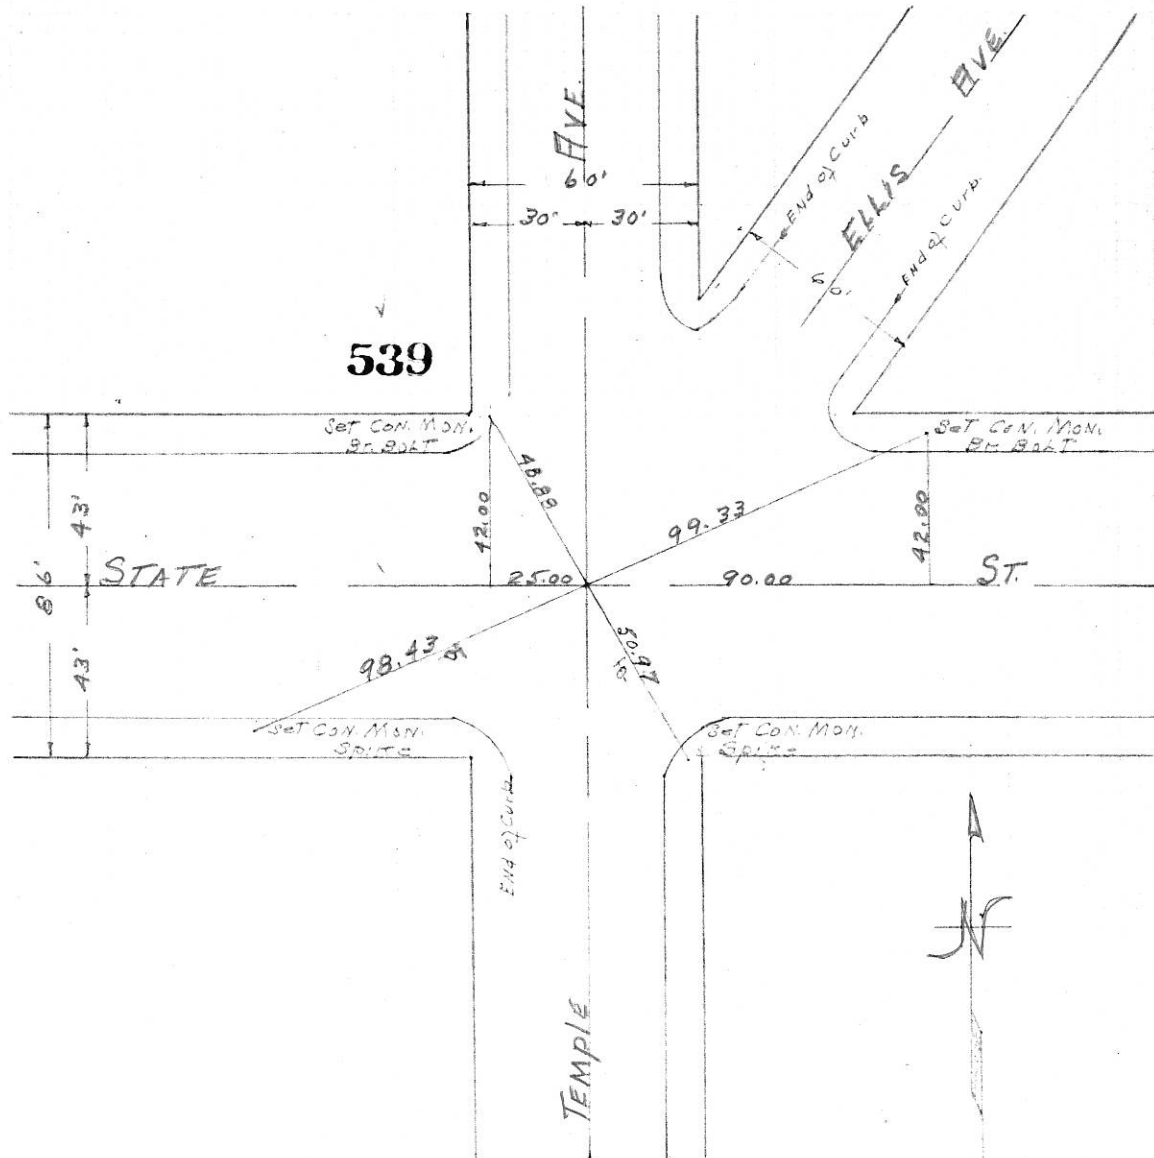

See Pg 9
" C-

113

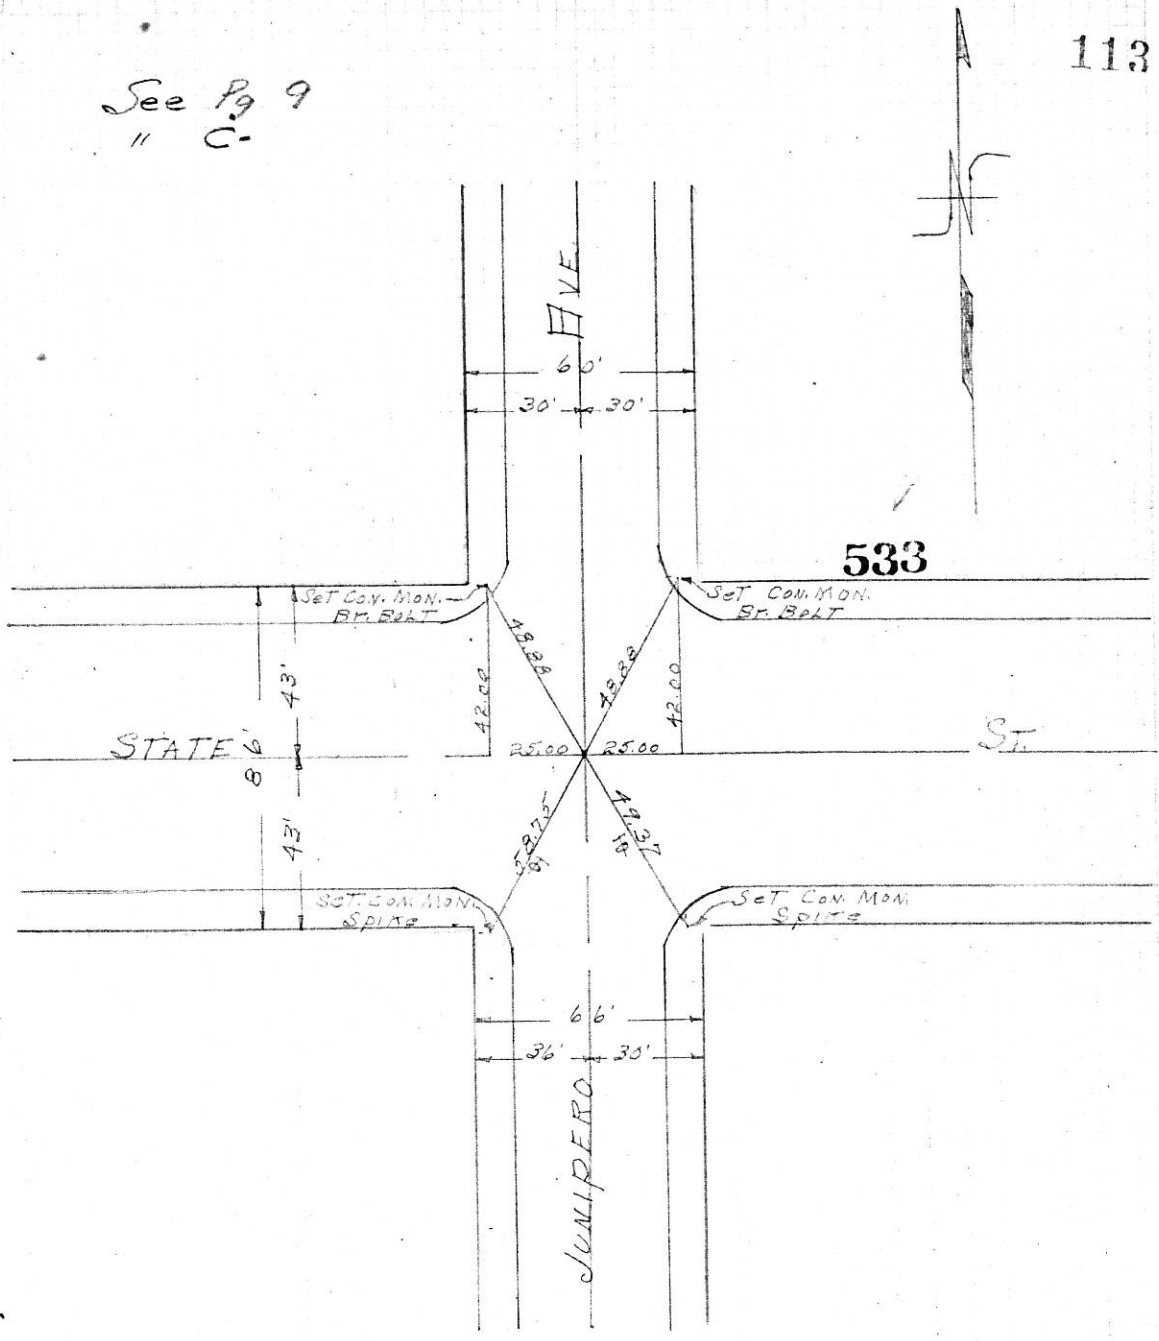

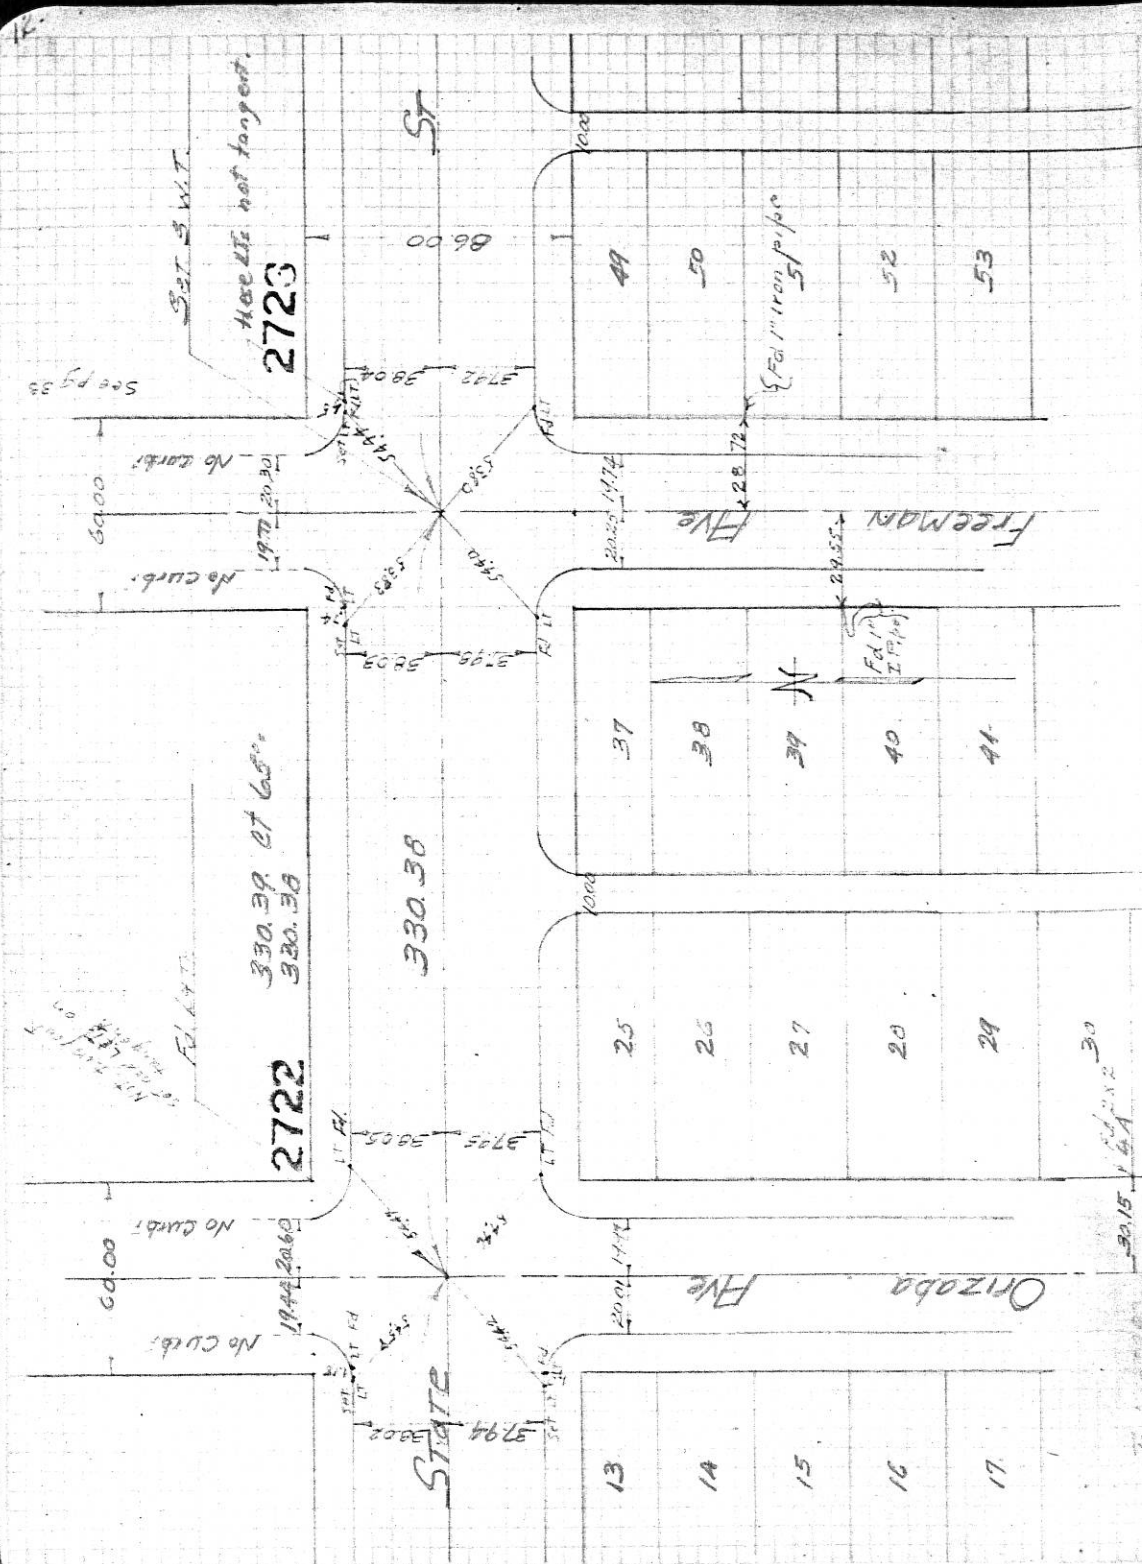




CITY OF SIGNAL HILL

2175 Cherry Avenue Signal Hill, California 90806 (310) 989-7300 FAX (310) 989-7393/7391

SURVEY OF CENTERLINE TIES F B NO. PAGE 2
SURVEY BY JHH CONSULTANTS TRACT NO. 34974
DATE OCTOBER, 1986 ENGINEER:
HUGH E. HALDERMAN RCE 8793

SURVEYORS SERVICE COMPANY, COSTA MESA - STOCK NO. 411

DO NOT EXTEND NOTES THIS SIDE OF LINE

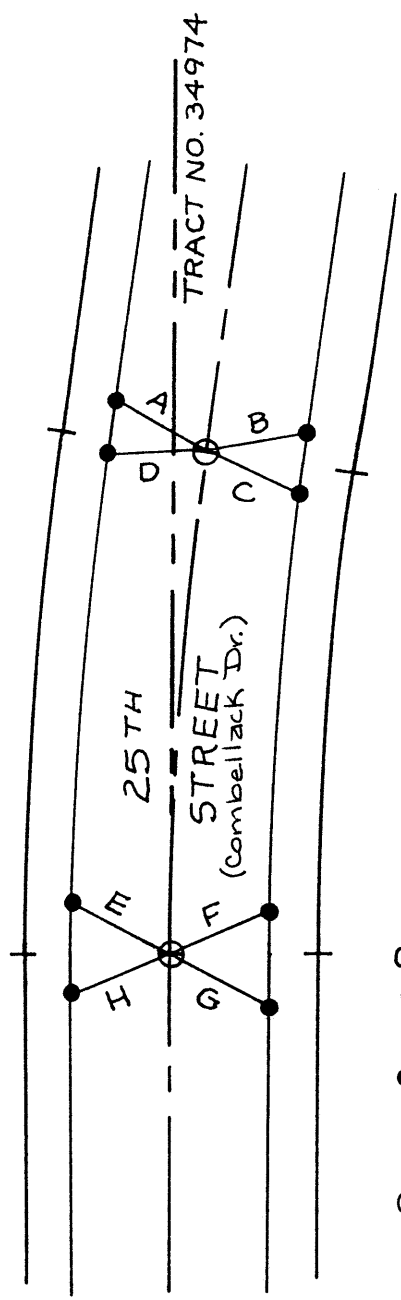

- A 21.19'
- B 22.40'
- C 21.75'
- D 20.12'

SCALE 1"=40'

- E 20.78'
- F 21.78'
- G 22.57'
- H 20.98'

- INDICATES SET L&T IN CONCRETE CURB UNLESS OTHERWISE NOTED.
- INDICATES SET SPIKE & WASHER STAMPED RCE 8793



CITY OF SIGNAL HILL

2175 Cherry Avenue Signal Hill, California 90806 (310) 989-7300 FAX (310) 989-7393/7391

SURVEY OF CENTERLINE TIES F B NO. 3 PAGE 3
 SURVEY BY JHH CONSULTANTS TRACT NO. 34974
 DATE OCTOBER, 1986 ENGINEER:
 HUGH E. HALDERMAN
 RCE 8793

TRACT NO. 34974



A 26.87
 B 23.73
 C 22.87
 D 23.13

NOTE:
 TIE "D" WAS SET IN THE
 CROSS-GUTTER

E 22.80
 F 19.25
 G 20.70
 H 21.26

- INDICATES SET L&T IN CONCRETE CURB UNLESS OTHERWISE NOTED.
- INDICATES SET SPIKE & WASHER STAMPED RCE 8793

SURVEYORS SERVICE COMPANY, COSTA MESA - STOCK NO. 411

DO NOT EXTEND NOTES THIS SIDE OF LINE




CITY OF SIGNAL HILL

2175 Cherry Avenue Signal Hill, California 90806 (310) 989-7300 FAX (310) 989-7393/7391

SURVEY OF CENTERLINE TIES F B NO. PAGE 4
 SURVEY BY JHH CONSULTANTS TRACT NO. 34974
 DATE OCTOBER, 1986 ENGINEER:
 HUGH E. HALDERMAN RCE 8793

SURVEYOR'S SERVICE COMPANY, COSTA MESA - STOCK NO. 411

DO NOT EXTEND NOTES THIS SIDE OF LINE

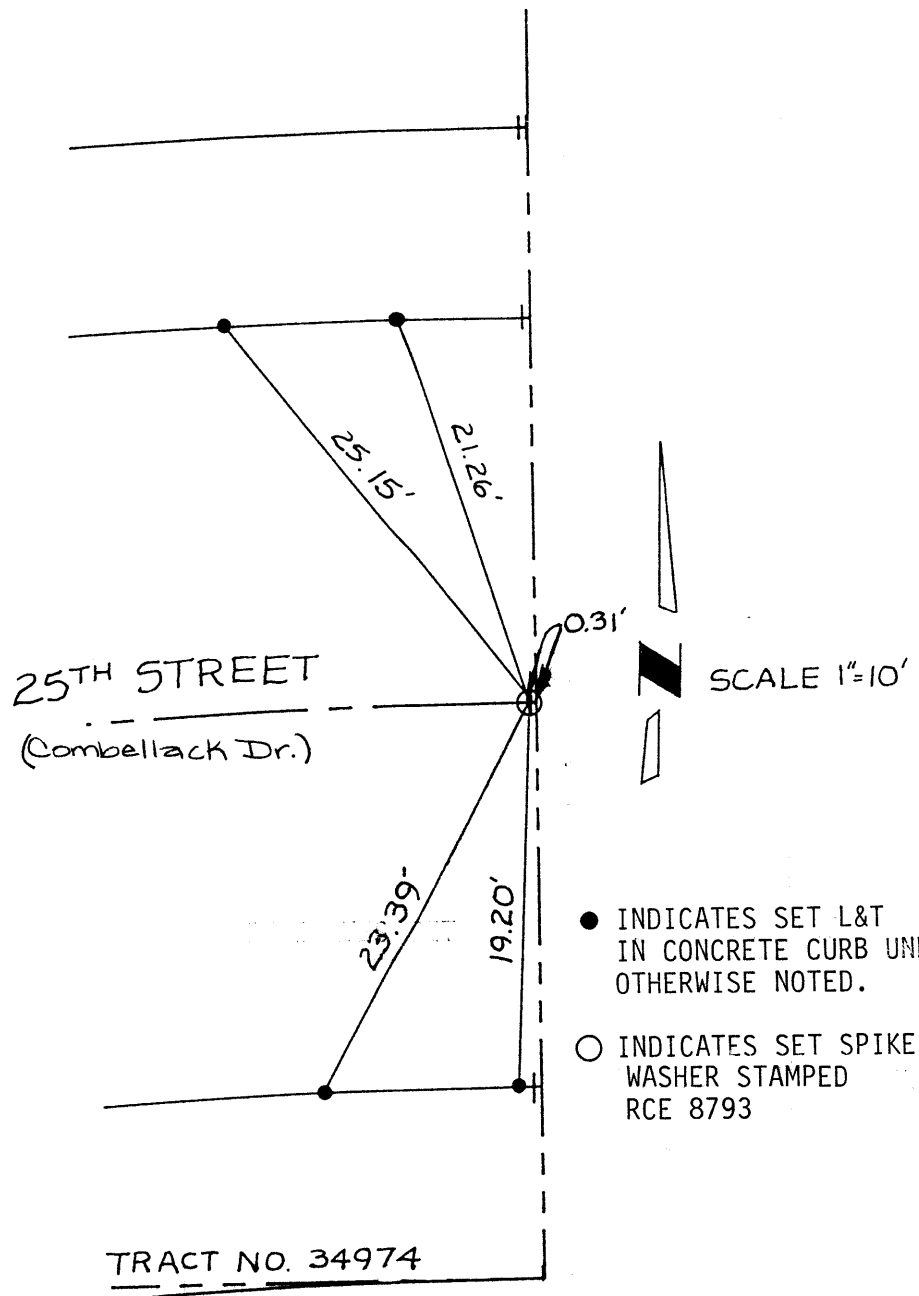




CITY OF SIGNAL HILL

2175 Cherry Avenue Signal Hill, California 90806 (310) 989-7300 FAX (310) 989-7393/7391


SURVEY OF CENTERLINE TIES F B NO. PAGE 5
 SURVEY BY JHH CONSULTANTS TRACT NO. 34974
 DATE OCTOBER, 1986 ENGINEER:
 HUGH E. HALDERMAN RCE 8793


SURVEYORS SERVICE COMPANY, COSTA MESA - STOCK NO. 411

DO NOT EXTEND NOTES THIS SIDE OF LINE

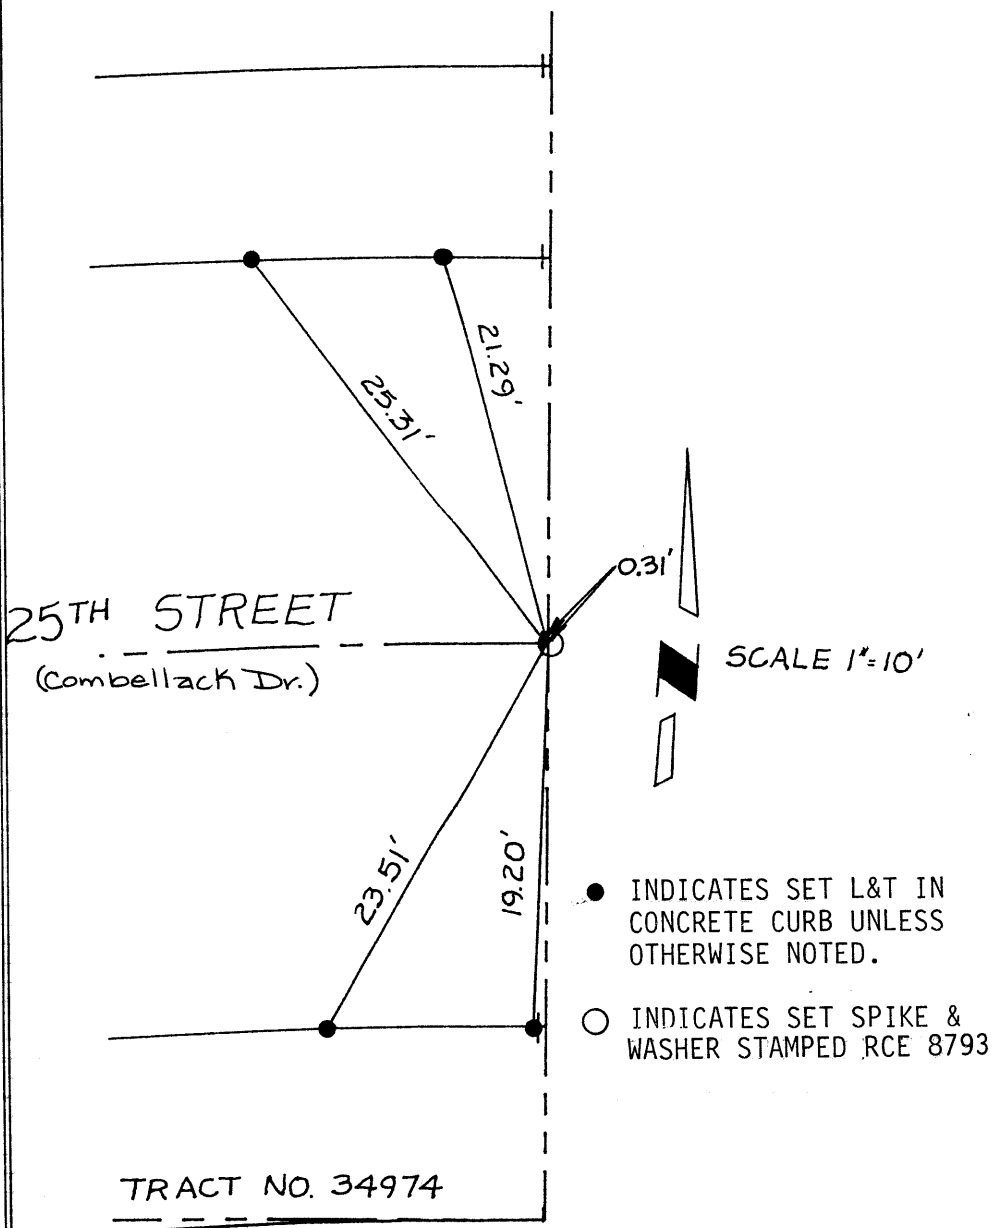

See page 78

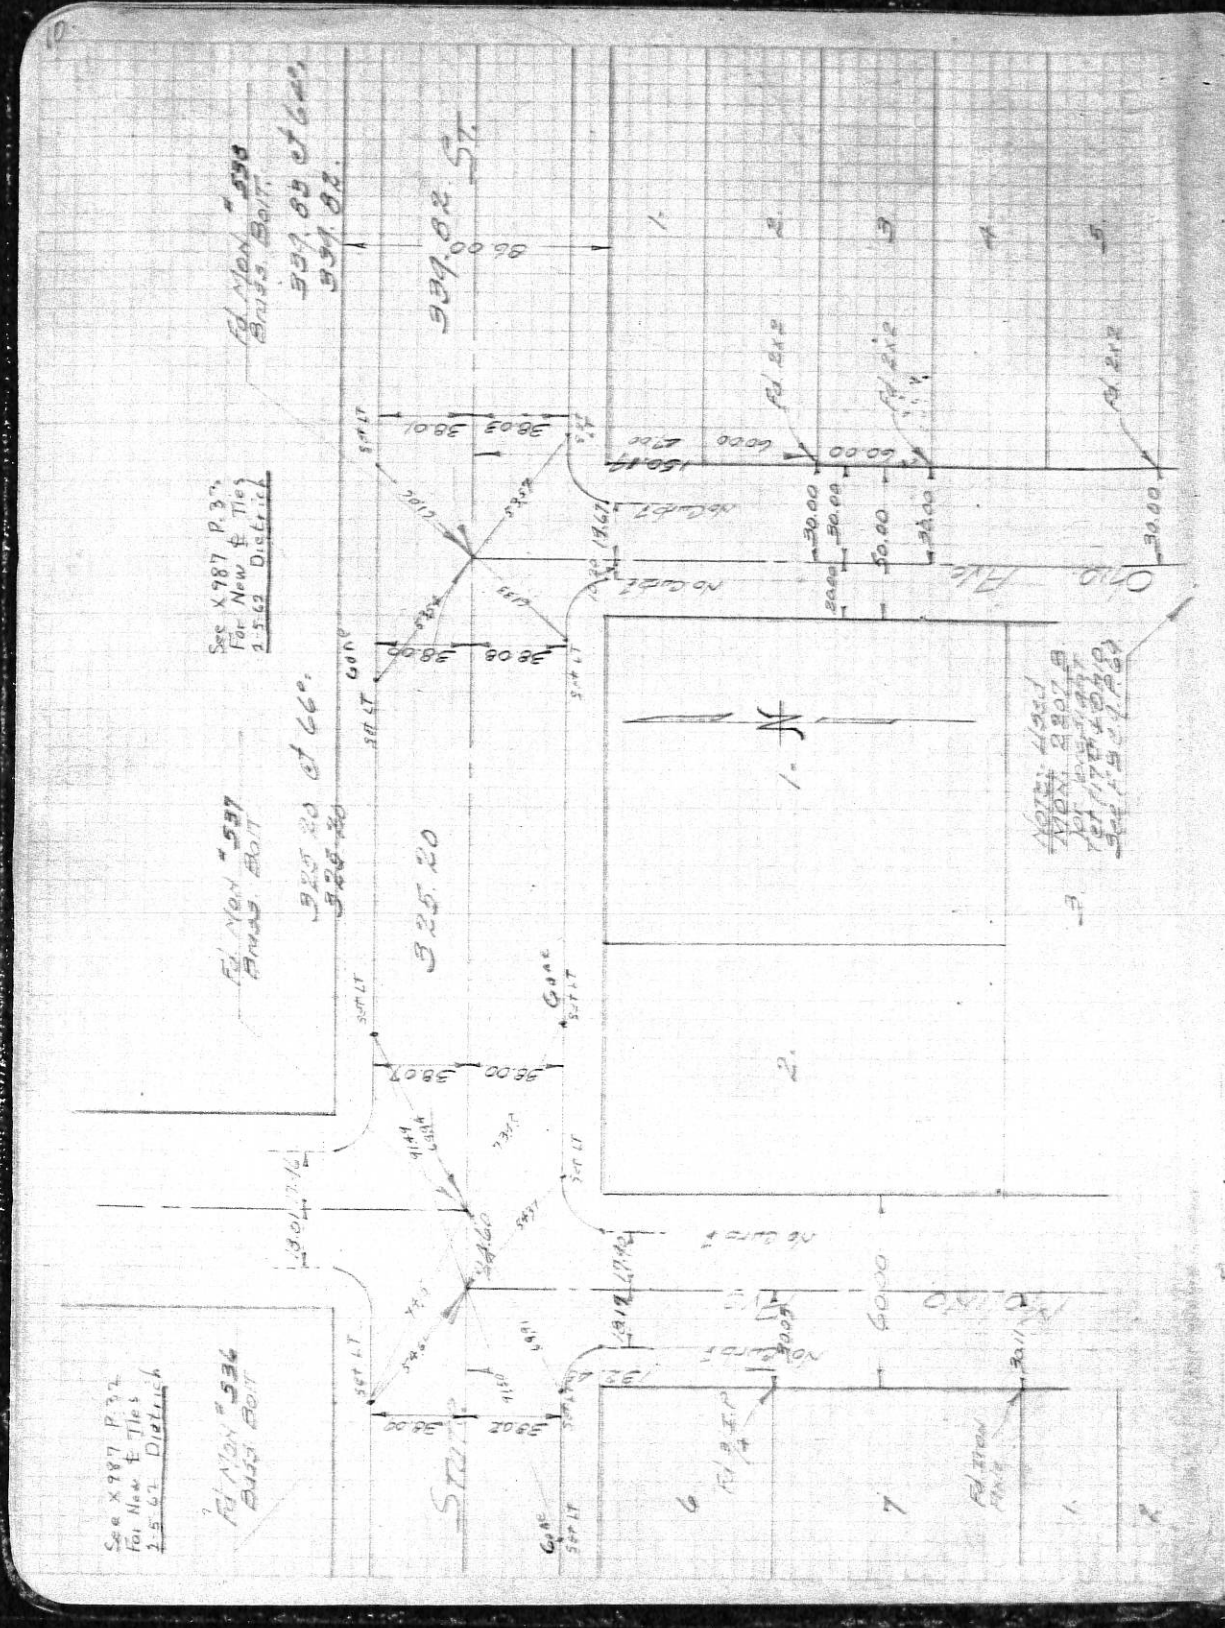

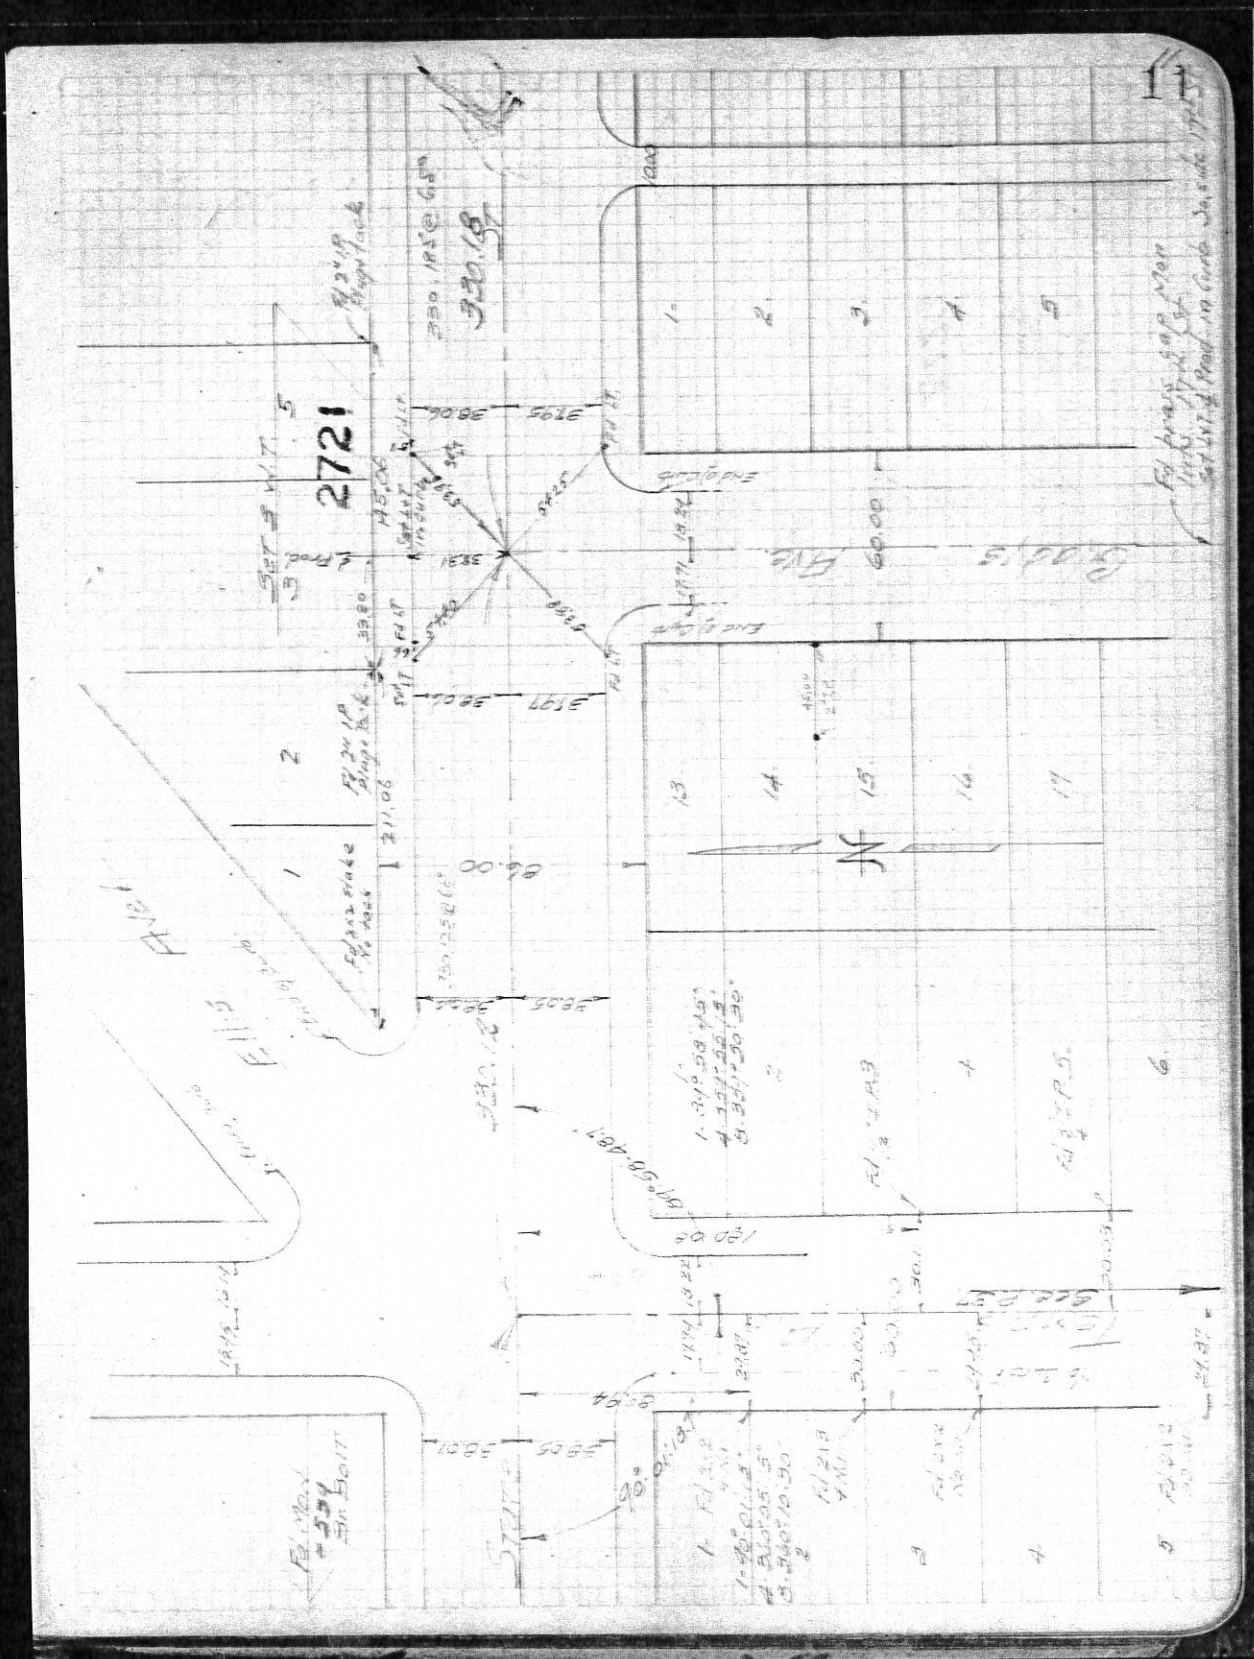

SURVEY OF CITY OF SIGNAL HILL
SURVEYED BY SMITH, APPLETON

JOB NO. 24362 BOOK _____
DATE 10-27-89

Bx


68


Robert Bein, William Frost & Associates
PROFESSIONAL ENGINEERS, PLANNERS & SURVEYORS
P.O. BOX 19739 • 14725 ALTON PARKWAY • IRVINE, CA 92718
(714) 472-3505

← TIES


SHT 8 OF 9

- ▲ = WELL MON PER CITY OF SIGNAL HILL
- = SET LEAD & TACK IN T.C.
- = SET L-NAIL W/TAG (BLANK)
- ⊥ = TANGENT OVER TIES

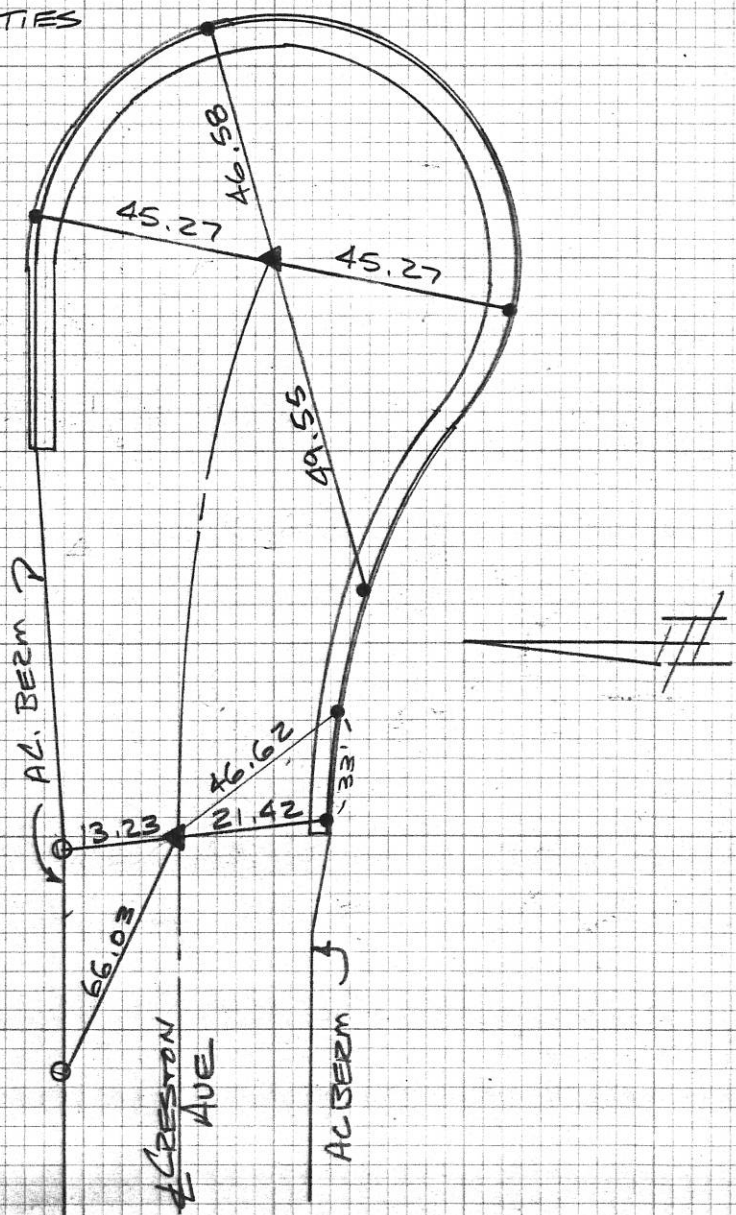

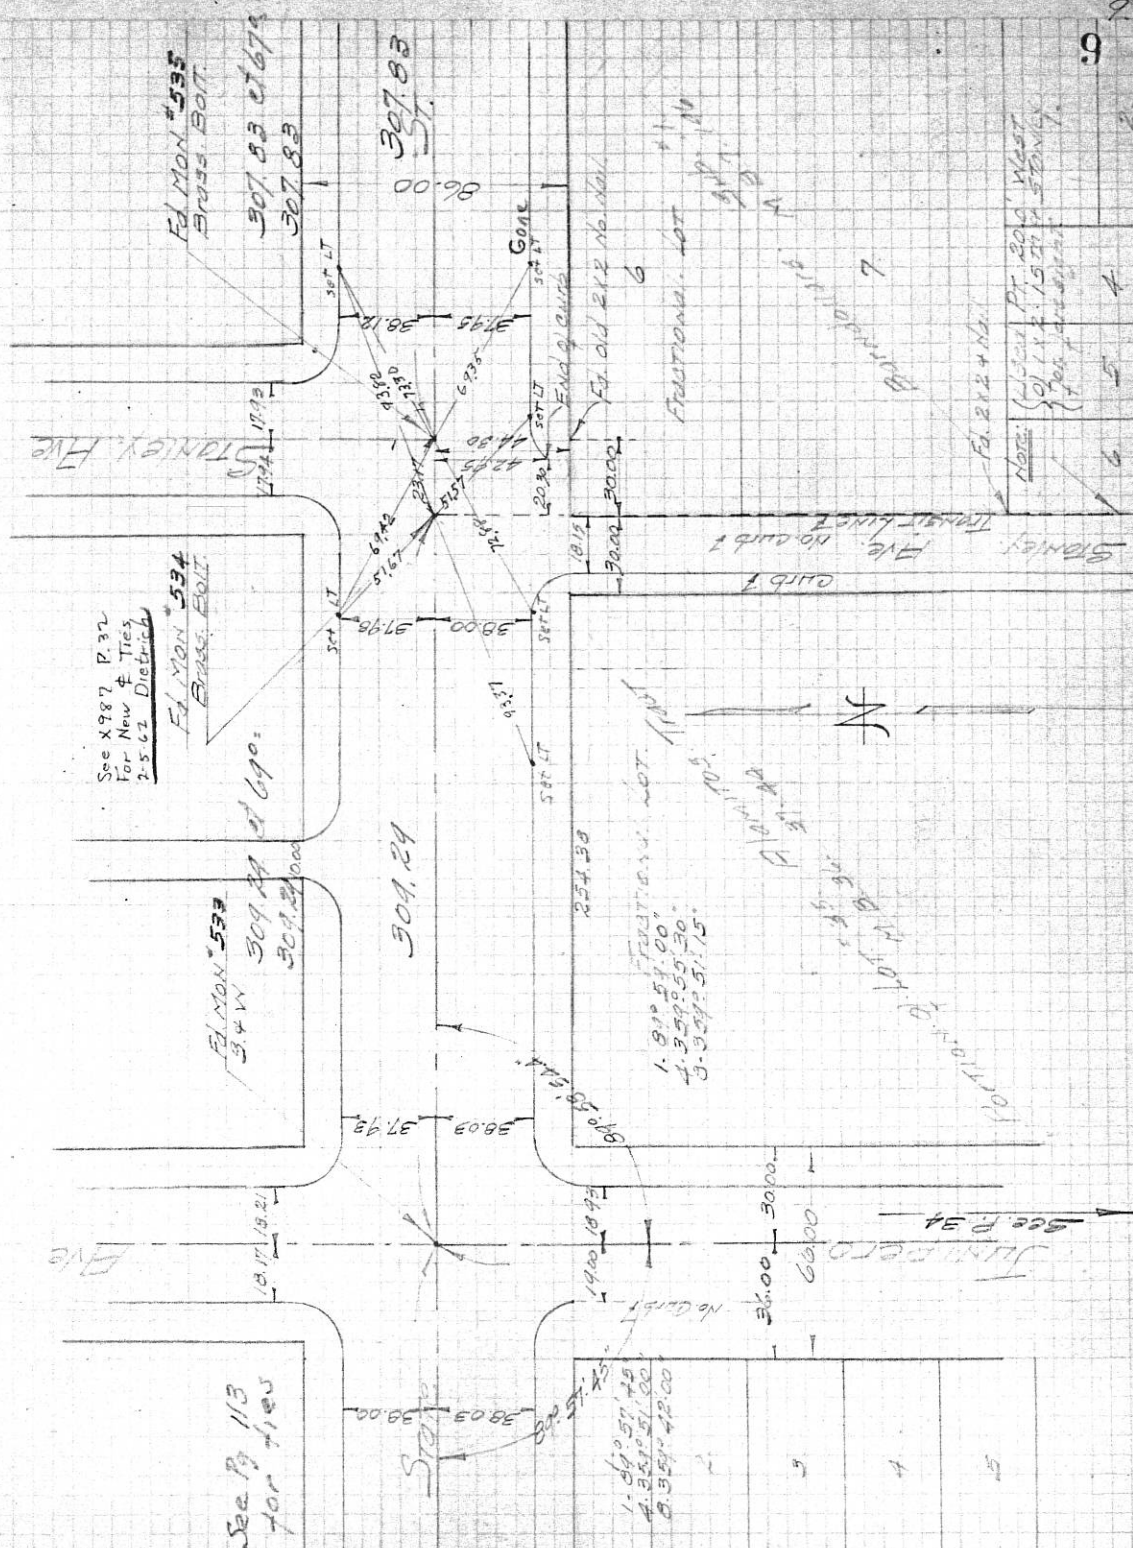


See page 58

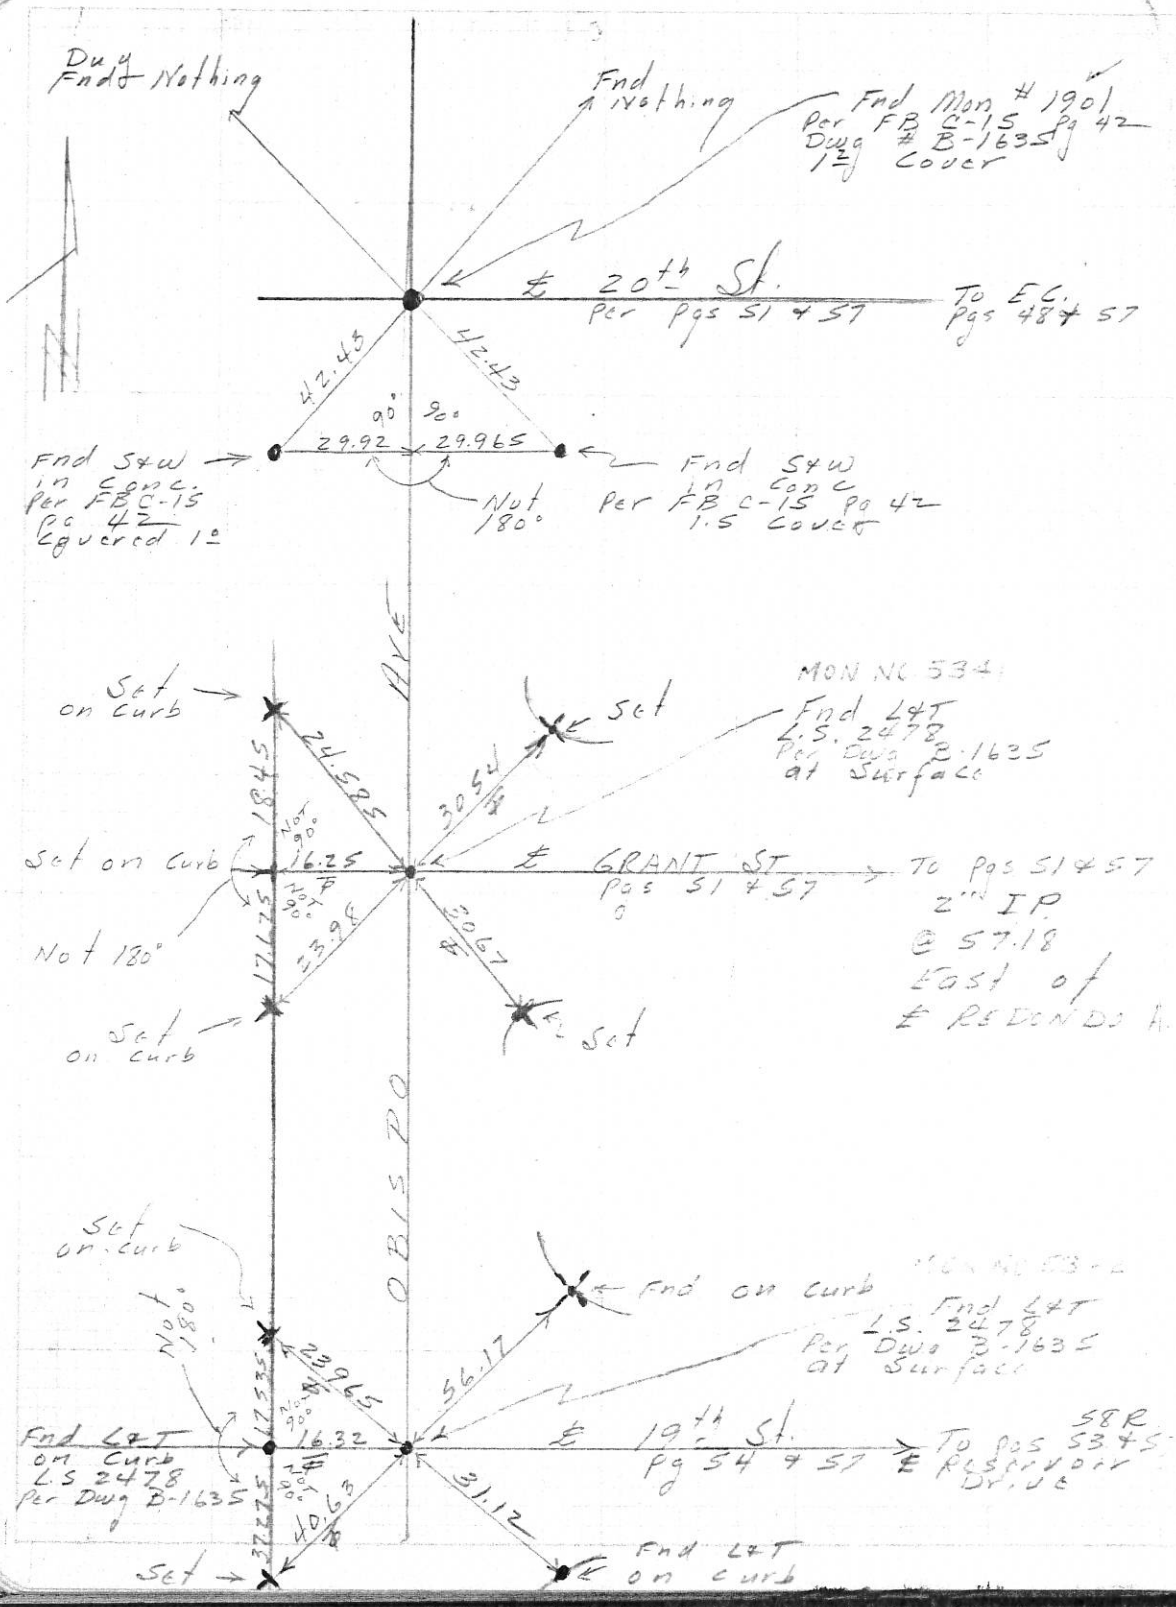






CITY OF SIGNAL HILL

2175 Cherry Avenue · Signal Hill, California 90806 · (310) 989-7300 · FAX (310) 989-7393/7391

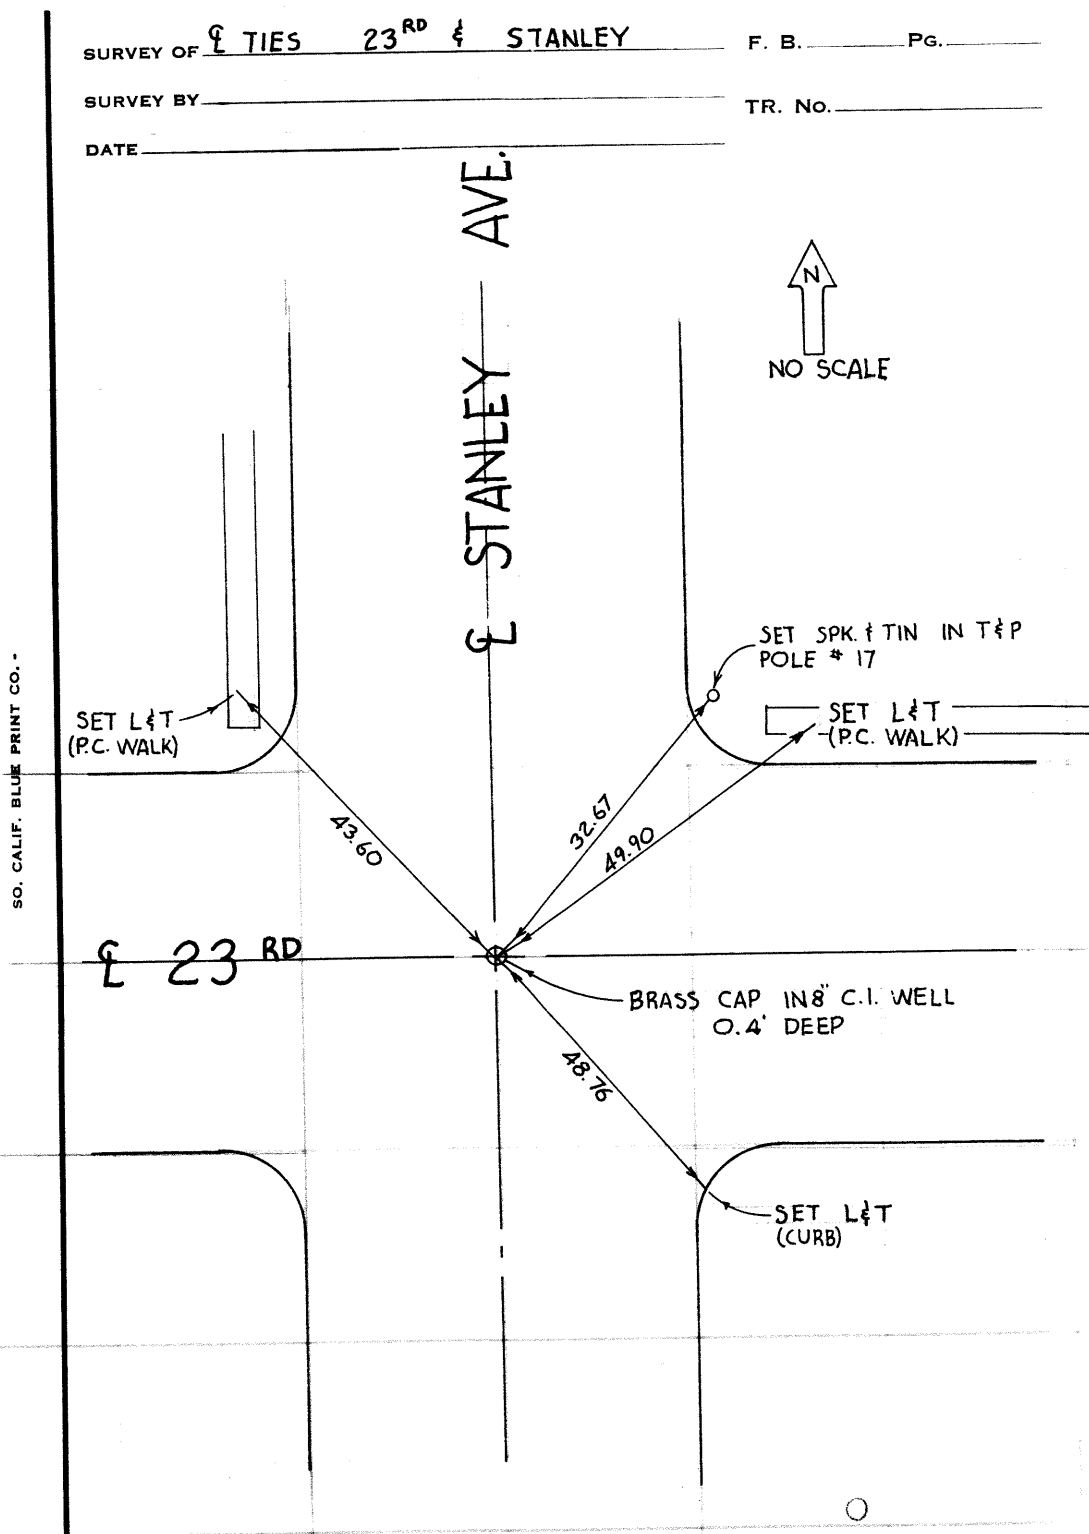

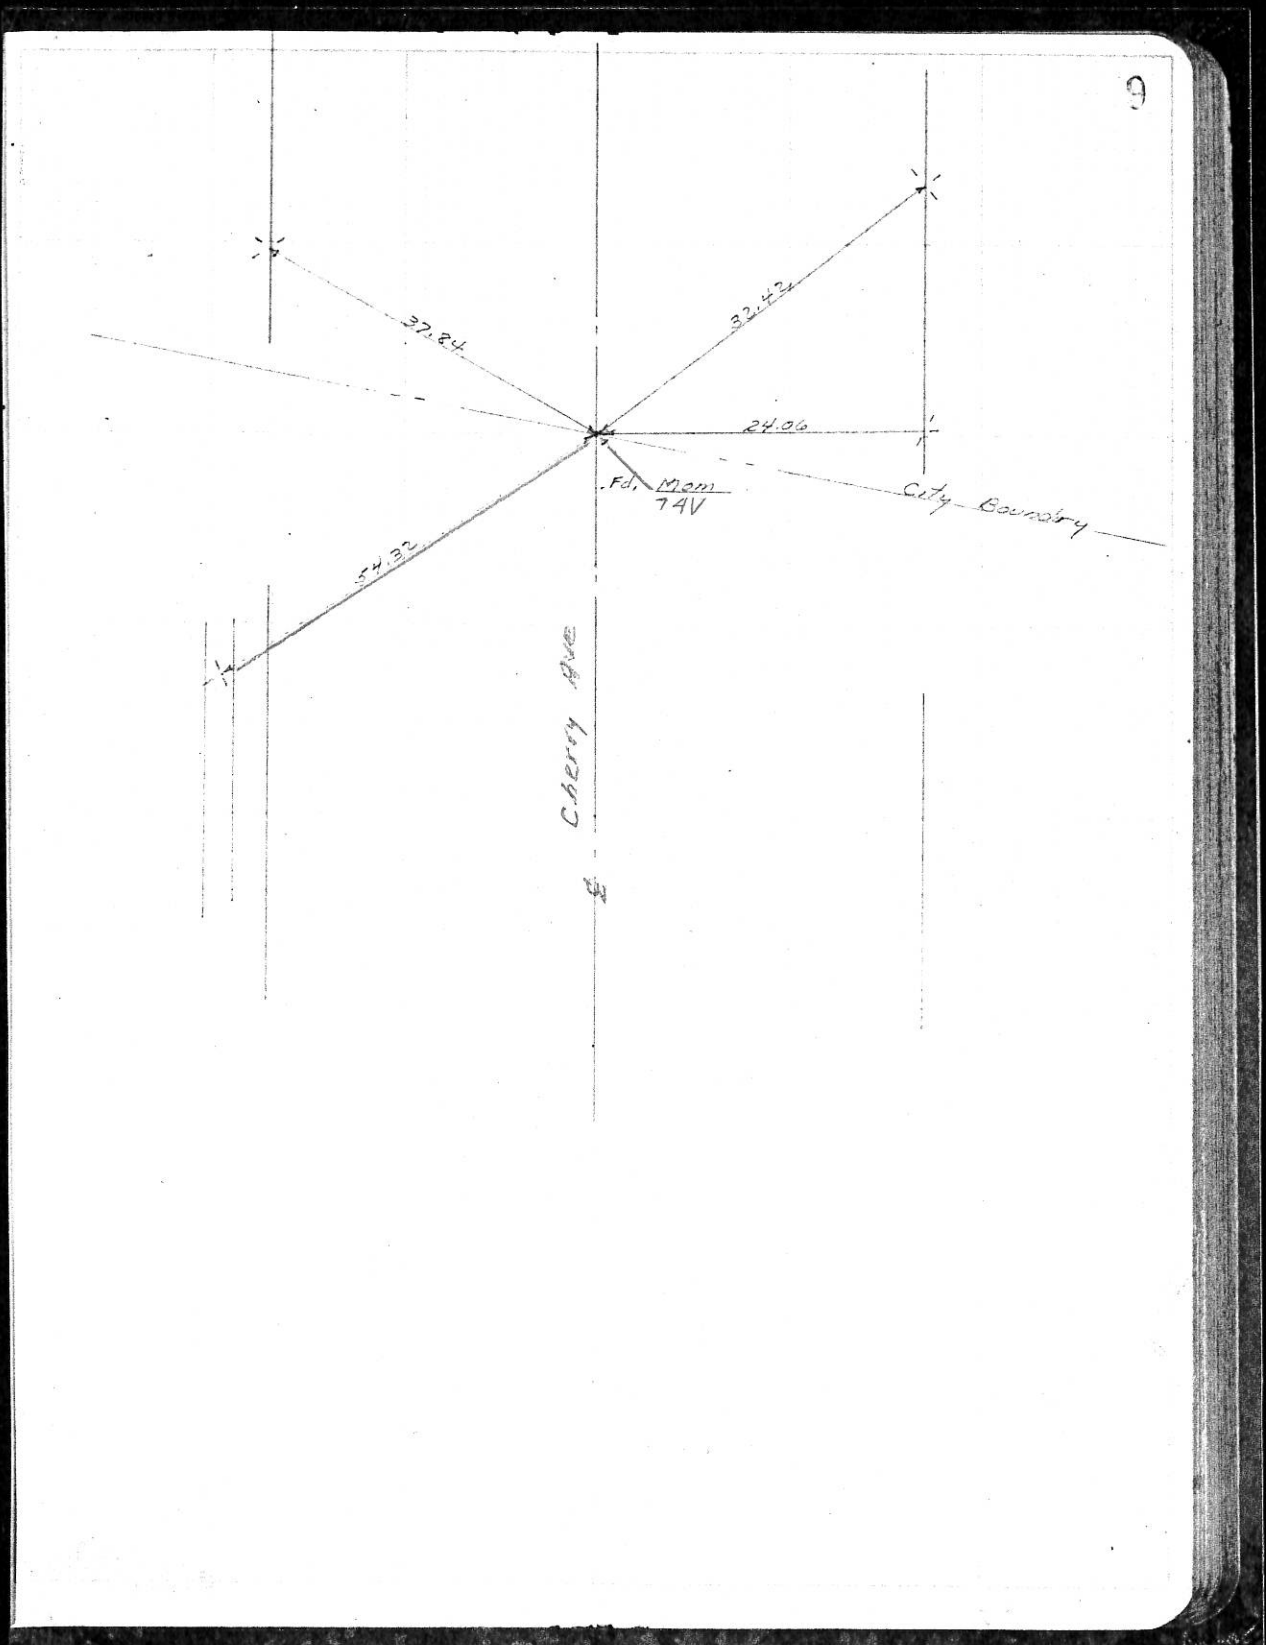


CHERRY & CITY BOUNDARY

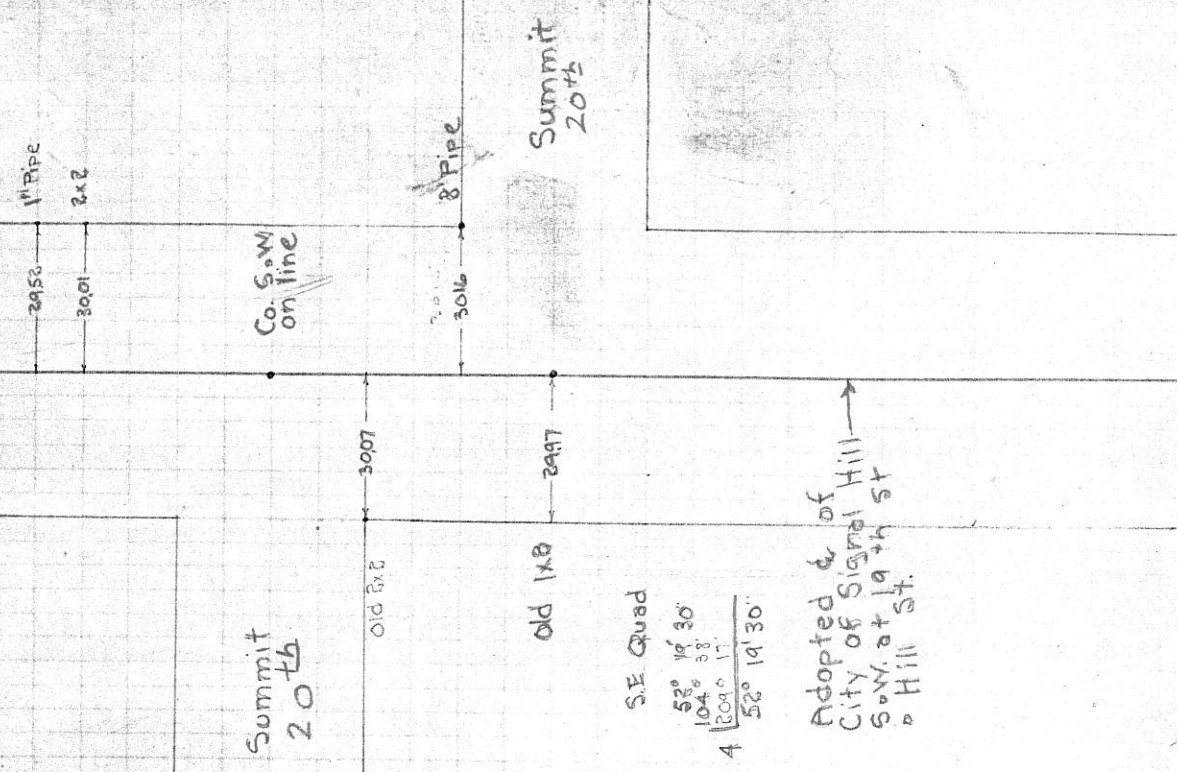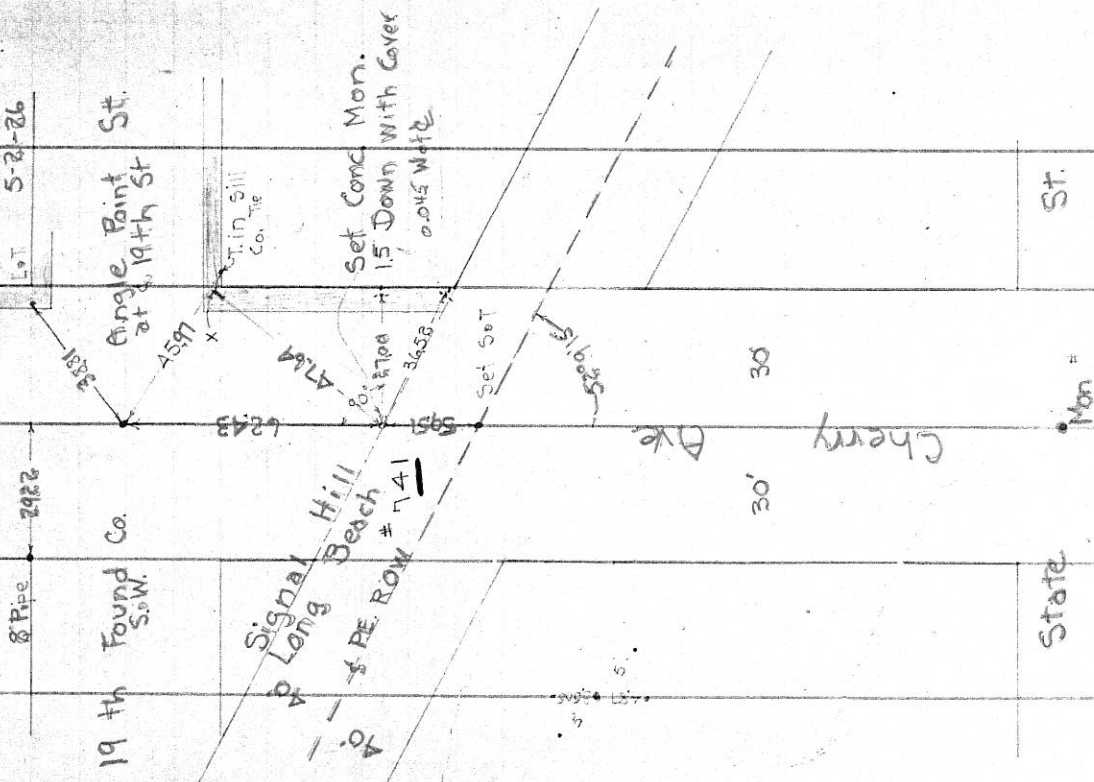

← TIES

Robert Bein, William Frost & Associates
 PROFESSIONAL ENGINEERS, PLANNERS & SURVEYORS
 P.O. BOX 19739 • 14725 ALTON PARKWAY • IRVINE, CA 92718
 (714) 472-3505 • FAX (714) 472-8373


SHT 7 OF 9

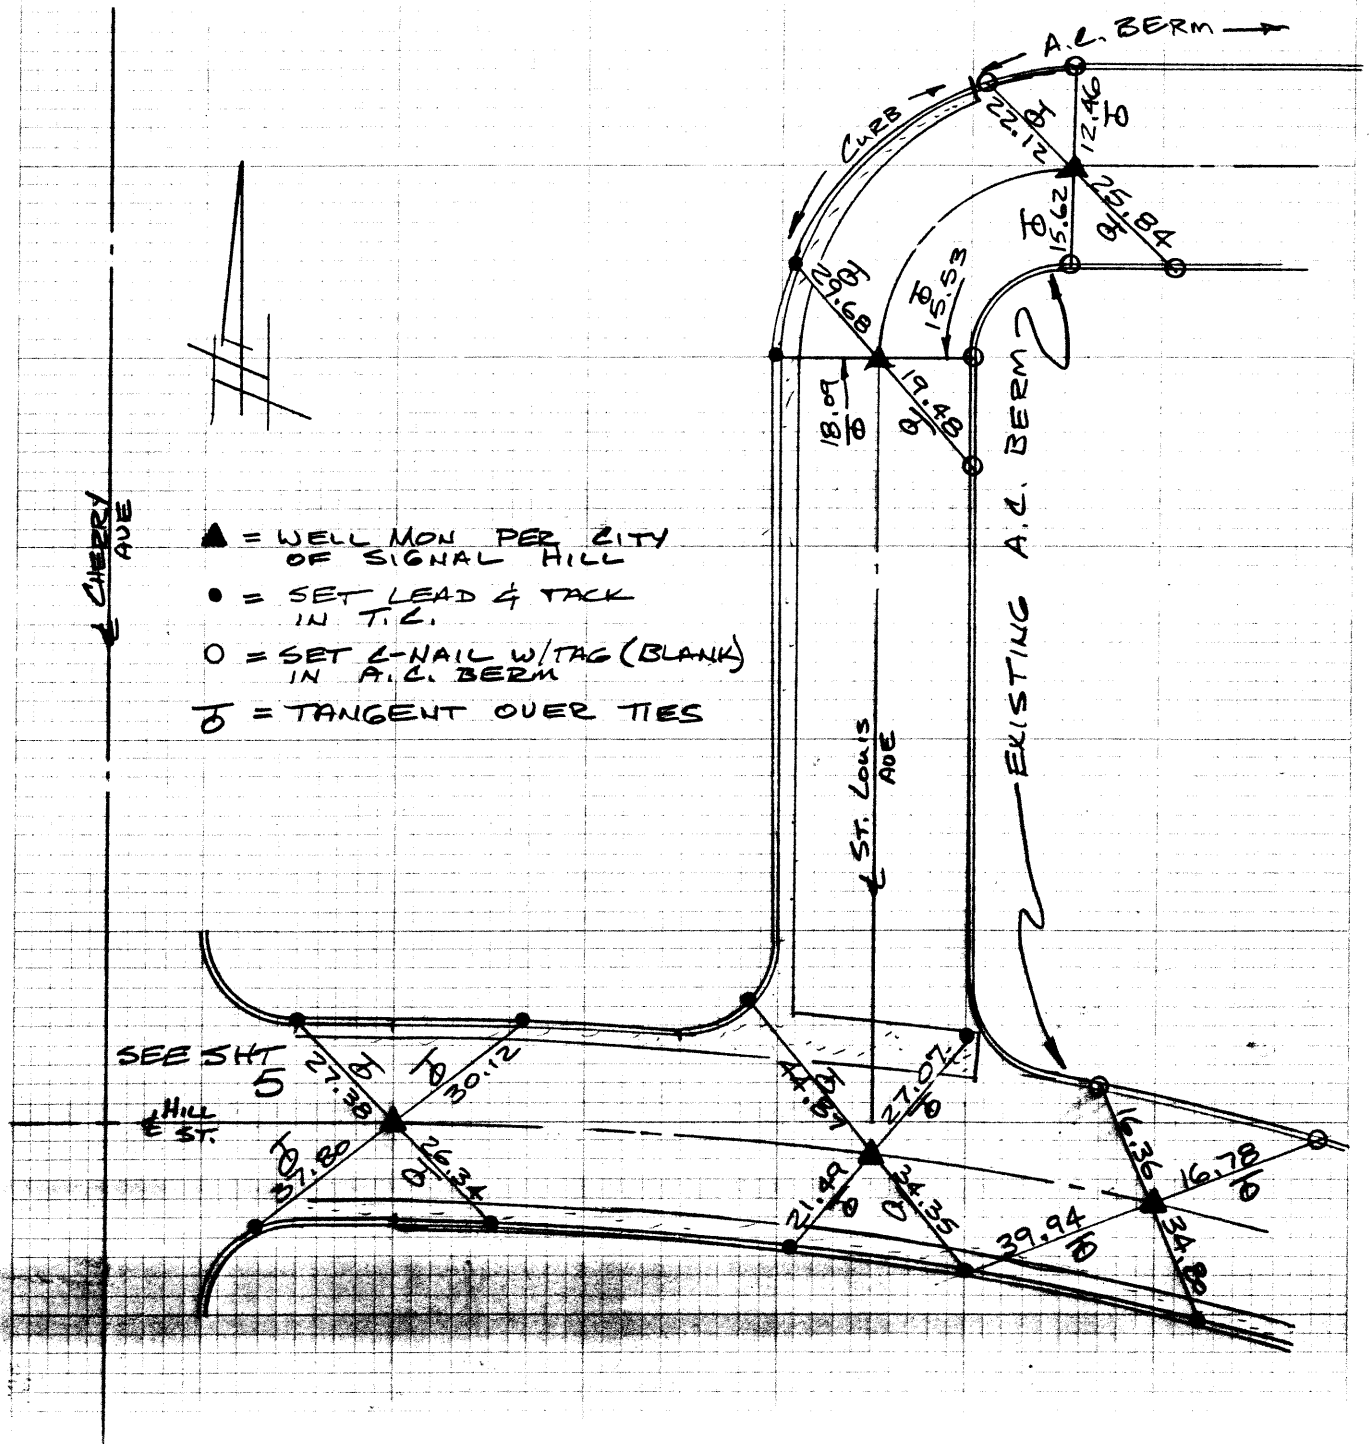

311.362

Long Lnd
5° with bands of fuf → ⊙

4f b1

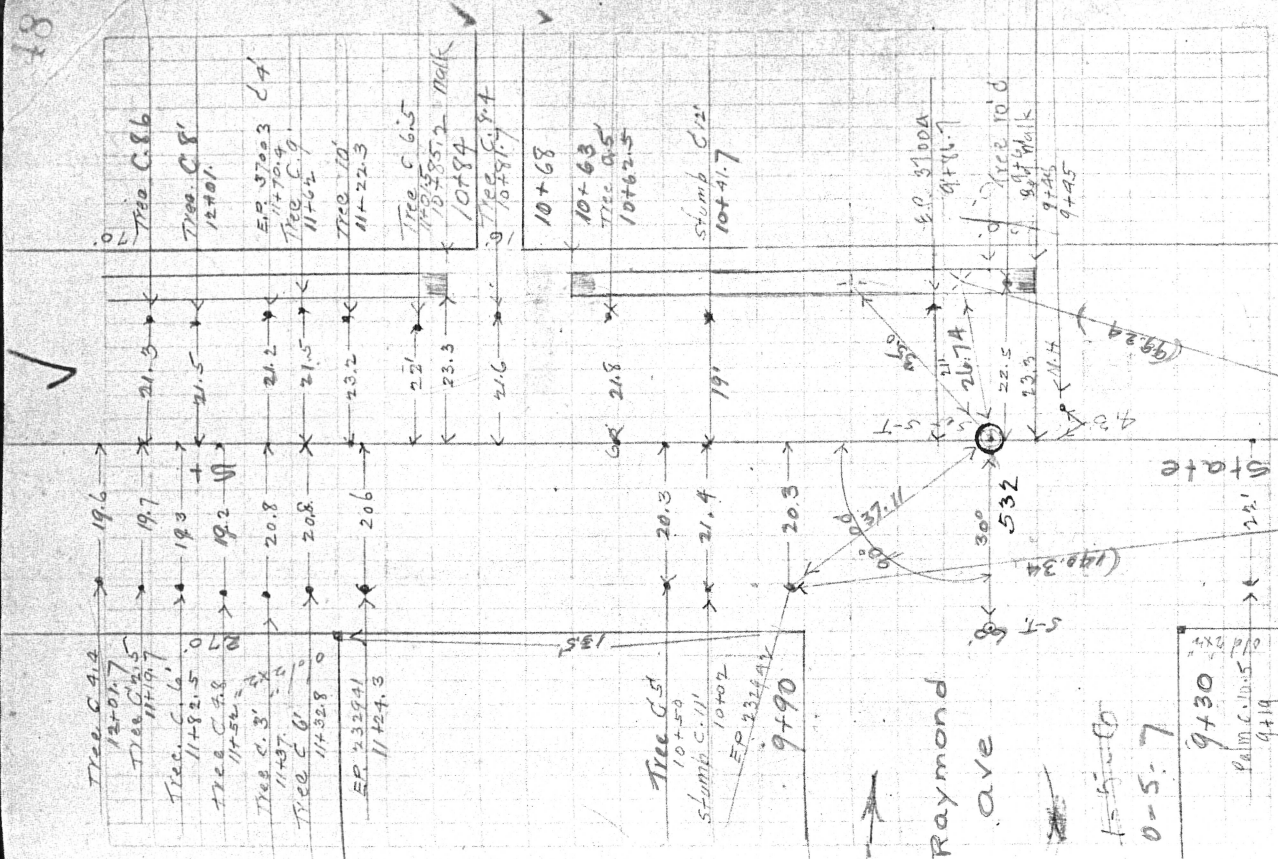

SURVEY OF CITY OF SIGNAL HILL

JOB NO. 24362

80

BOC.

75

SURVEYED BY BROWN, NAYLOR

DATE 10/23/89

☒ TIE NOTES FOR
JESSIE NELSON CIRCLE

Robert Bein, William Frost & Associates

PROFESSIONAL ENGINEERS, PLANNERS & SURVEYORS

P.O. BOX 19739 • 14725 ALTON PARKWAY • IRVINE, CA 92718


(714) 472-3505 • FAX (714) 472-8373

SHT 9 OF 9

▲ = WELL MON W/ BRASS DISK
PER CITY OF SIGNAL HILL

• = SET LEAD & TACK IN TOP OF CURB

Φ = TANGENT OVER TIES

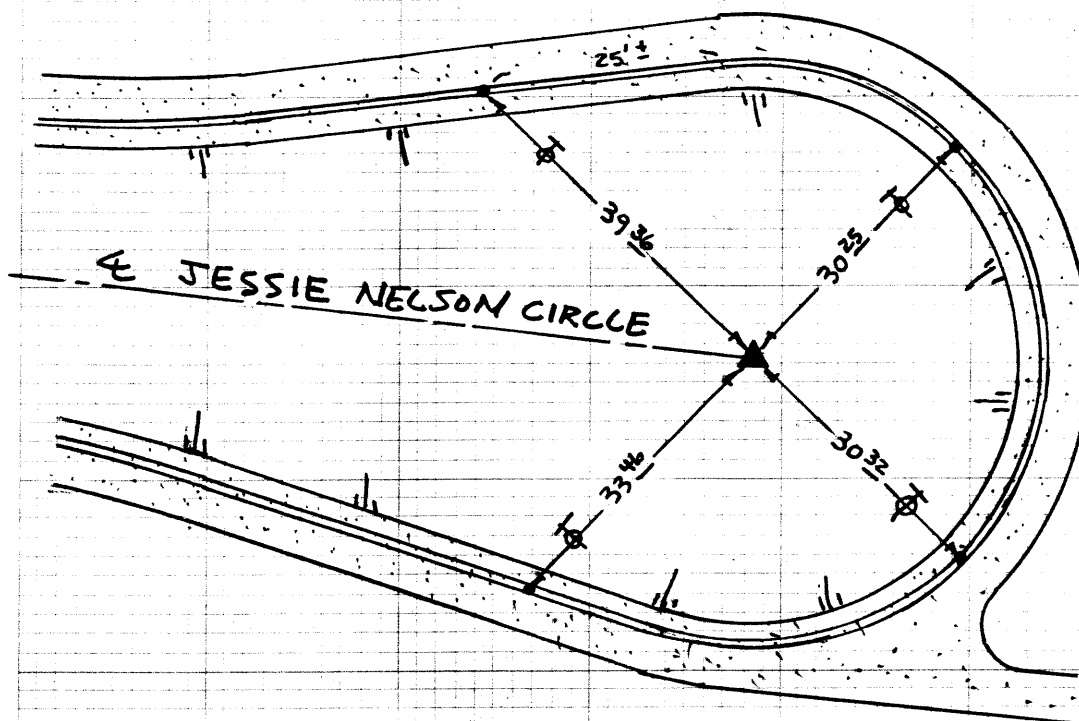



CITY OF SIGNAL HILL

2175 Cherry Avenue · Signal Hill, California 90806 · (310) 989-7300 · FAX (310) 989-7393/7391


SURVEY OF TEMPLE AVENUE F B NO. PAGE
 SURVEY BY R.V. PEARSALL INC. TRACT NO. 35747
 DATE 1/15/79

NO SCALE

L.S. 2488

SURVEYORS SERVICE COMPANY · COSTA MESA · STOCK NO. 411

DO NOT EXTEND NOTES THIS SIDE OF LINE

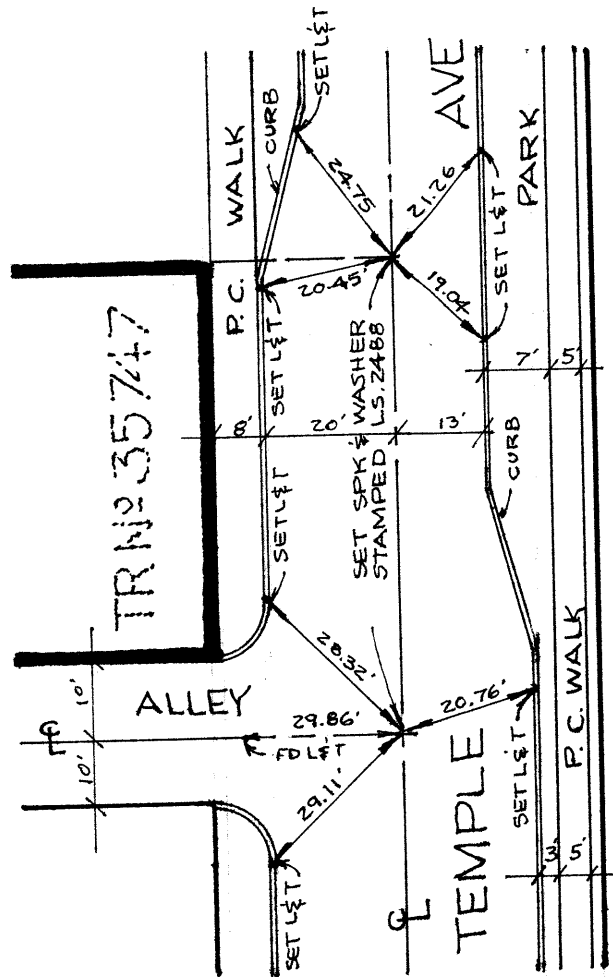



CITY OF SIGNAL HILL


2175 Cherry Avenue Signal Hill, California 90806 (310) 989-7300 FAX (310) 989-7393/7391


Profile		Notes Red	Plotted	Job No.	Division No.	F.B.	Pg.
No.	Date			Survey of	<u>4 TIES AT WALNUT AV & 21ST ST</u>		
X-Sec.	Notes Chkd.	Checked	Survey by	<u>RBF</u>	Notes <u>RBF</u>	Date	<u>NOV 1983</u>
No.	Date	Date	Map No.	Indexed	Date		

NOTE: ANY ADDITIONS OR CHANGES ON THIS SHEET MUST BE MADE OR CIRCLED IN RED INK. WITH DATE AND NAME OF PERSON MAKING CHANGE

PLEASE RETURN TO
SIGNAL HILL
ENGINEERING DEPT.
2175 CHERRY AVE.
SIGNAL HILL, CALIFORNIA

Do not extend notes this side of this line.

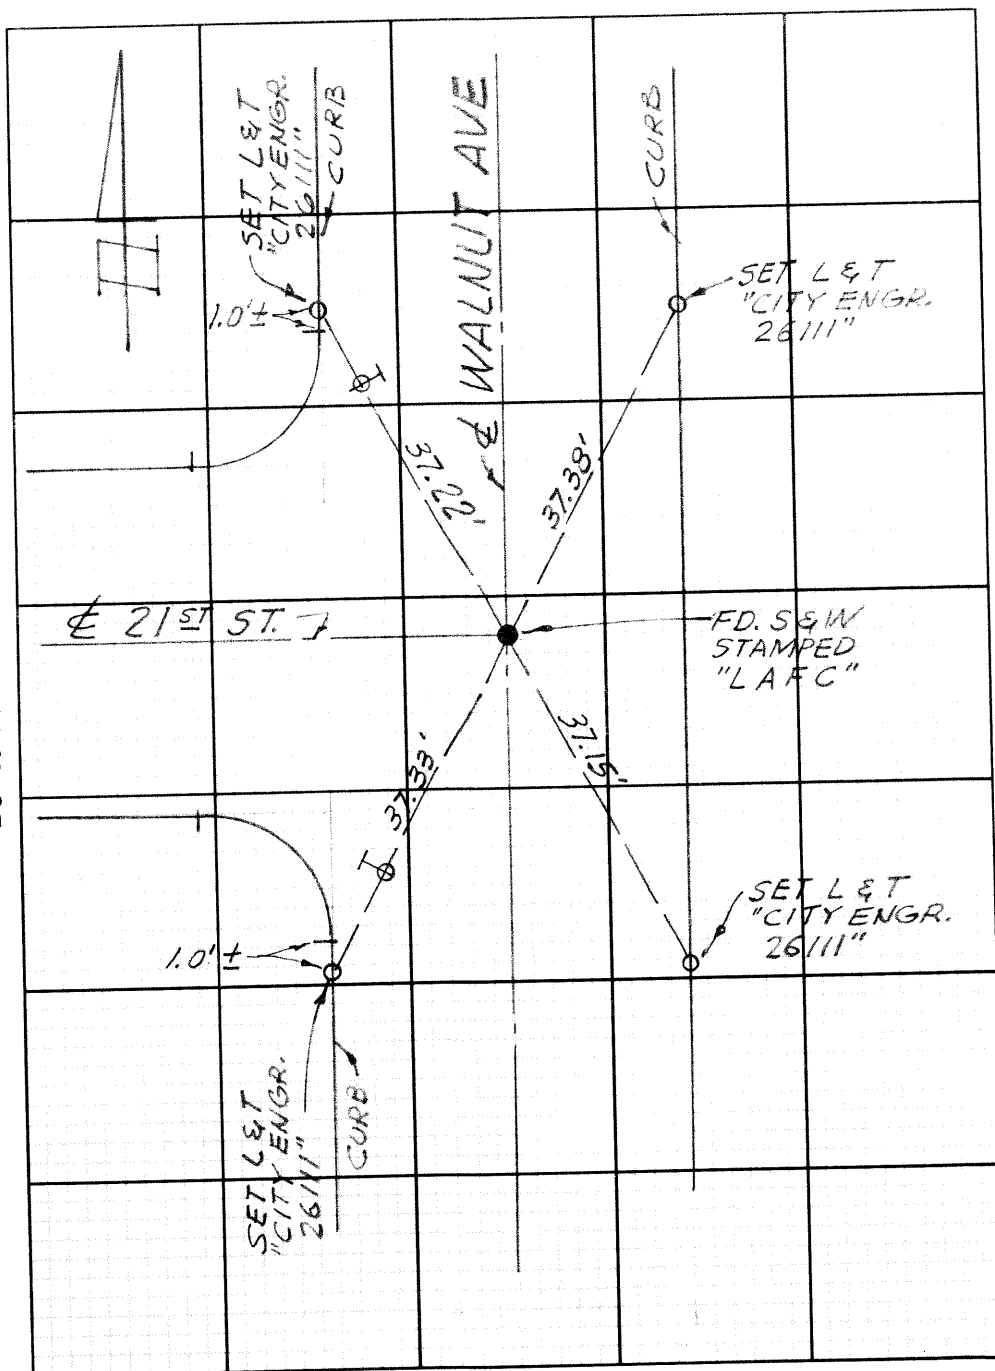

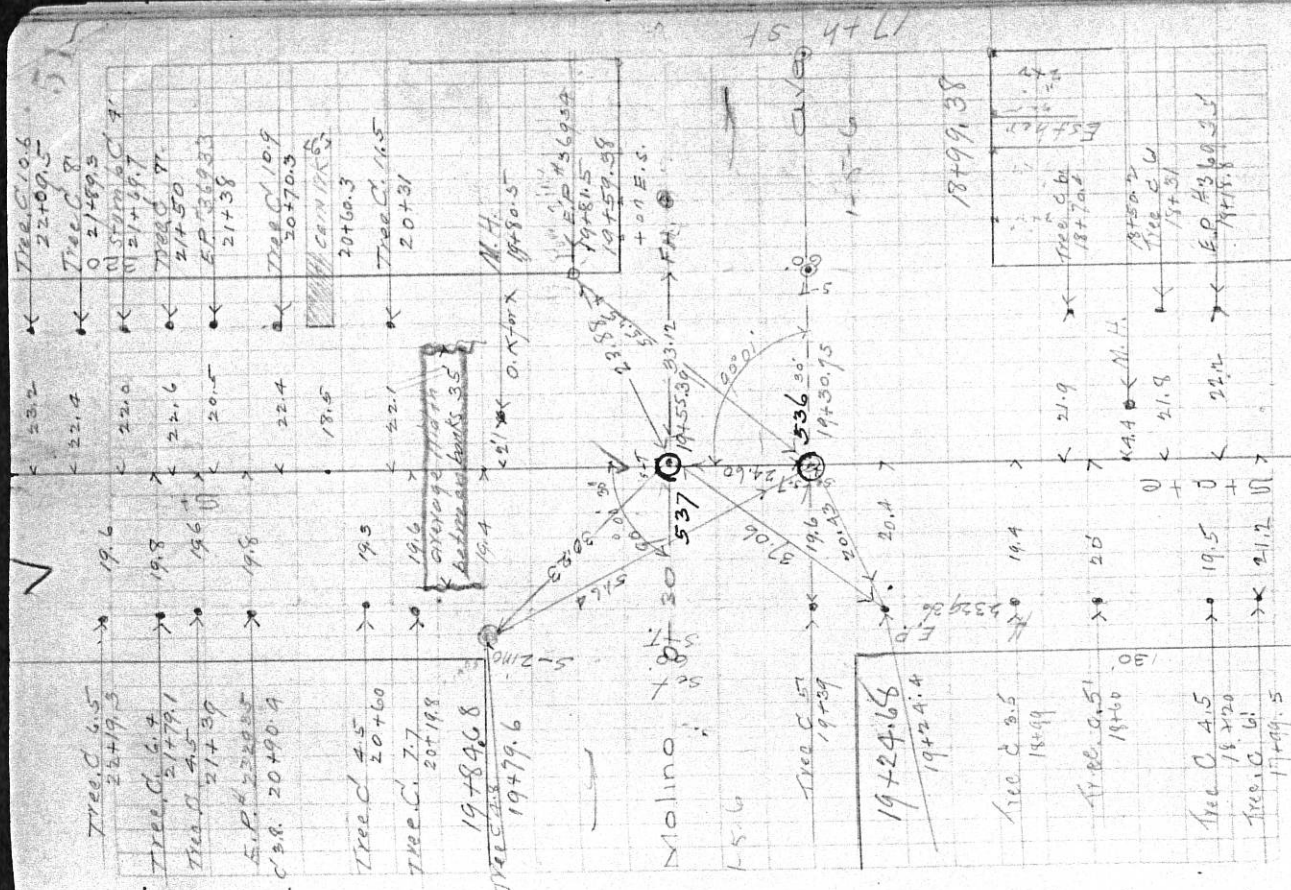

30
T. P. Sargent Hill
City, Ind.

2077

F.P. #36952

10/10/10

$$u\bar{u} \times u\bar{u}$$

Boy 10/12

11011

75



CITY OF SIGNAL HILL


2175 Cherry Avenue Signal Hill, California 90806 (310) 989-7300 FAX (310) 989-7393/7391

				F. B.		Pg.	
Profile	Notes Red	Plotted	Job No.	Division No.			
No.	Date	Date	Survey of	<u>ETIES AT GUNDRY AV & HILL ST</u>			
X-Sec.	Notes Chkd.	Checked	Survey by	<u>RBF</u>	Notes	<u>RBF</u>	Date <u>NOV 1983</u>
No.	Date	Date	Map No.	Indexed	Date		

NOTE: ANY ADDITIONS OR CHANGES
ON THIS SHEET MUST BE MADE OR
CIRCLED IN RED INK, WITH DATE AND
NAME OF PERSON MAKING CHANGE

Do not extend notes this side of this line.

PLEASE RETURN TO
SIGNAL HILL
ENGINEERING DEPT.
2175 CHERRY AVE.
SIGNAL HILL, CALIFORNIA

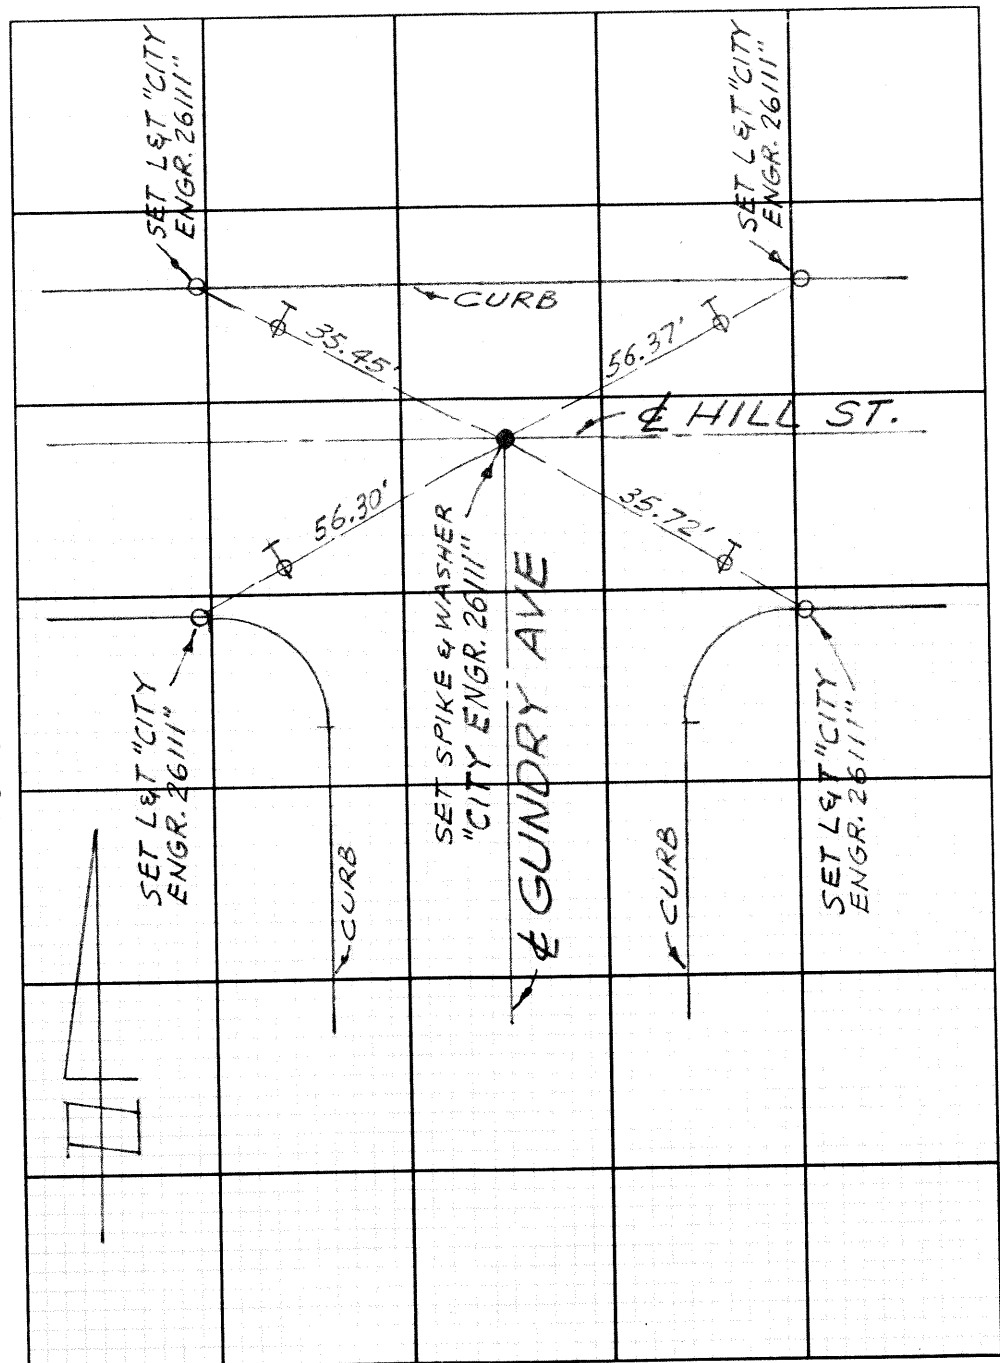




CITY OF SIGNAL HILL

2175 Cherry Avenue Signal Hill, California 90806 (310) 989-7300 FAX (310) 989-7393/7391

SURVEY OF E TIES 23RD ST. F. B. 2 Pg. 200
 SURVEY BY R.V. PEARSELL INC L.S. 1339 TR. No. 32814
 DATE 12/1/76

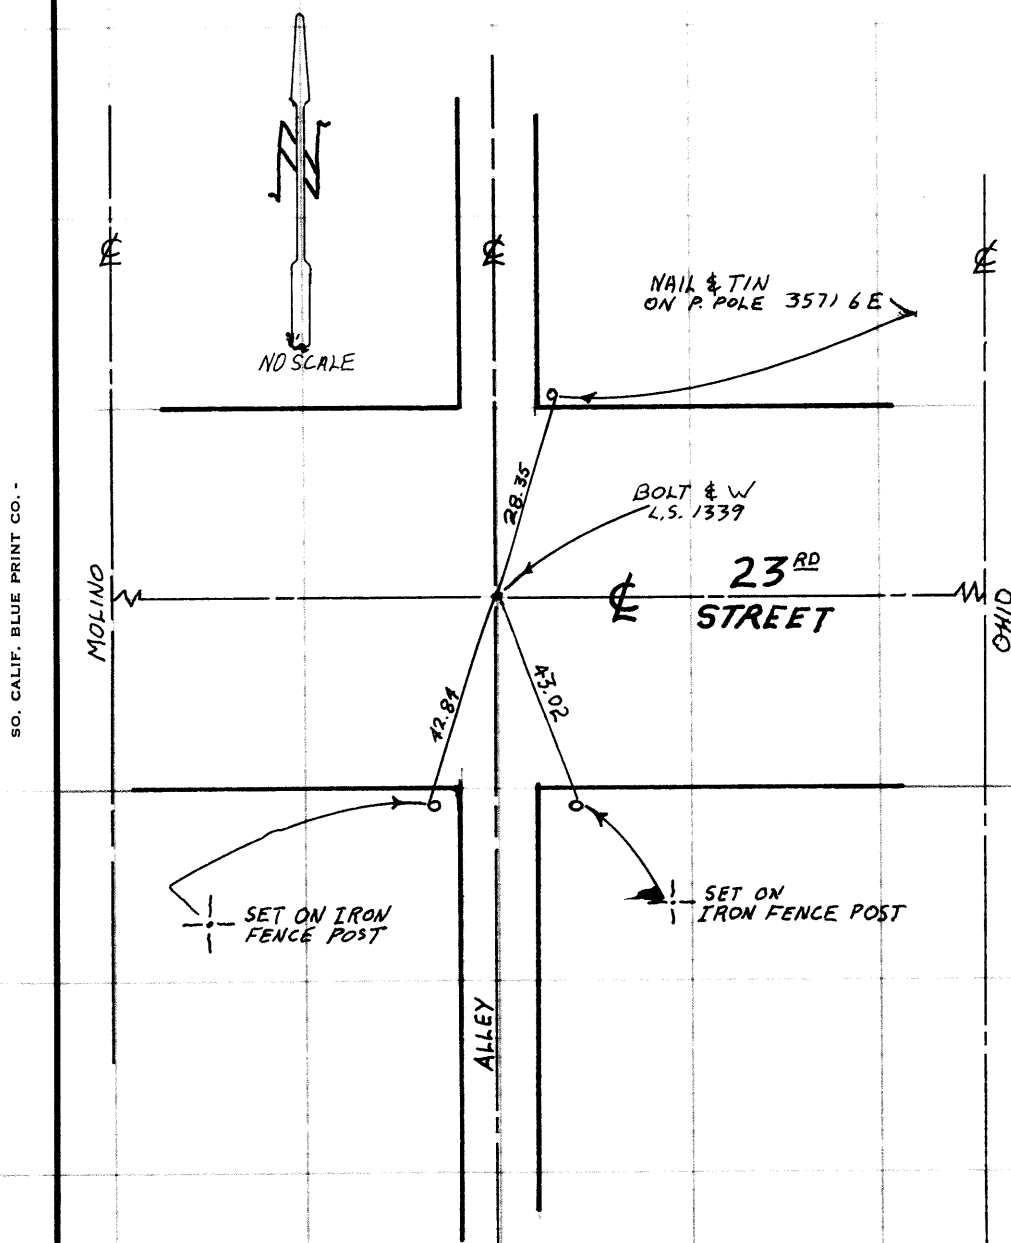



CITY OF SIGNAL HILL


2175 Cherry Avenue Signal Hill, California 90806 (310) 989-7300 FAX (310) 989-7393/7391

SURVEY OF JUNIPERO AVE & 20TH ST F B NO. PAGE
SURVEY BY R.V. PEARSALL INC. TRACT NO. 38888
DATE DEC 17, 1980

NO SCALE L.S. 2488


SURVEYORS SERVICE COMPANY ASTA MESA - STOCK NO. 411

DO NOT EXTEND NOTES THIS SIDE OF LINE

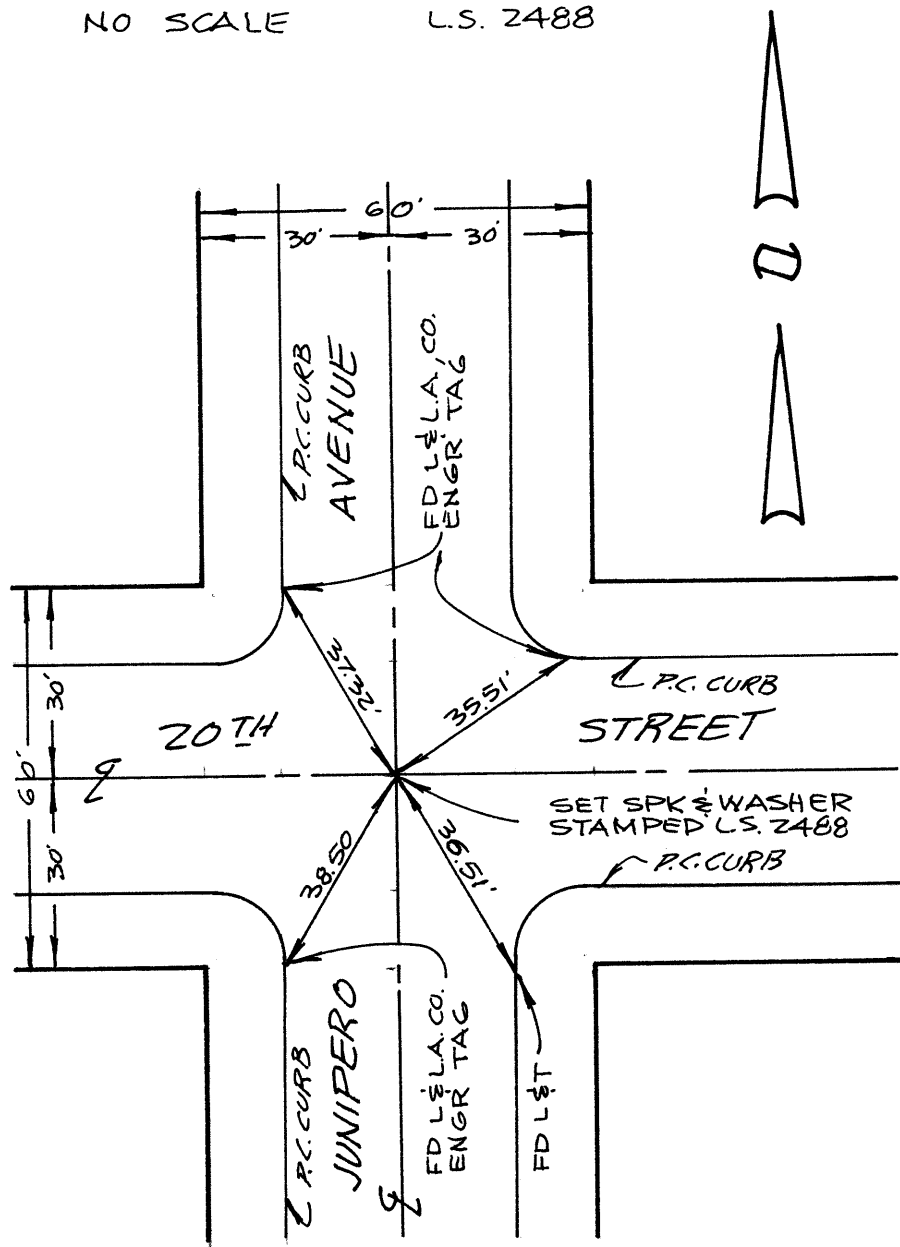

See page 58

CLB.F.B. X 957 M 136

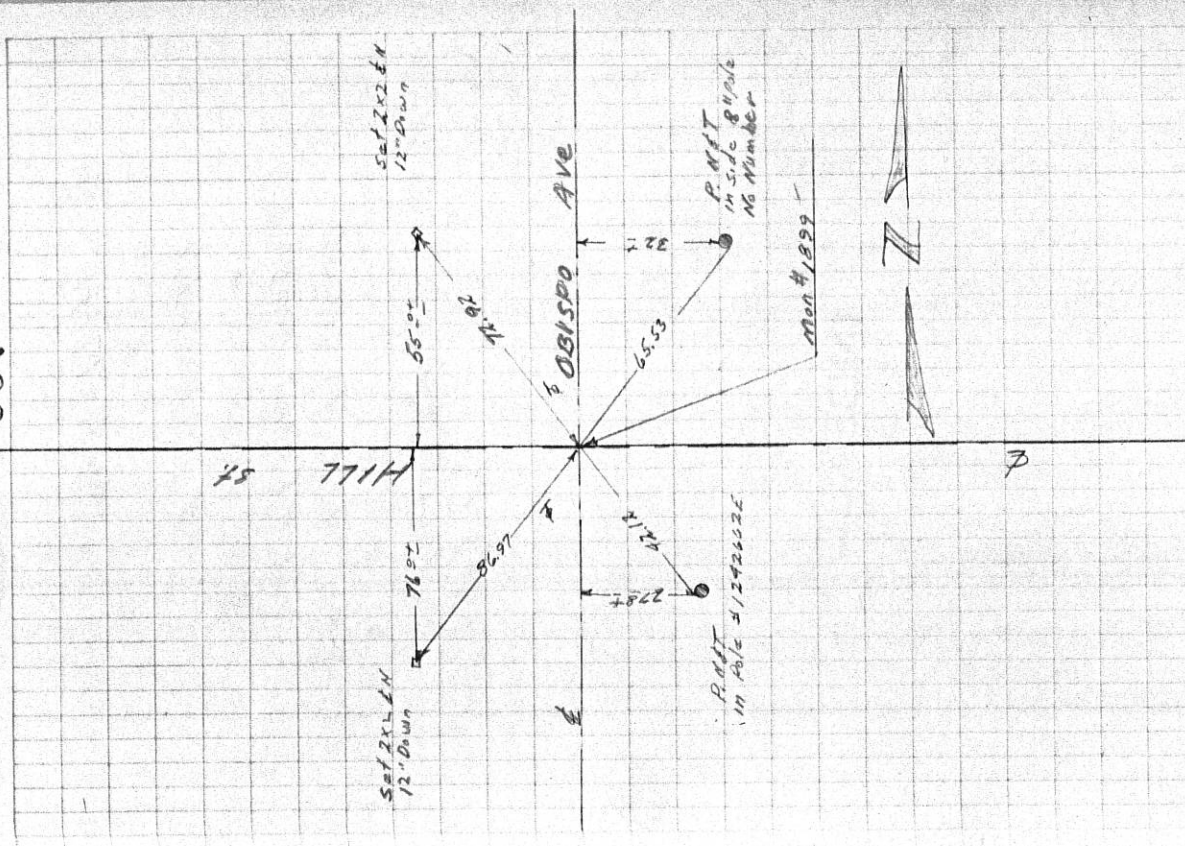

CLB.F.B. X 957 M 135

HILL Street
&
OBISPO Ave.

Additional Ties to E

Job No. 33.36 Ref. F.D.C. 725 p. 113

Feb 28, 1961

INDEXED

CLB.F.B. X 957 M 135

F. B. 1483 PG. 20

Cont. on bot. pg. 21

1501.43 T = 58° = ✓
1501.33

150/23

316

Set "X" in Car
Gate Post.

HILL ST

Set N+T P.P.
619052E

Set N+J P.P.
= (Yane)

Set Bt spk & wh fl
10-19-19 2AS
Fd 2X2+N-18" dn
an adopted & Int
Per F.B. 293-162
Set 2-3' ties.

Ed. Spr. Spk. in Conc
Mon. 18" dn per.
EB 293-162

JOHN T. P. & GUY P.
515599 E

Prop. Hathaway Ave. p. 1-2
C.S.B. 644
- 58- 36771

367.737:58:367.7

14 Sec. Cor.
Fd. Spr. Spk. in Conc
Mon. 24 Cdn. per
FB 293-145-162

W.S. 30-D-4

293-16

RETURN TO
LOS ANGELES COUNTY SURVEYOR
700 HALL STREET
RECORDS

Do not extend notes this side of this line

Note: Any Additions or Changes on This Sheet Must be Made in Red Ink With Date and Name of Person Making Change.

LOS ANGELES COUNTY SURVEYOR
700 HALL RECORDS


Note: Any Additions or Changes on This Sheet Must be Made in Red Ink With Date and Name of Person Making Change.

Do not extend notes this side of this line.

m
D
m
S.M.

Notes Ck'd by <u>LDm-gp</u>	Survey of <u>A. G. L. B. Benson</u>
Map No. <u>B-2167-1</u>	W. O. <u>3502</u> Tape No. <u>273</u> St'd <u>68</u> *F
Office Work <u>Willmer</u>	Surveyed by <u>Benson</u>
Checked ' <u> </u>	Notes <u>11</u> Date <u> </u>
Date <u> </u>	Indexed <u>A. C. Johnson</u>

F. B. _____ PG

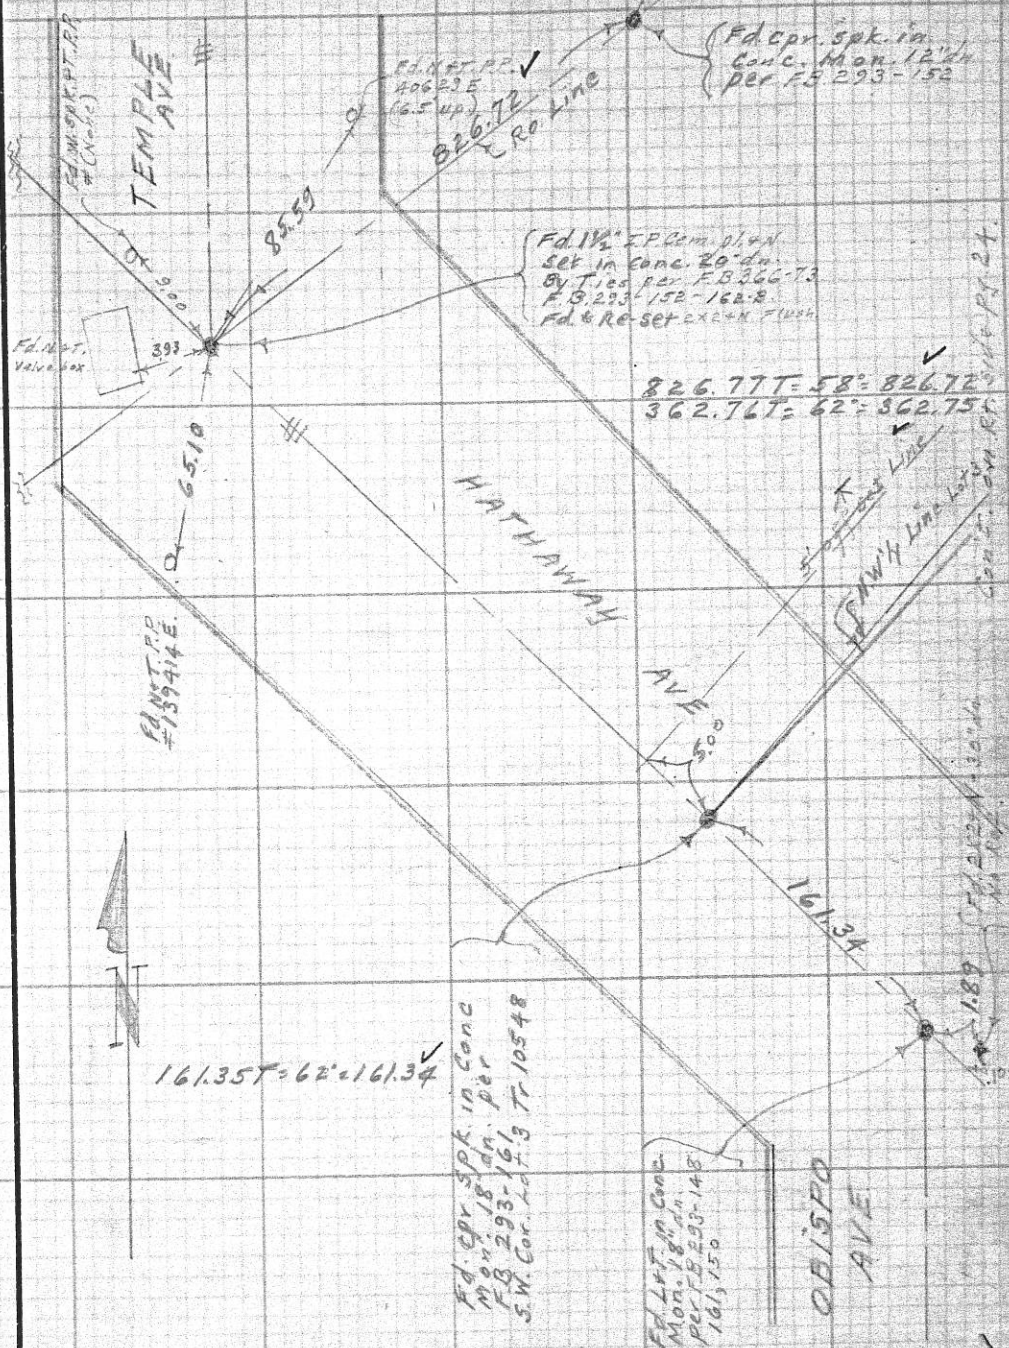

FORM 247 5M 10-39

RETURN TO
LOS ANGELES COUNTY SURVEYOR
700 HALL OF RECORDS

Note: Any Additions or Changes on This Sheet Must be Made or Circled in Red Ink With Date and Name of Person Making Change.


Do not extend notes this side of this line.

WS30-D3

Notes Ck'd by	Survey of <u>Long Beach</u>
Map No.	W. O. <u>1111</u> Tape No. <u>076</u> St'd <u>68°F</u>
Office Work	Surveyed by <u>R. R. Emmott</u>
Checked	Notes <u>R. R. W.</u> Date <u>6-14-40</u>
Date	Indexed <u>A. C. Johns</u>

F.B. 923 Pg. 67

WS 30

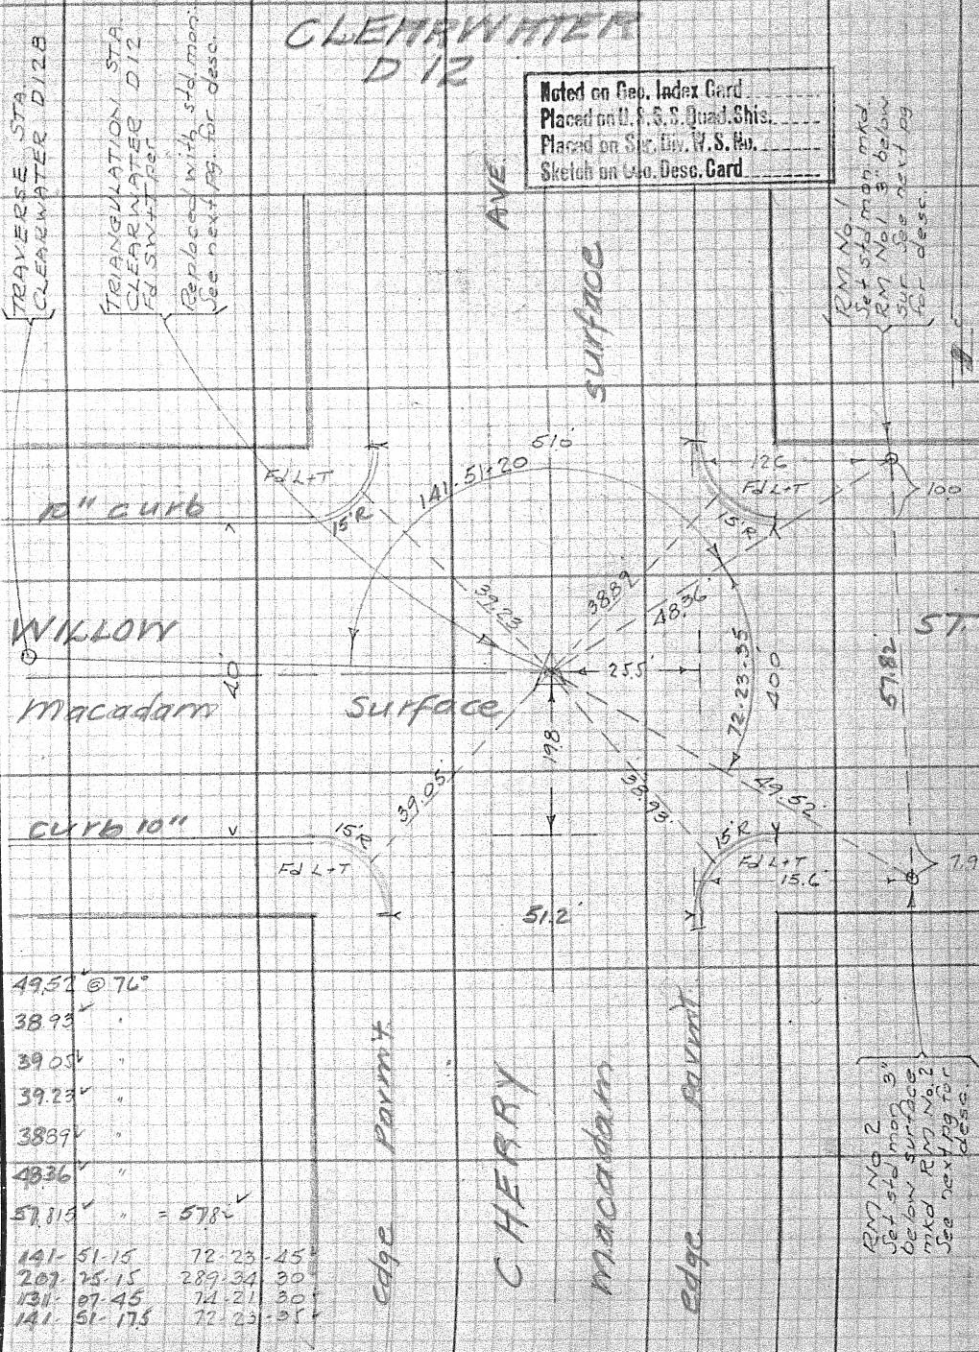

Noted on Geo. Index Card
Placed on U. S. S. Quad. Shis.
Placed on Sur. Div. W. S. No.
Sketch on Geo. Desc. Card

RM No. 1
Set std. man. mtd.
RM No. 1 3' below
SUR. See next pg.
for desc.


RM No. 2
Set std. man. mtd.
below surface
mtd. RM No. 2
See next pg. for
desc.



CITY OF SIGNAL HILL

2175 Cherry Avenue Signal Hill, California 90806 (310) 989-7300 FAX (310) 989-7393/7391

SURVEY OF HILL ST. & INTERSECTION ROSE AVE F B NO 45 PAGE 67
 SURVEY BY R.V. PEARSALE C.E. TRACT NO. _____
 DATE 8/7/72

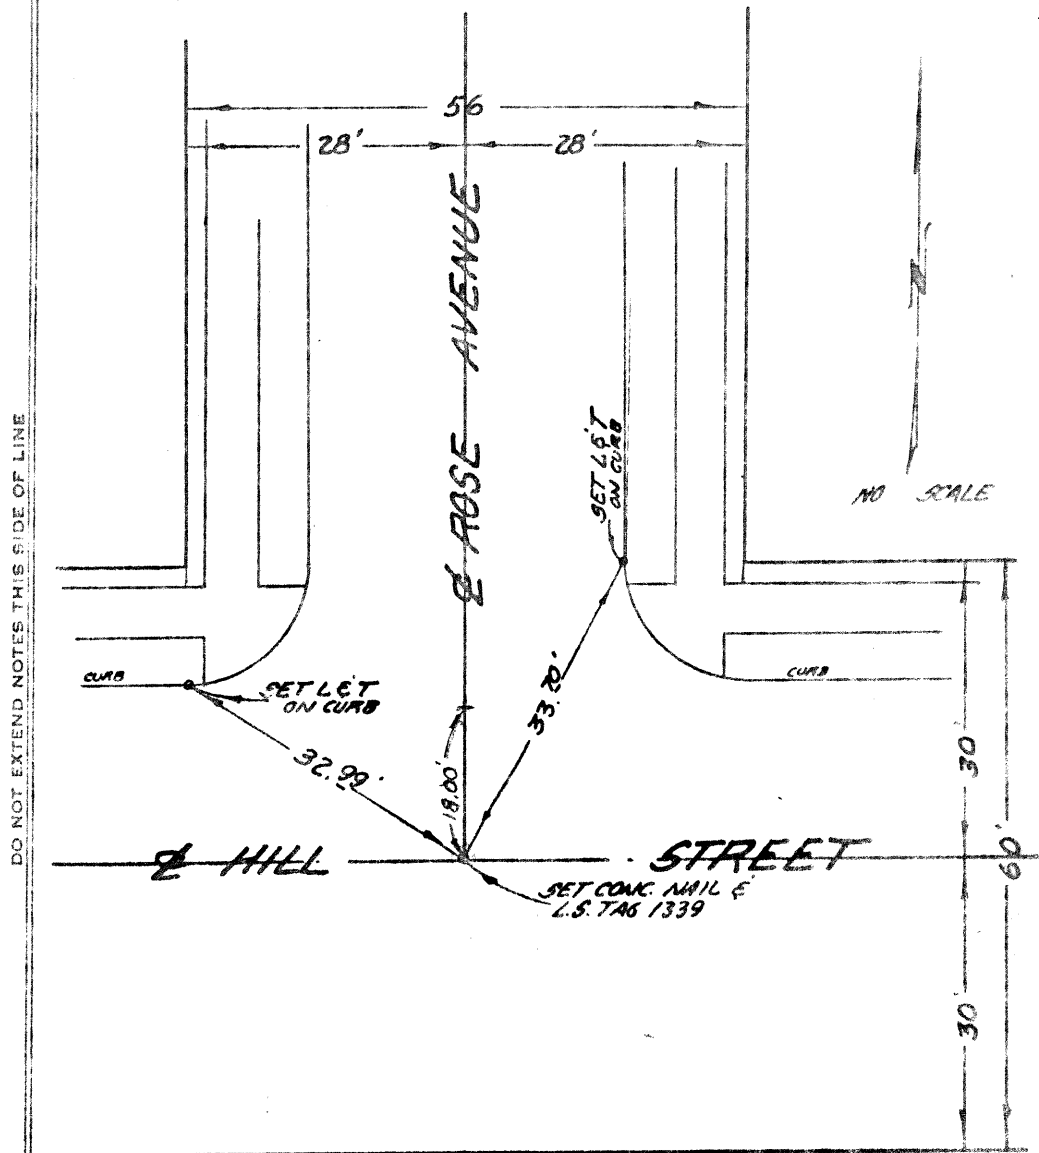

SURVEYORS SERVICE COMPANY - LOS ANGELES - STOCK NO. 411



CITY OF SIGNAL HILL


2175 Cherry Avenue Signal Hill, California 90806 (310) 989-7300 FAX (310) 989-7393/7391


Profile	Notes Red	Plotted	Job No.	Division No.	F. B.	Pg.
No.	Date	Date	Survey of	<u>ETIES AT WALNUT AV & HILL ST</u>		
X-Sec.	Notes Chkd.	Checked	Survey by	<u>RBF</u>	Notes	<u>RBF</u>
No.	Date	Date	Map No.	Indexed	Date	<u>NOV 1983</u>

NOTE: ANY ADDITIONS OR CHANGES ON THIS SHEET MUST BE MADE OR CIRCLED IN RED INK, WITH DATE AND NAME OF PERSON MAKING CHANGE

PLEASE RETURN TO
SIGNAL HILL
ENGINEERING DEPT.
2175 CHERRY AVE.
SIGNAL HILL, CALIFORNIA

Do not extend notes this side of this line.

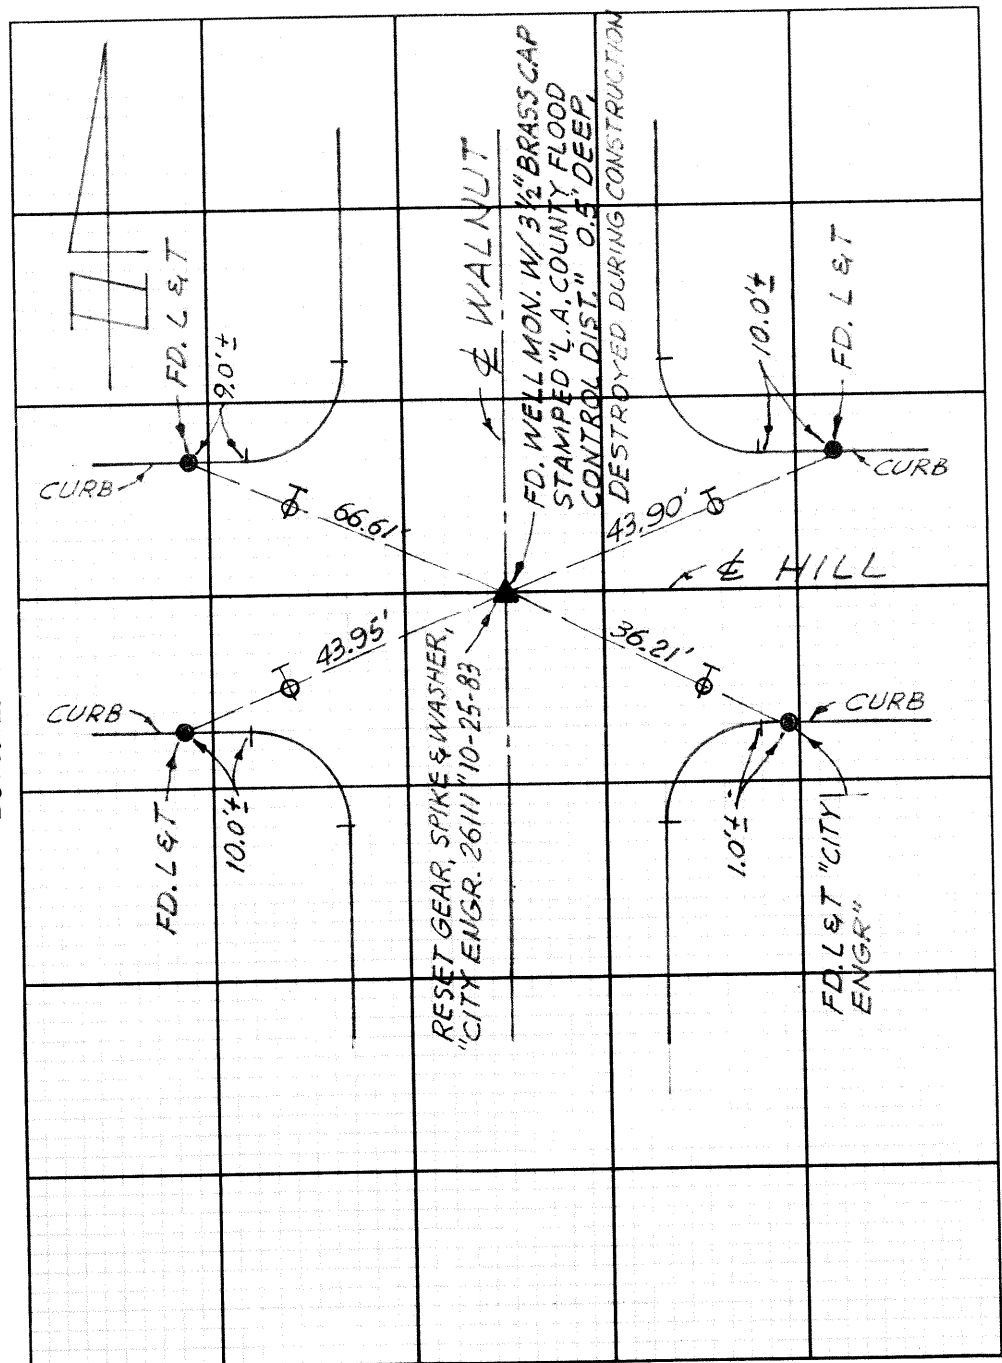

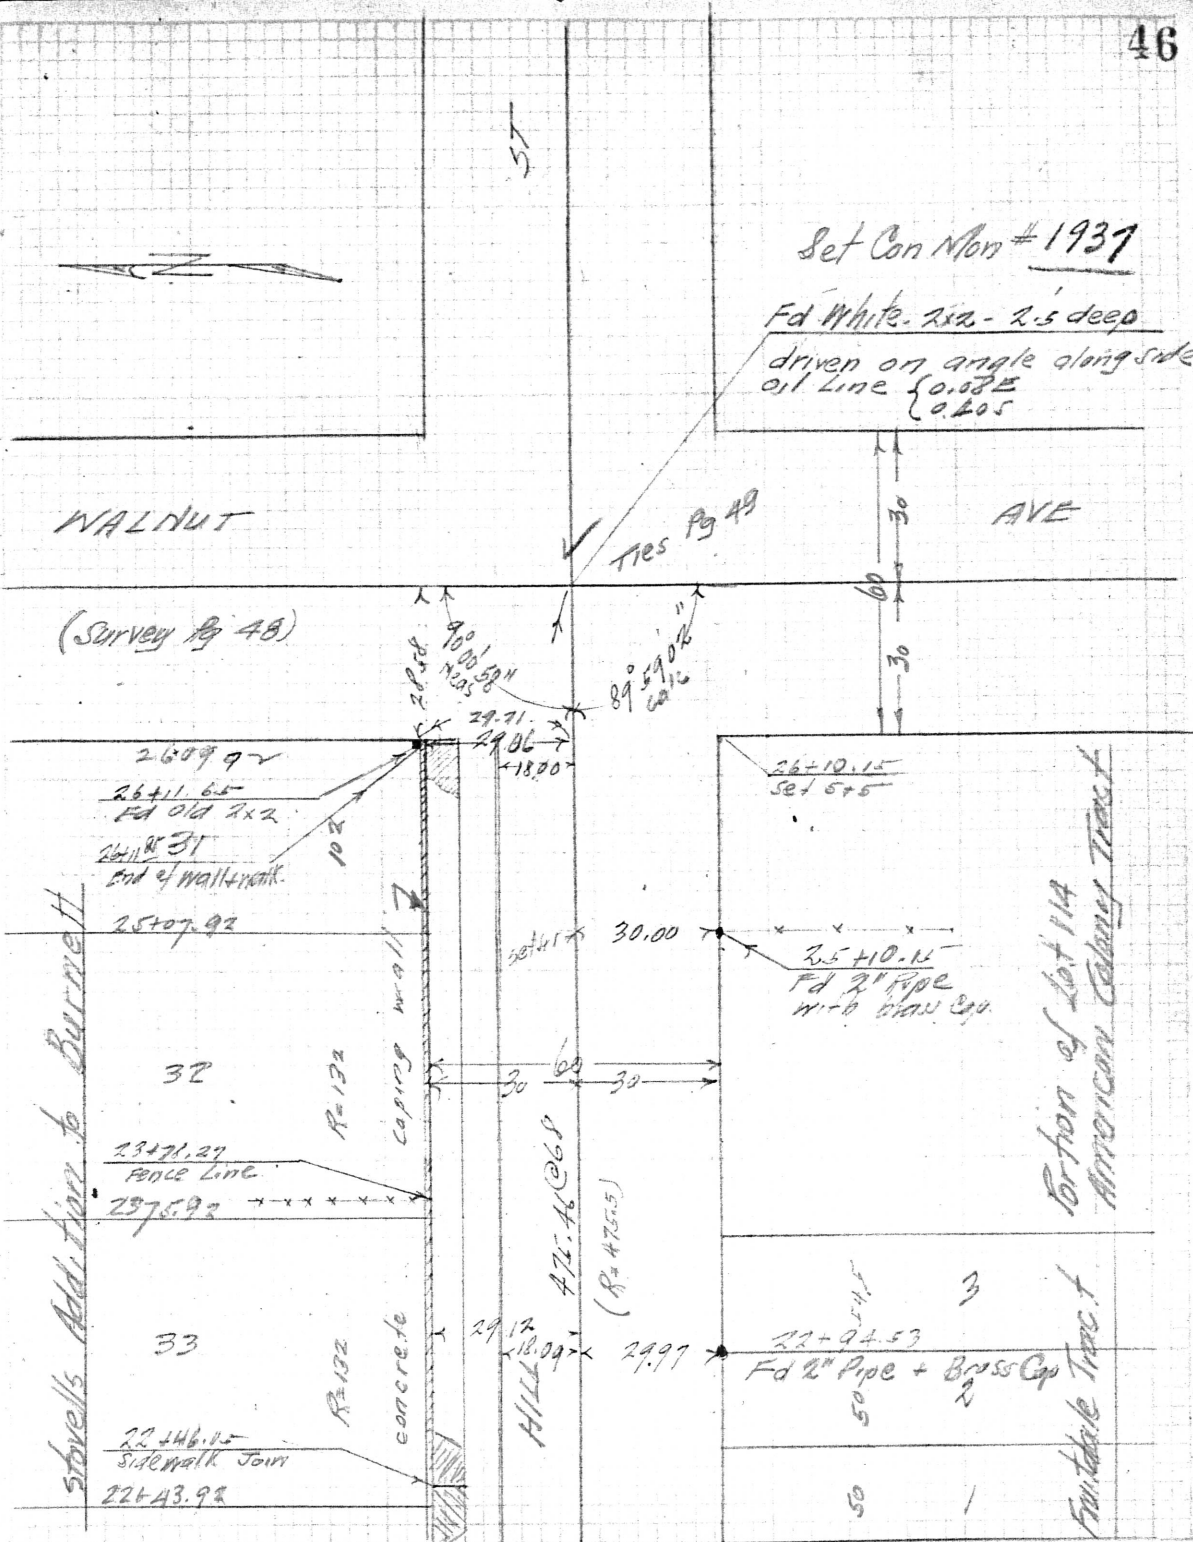



2175 CHERRY AVENUE • SIGNAL HILL, CALIFORNIA 90806 • (213) 426-7333

CITY OF SIGNAL HILL


CENTER OF PROGRESS


Profile	Notes Red	Plotted	Job No.	Division No.	F.B. <u>46</u>	Pg. <u>130</u>
No.	Date	Date	Survey of	<u>California Avenue</u>		
X-Sec.	Notes Chkd.	Checked	Survey by	<u>V. C. 55</u>	Notes	<u>R. W.</u> Date <u>Feb. 1969</u>
No.	Date	Date	Map No.	Indexed	Date	

NOTE: ANY ADDITIONS OR CHANGES ON THIS SHEET MUST BE MADE OR CIRCLED IN RED INK, WITH DATE AND NAME OF PERSON MAKING CHANGE

Do not extend notes this side of this line.

PLEASE RETURN TO
SIGNAL HILL
ENGINEERING DEPT.
2175 CHERRY AVE.
SIGNAL HILL, CALIFORNIA

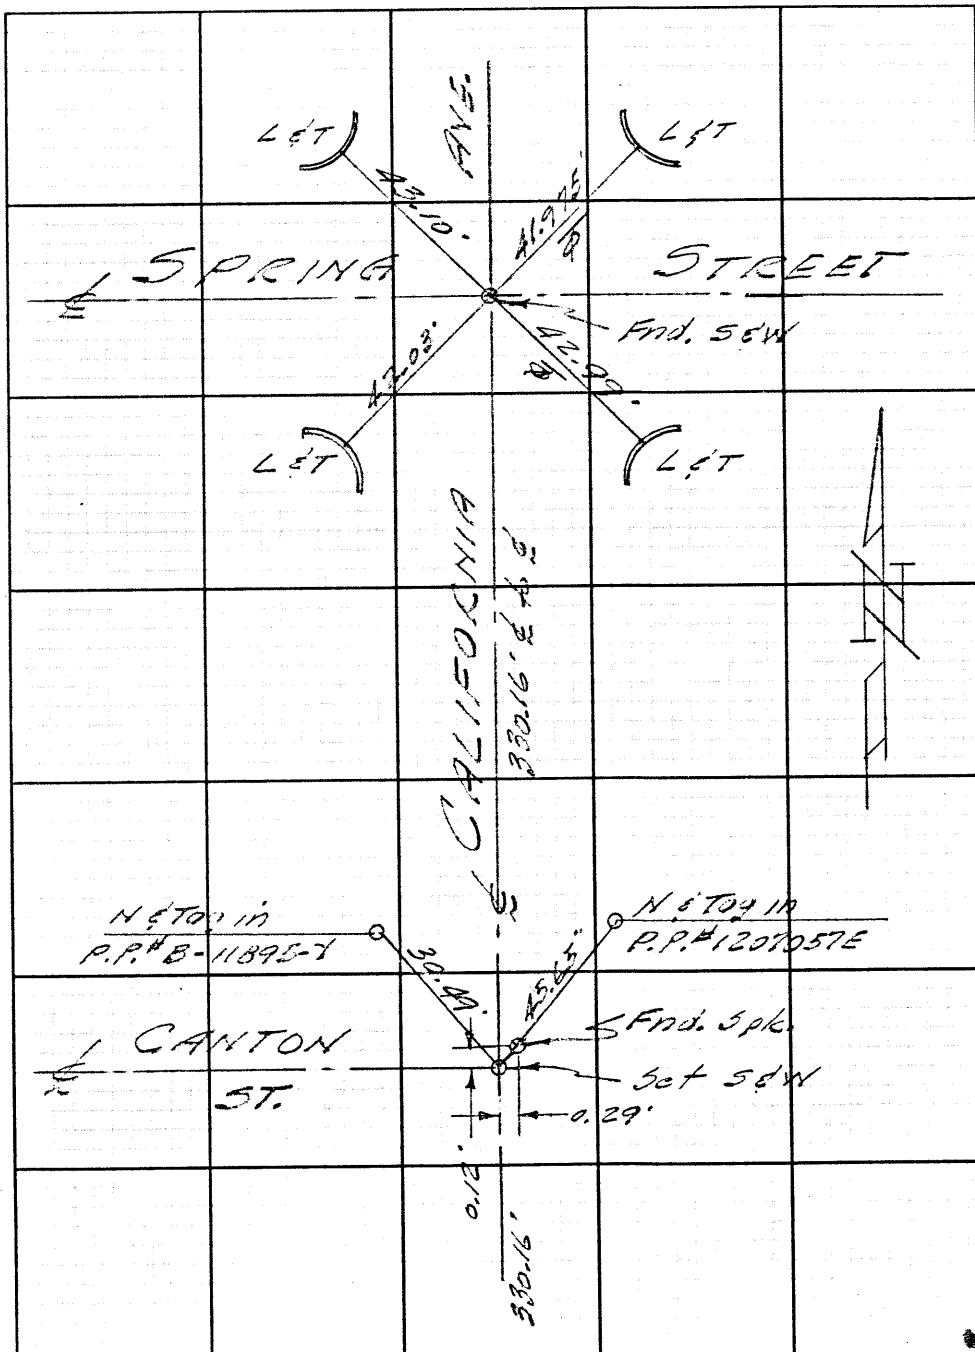

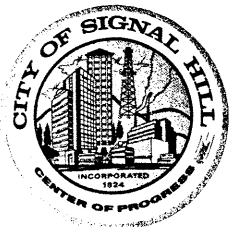


A 41 90
BOOK 2 P-103

2175 CHERRY AVENUE • SIGNAL HILL, CALIFORNIA 90806 • (213) 426-7333

CITY OF SIGNAL HILL


CENTER OF PROGRESS

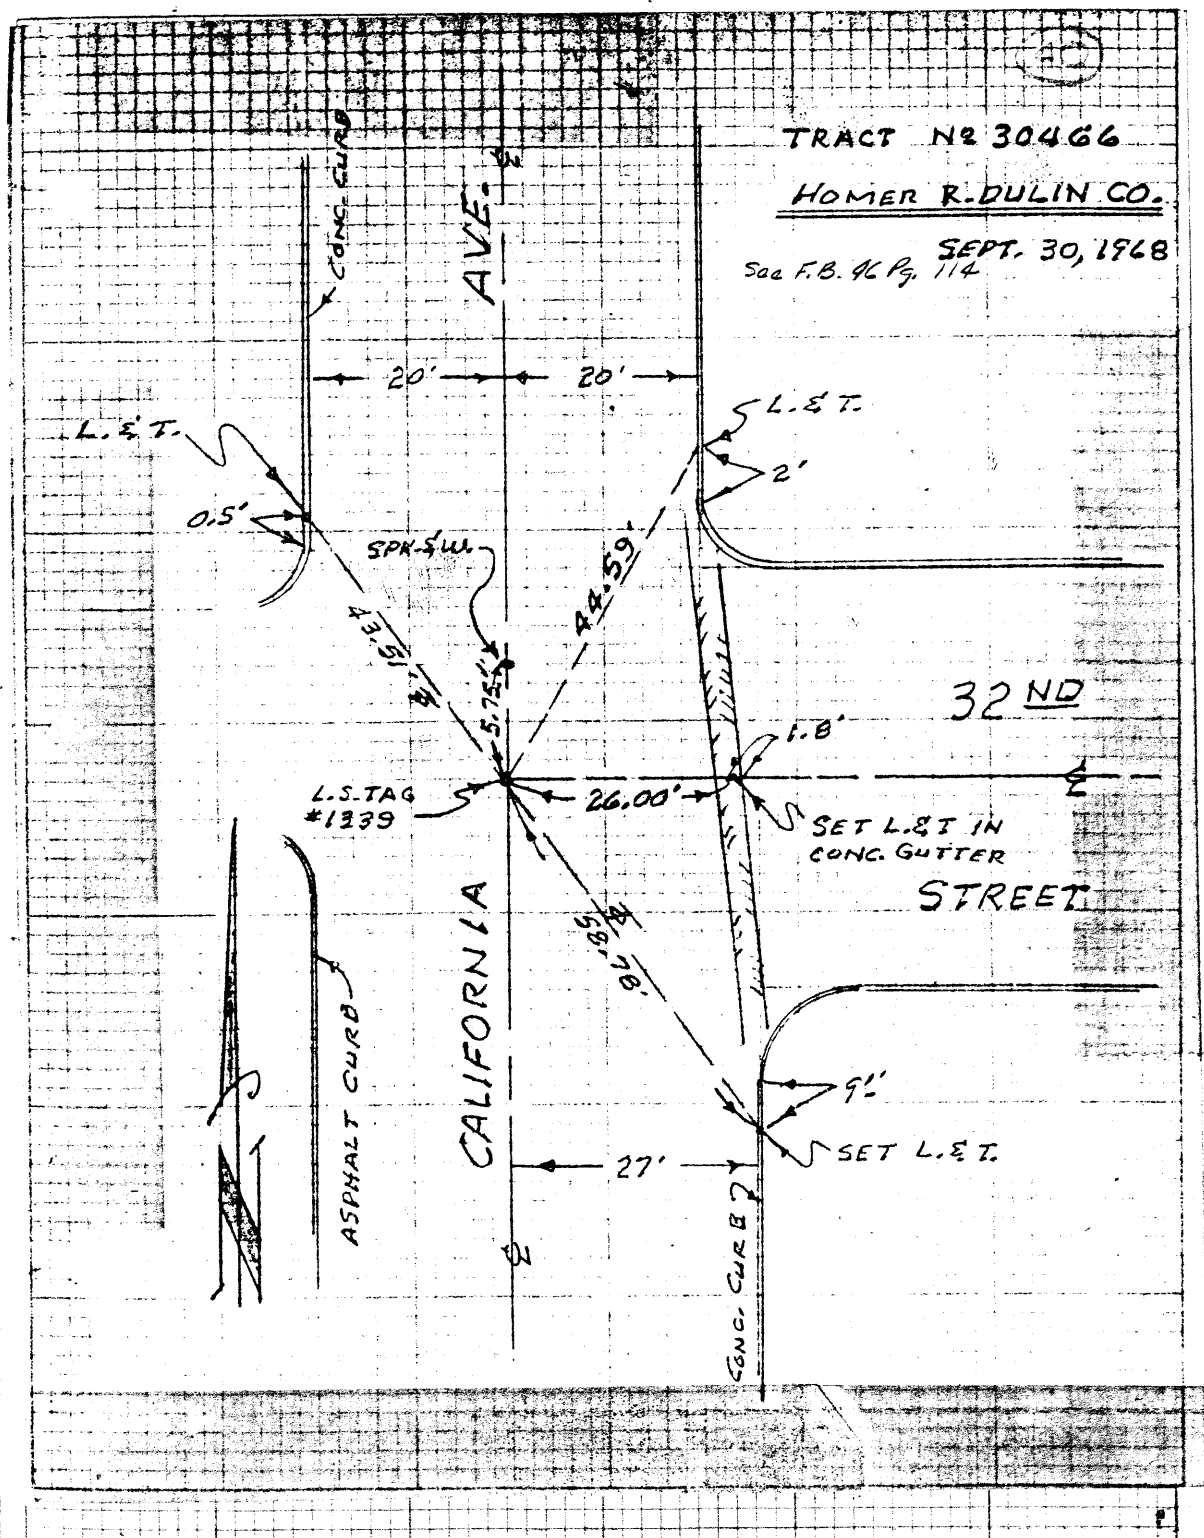



CITY OF SIGNAL HILL


2175 Cherry Avenue Signal Hill, California 90806 (310) 989-7300 FAX (310) 989-7393/7391

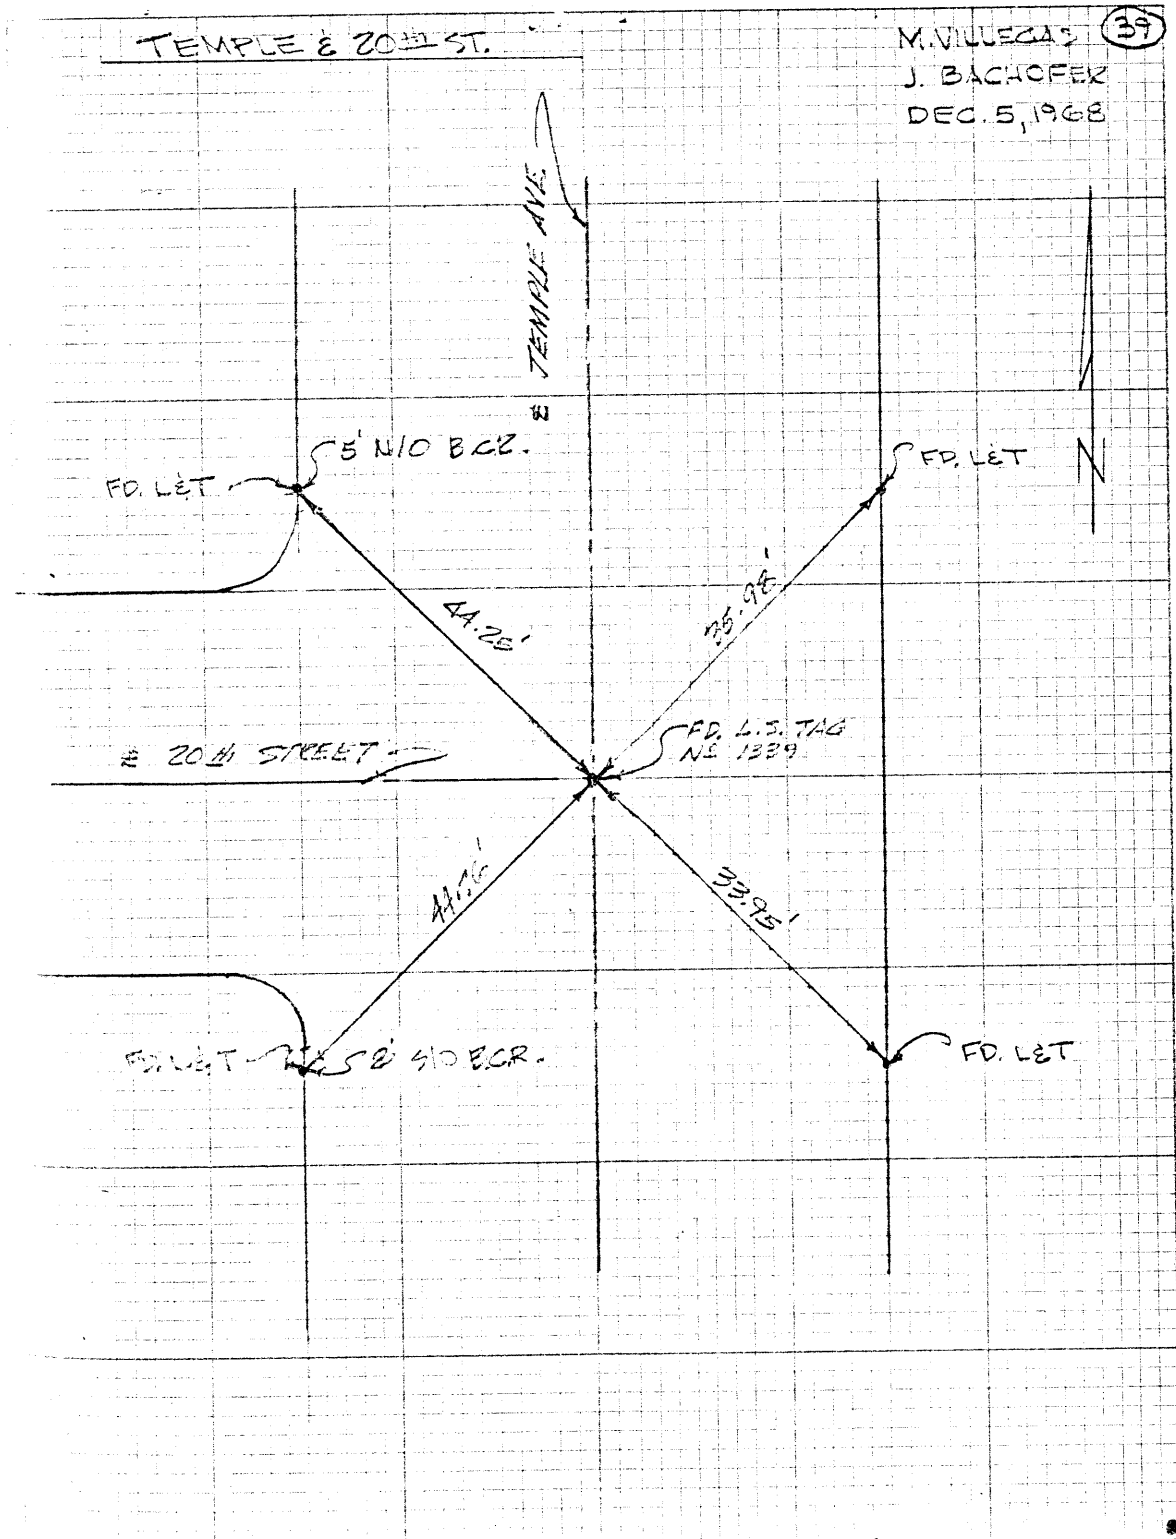

Surveyed by Larry V. Case Date 1/3/94 F.B. _____ Pg. 92
Type of Survey Center Line Ties Sheet _____ of _____
Distances corrected _____ Monuments tagged _____ LS # 5411 Tract or
to 68° _____ RCE # _____ Parcel Map # _____
Checked by _____ Date _____ km grid _____ MB _____

NOTE: Additions or changes must
be initiated, and dated.

Return original to
BUREAU OF ENGINEERING
SURVEY DIVISION, Room 1430
200 N. Main St. — Los Angeles 90012

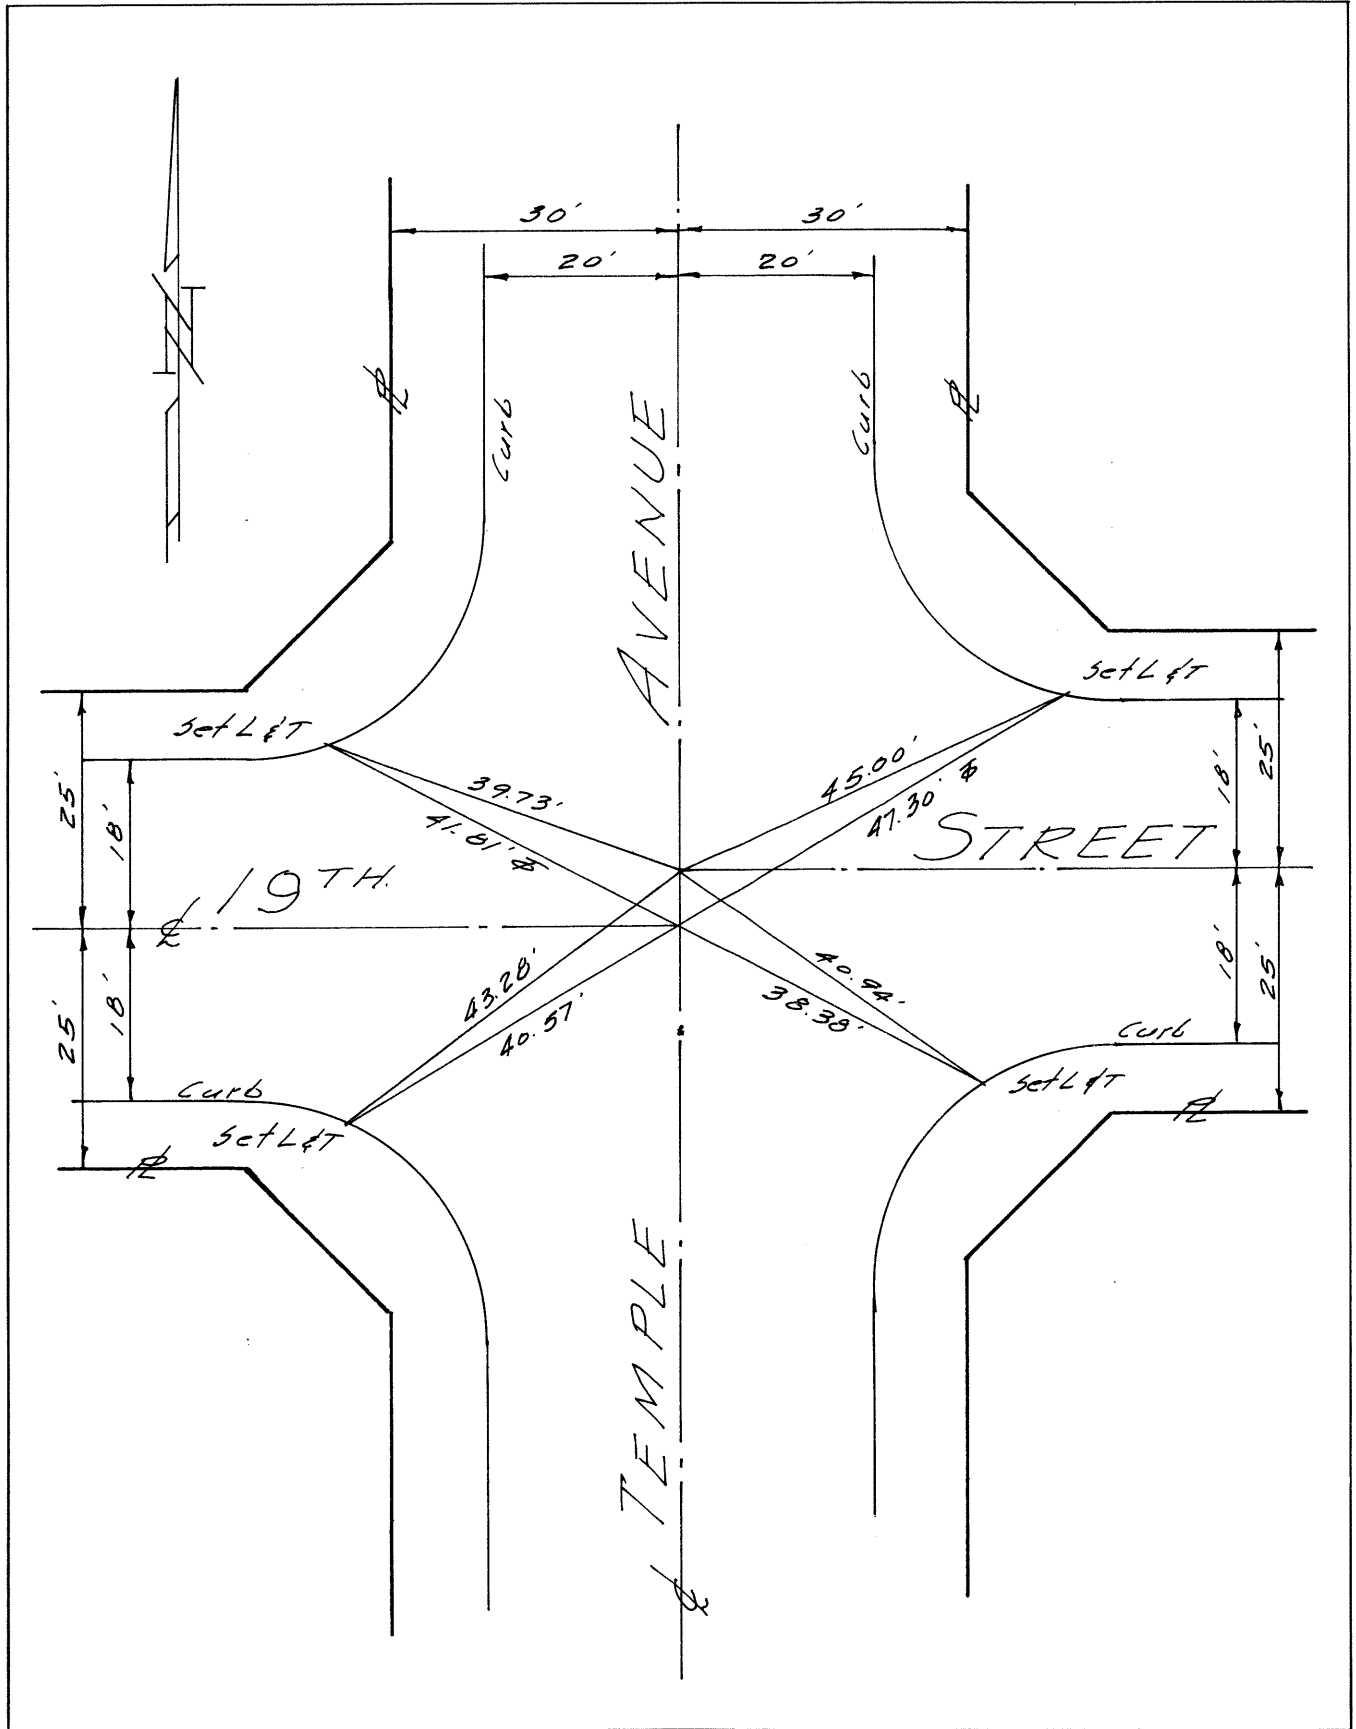



Ground Dist. × Correction Factor: _____ = Grid Distance



CITY OF SIGNAL HILL

2175 Cherry Avenue • Signal Hill, California 90806 • (310) 989-7300 • FAX (310) 989-7393/7391

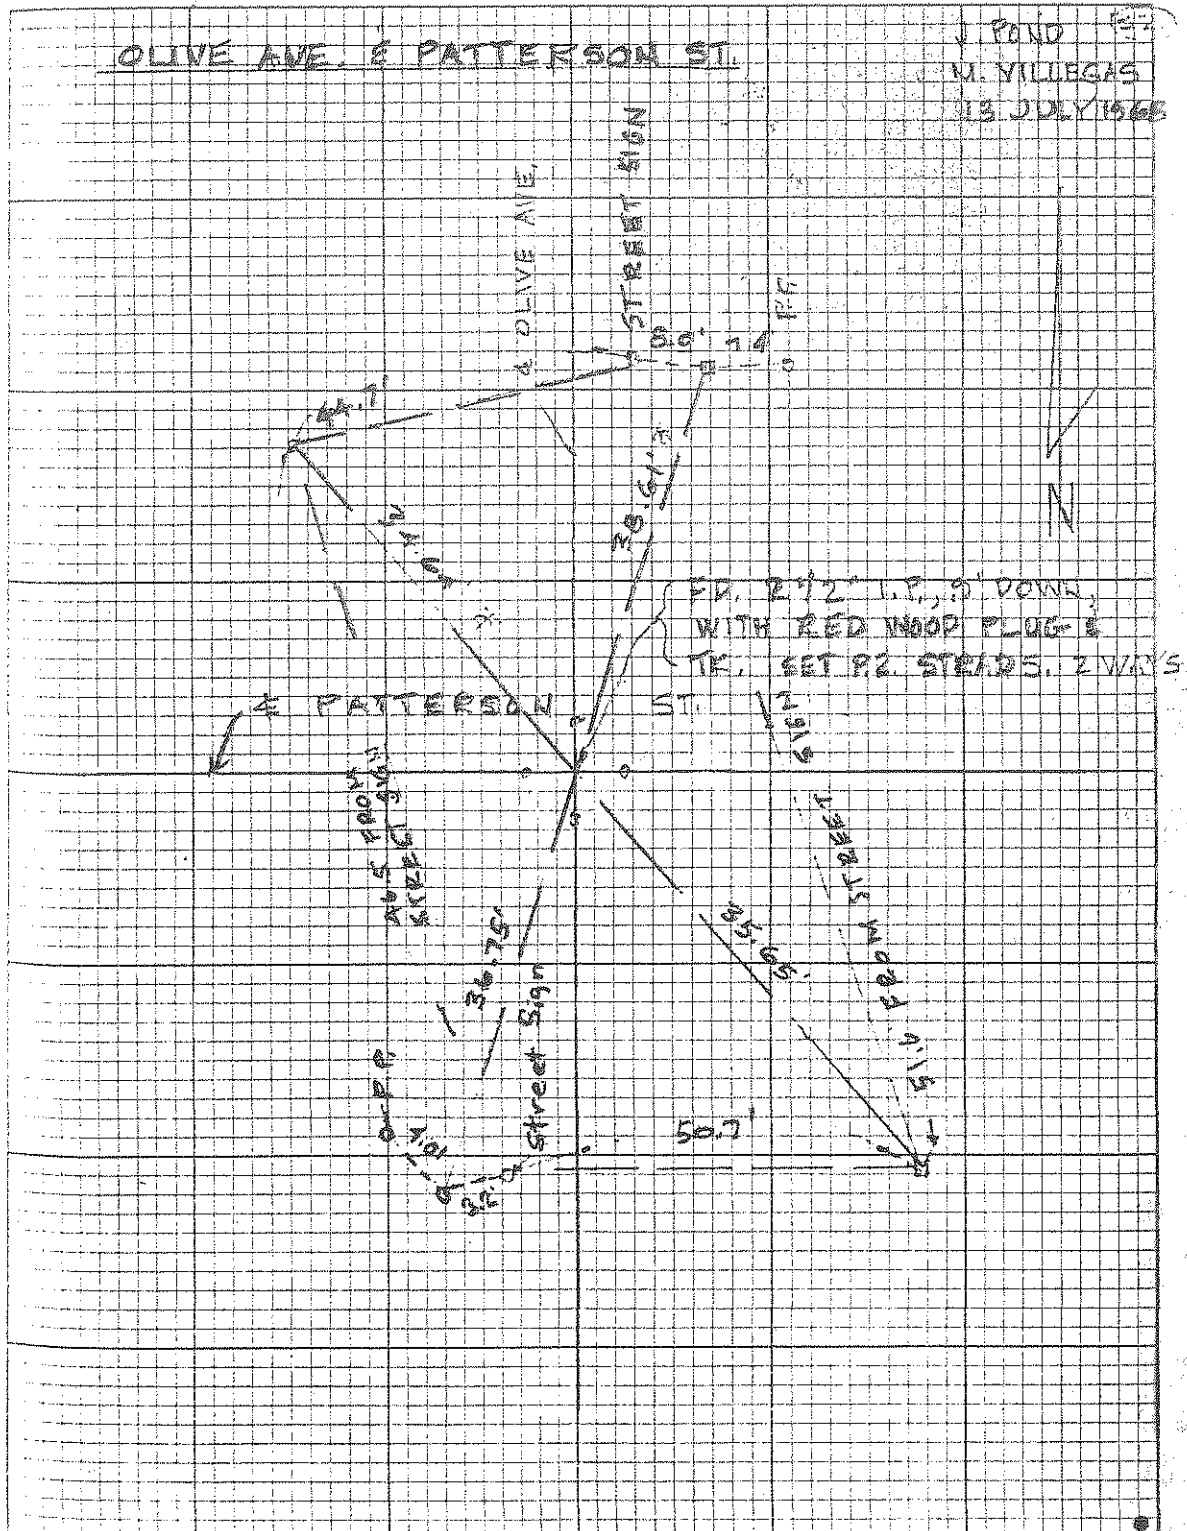

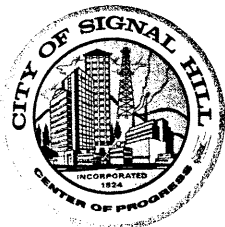

2175 CHERRY AVENUE • SIGNAL HILL, CALIFORNIA 90806 • (213) 426-7333


CITY OF SIGNAL HILL

CENTER OF PROGRESS

A45 # A4694
BOOK 2 P-163

Plotted _____ Job No. _____ Division No. P.B. 46 Pg. 128
Date _____ Survey of California Avenue
Checked _____ Survey by V. Guse Notes R.V.H. Date Feb. 1969
Date _____ Map No. _____ Indexed _____ Date _____

(51)

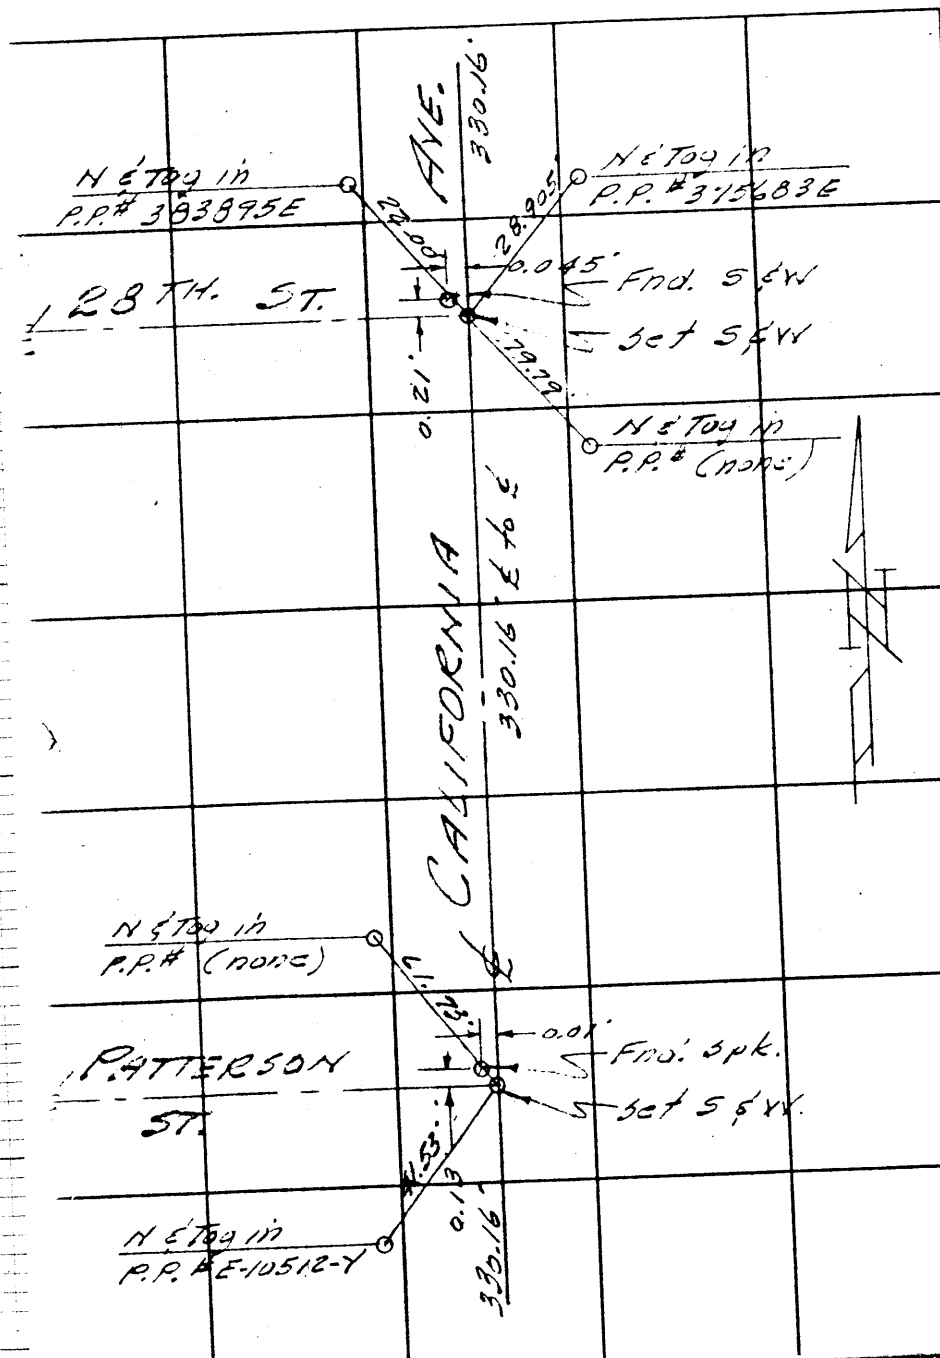



2175 CHERRY AVENUE • SIGNAL HILL, CALIFORNIA 90806 • (213) 426-7333

CITY OF SIGNAL HILL

CENTER OF PROGRESS


A47448
B2 P-280
95 ~~EE~~

Profile	Notes Red.	Plotted	Job No.	Division No.	F.B. 46	Pg. 129
No.	Date	Date	Survey of	California Avenue		
X-Sec.	Notes Chkd.	Checked	Survey by	V. G. S.	Notes	R. H. Date Feb. 1969
No.	Date	Date	Map No.	Indexed	Date	

NOTE: ANY ADDITIONS OR CHANGES
ON THIS SHEET MUST BE MADE OR
CIRCLED IN RED INK, WITH DATE AND
NAME OF PERSON MAKING CHANGE

Do not extend notes this side of this line.

PLEASE RETURN TO
SIGNAL HILL
ENGINEERING DEPT.
2175 CHERRY AVE.
SIGNAL HILL, CALIFORNIA

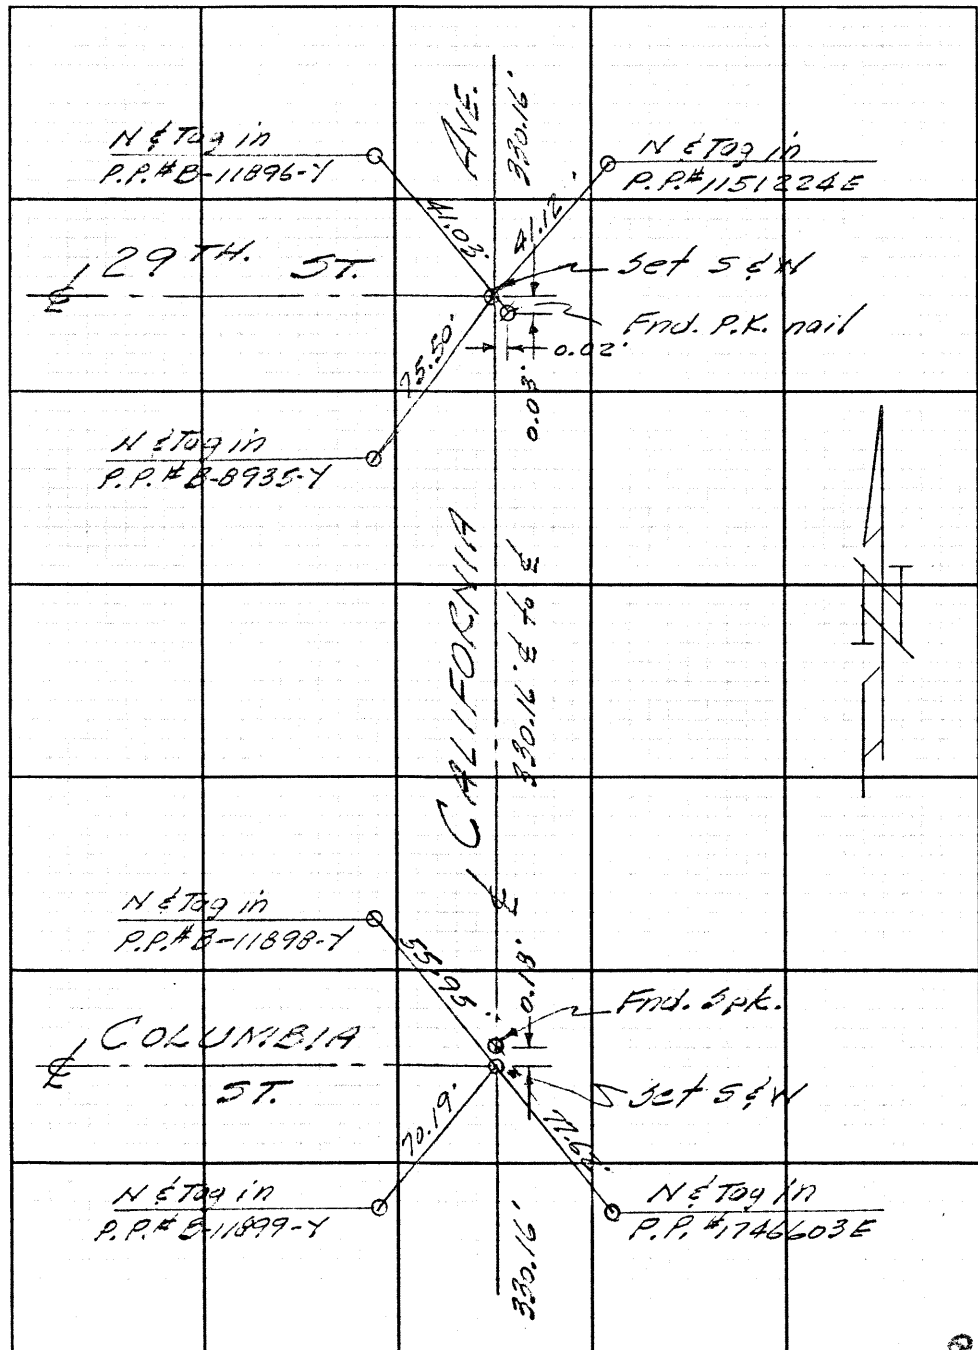



2175 CHERRY AVENUE • SIGNAL HILL, CALIFORNIA 90806 • (213) 426-7333

CITY OF SIGNAL HILL

CENTER OF PROGRESS

96

REFERENCES SEE BKC-300 PG. 28L
C.L.B.

(54)
M. VILLEGAS
5-16-69

SET BY C.L.B.
SEIN IN P.P.#
93264E

27th

ST.

TO & ATLANTIC 330.73'

300.75' TO & OLIVE
E

32.17'

38.32'

42.36'

LYME AVE.

329.66' TO & NALTON

2 FD. LET
4+94.65 M.
#11-20 H.
DULIN PA
6-14-57
2367

NALTON AVE.


SURVEY OF 28TH & JUNIPERO
 SURVEY BY GEORGE D. STRINGER
 DATE 8-17-73 R.C.E. 9645

F B NO. PAGE

TRACT NO.

SURVEYOR'S SERVICE COMPANY, COSTA MESA - STOCK NO. 414

DO NOT ENTERED NOTES THIS SET OF LINE

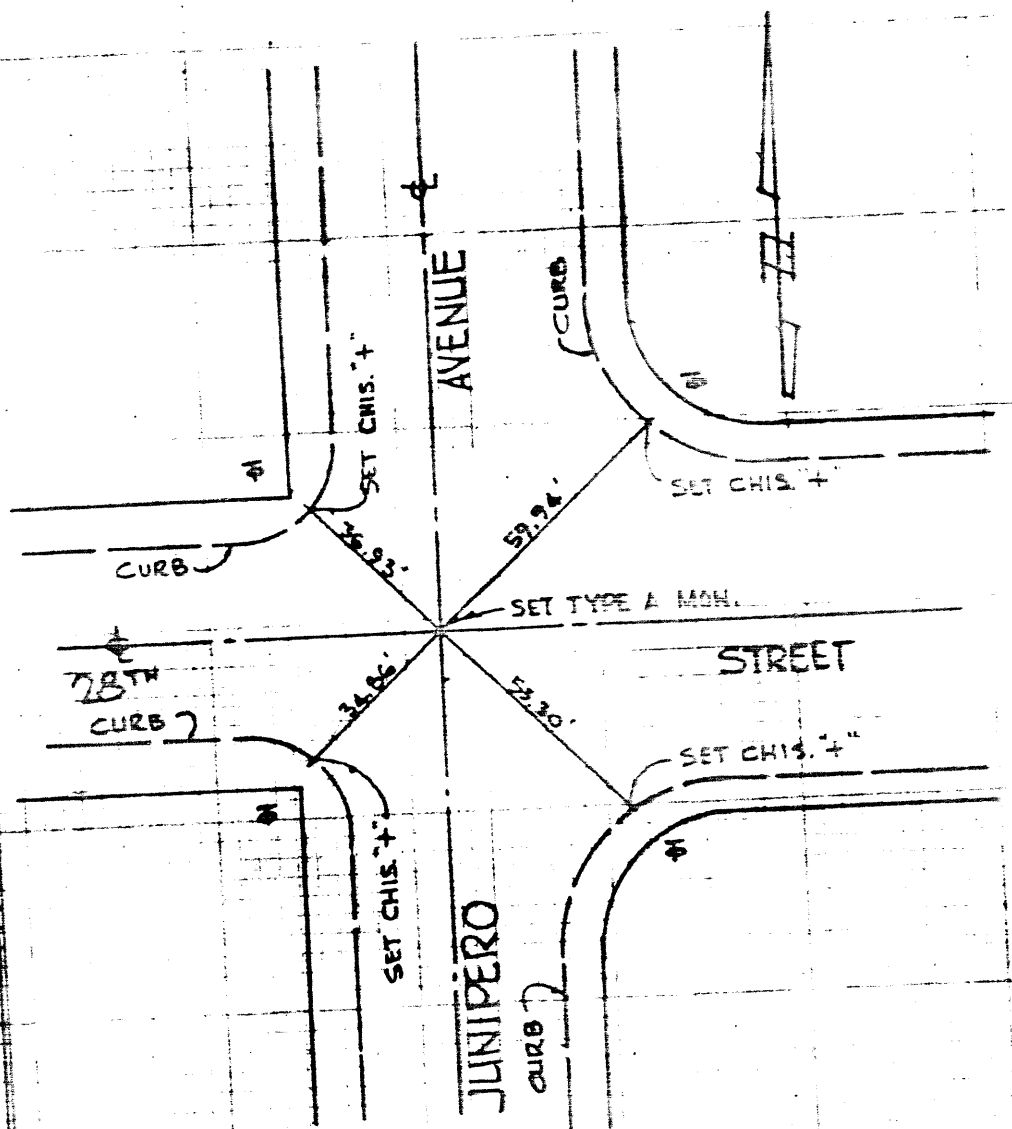


2175 Cherry Avenue Signal Hill, California 90806 (310) 989-7300 FAX (310) 989-7393/7391

Profile _____ Notes Red _____ Plotted _____ Job No. 64-5-00 Division No. F. B. 43 Pg. 105
 No. _____ Date _____ Date _____ Survey of 20th St. - Alameda - Walnut & Ties
 X-Sec. _____ Notes Chkd. _____ Checked _____ Survey by V. Case Notes _____ Date 2-66
 No. _____ Date _____ Date _____ Map No. _____ Indexed _____ Date _____

NOTE: ANY ADDITIONS OR CHANGES ON THIS SHEET MUST BE MADE OR CIRCLED IN RED INK, WITH DATE AND NAME OF PERSON MAKING CHANGE

PLEASE RETURN TO
SIGNAL HILL
ENGINEERING DEPT.
2175 CHERRY AVE.
SIGNAL HILL, CALIFORNIA

Do not extend notes this side of this line.

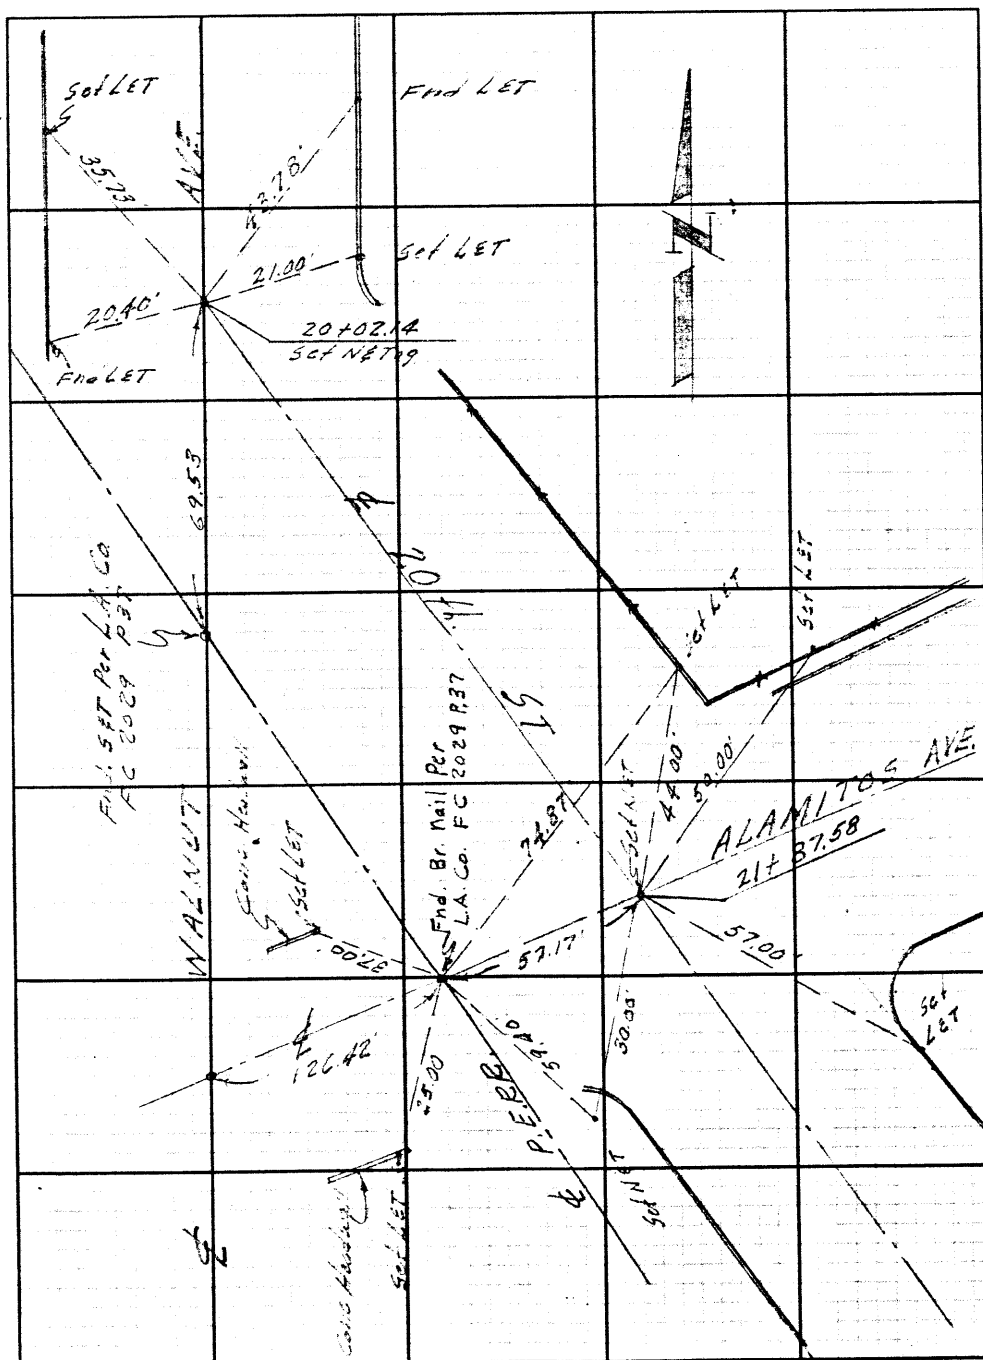



CITY OF SIGNAL HILL

2175 Cherry Avenue Signal Hill, California 90806 (310) 989-7300 FAX (310) 989-7393/7391


SURVEY OF GAVIOTA AVE & HILL ST F B NO. _____ PAGE _____
 SURVEY BY R.V. PEARSALL INC TRACT NO. 37236
 DATE AUG. 11, 1980

NO SCALE

L.S. 2488

SURVEYORS SERVICE COMPANY STA MESA - STOCK NO. 411

DO NOT EXTEND NOTES THIS SIDE OF LINE

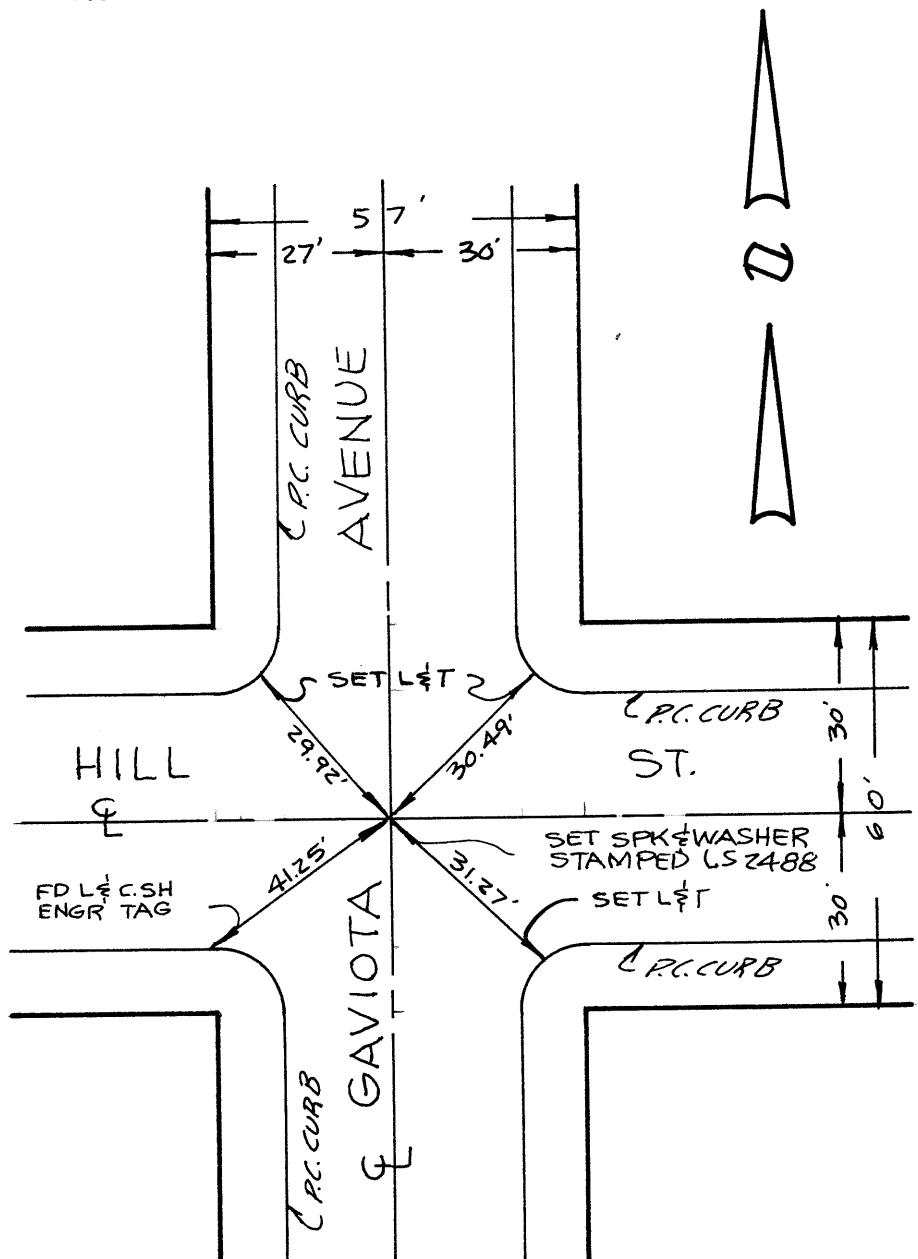



CITY OF SIGNAL HILL

2175 Cherry Avenue Signal Hill, California 90806 (310) 989-7300 FAX (310) 989-7393/7391

SURVEY OF HILL ST. & OHIO AVE F B NO. _____ PAGE _____
 R.V. PEARSALL INC. PER C.S.H.
 SURVEY BY SURVEY MARKED PLOTHILL TRACT NO. "PLOTHILL" SURVEY
 DATE APRIL 5, 1981

NO SCALE

SURVEYORS SERVICE COMPANY. 3TA MESA - STOCK NO. 411

DO NOT EXTEND NOTES THIS SIDE OF LINE

